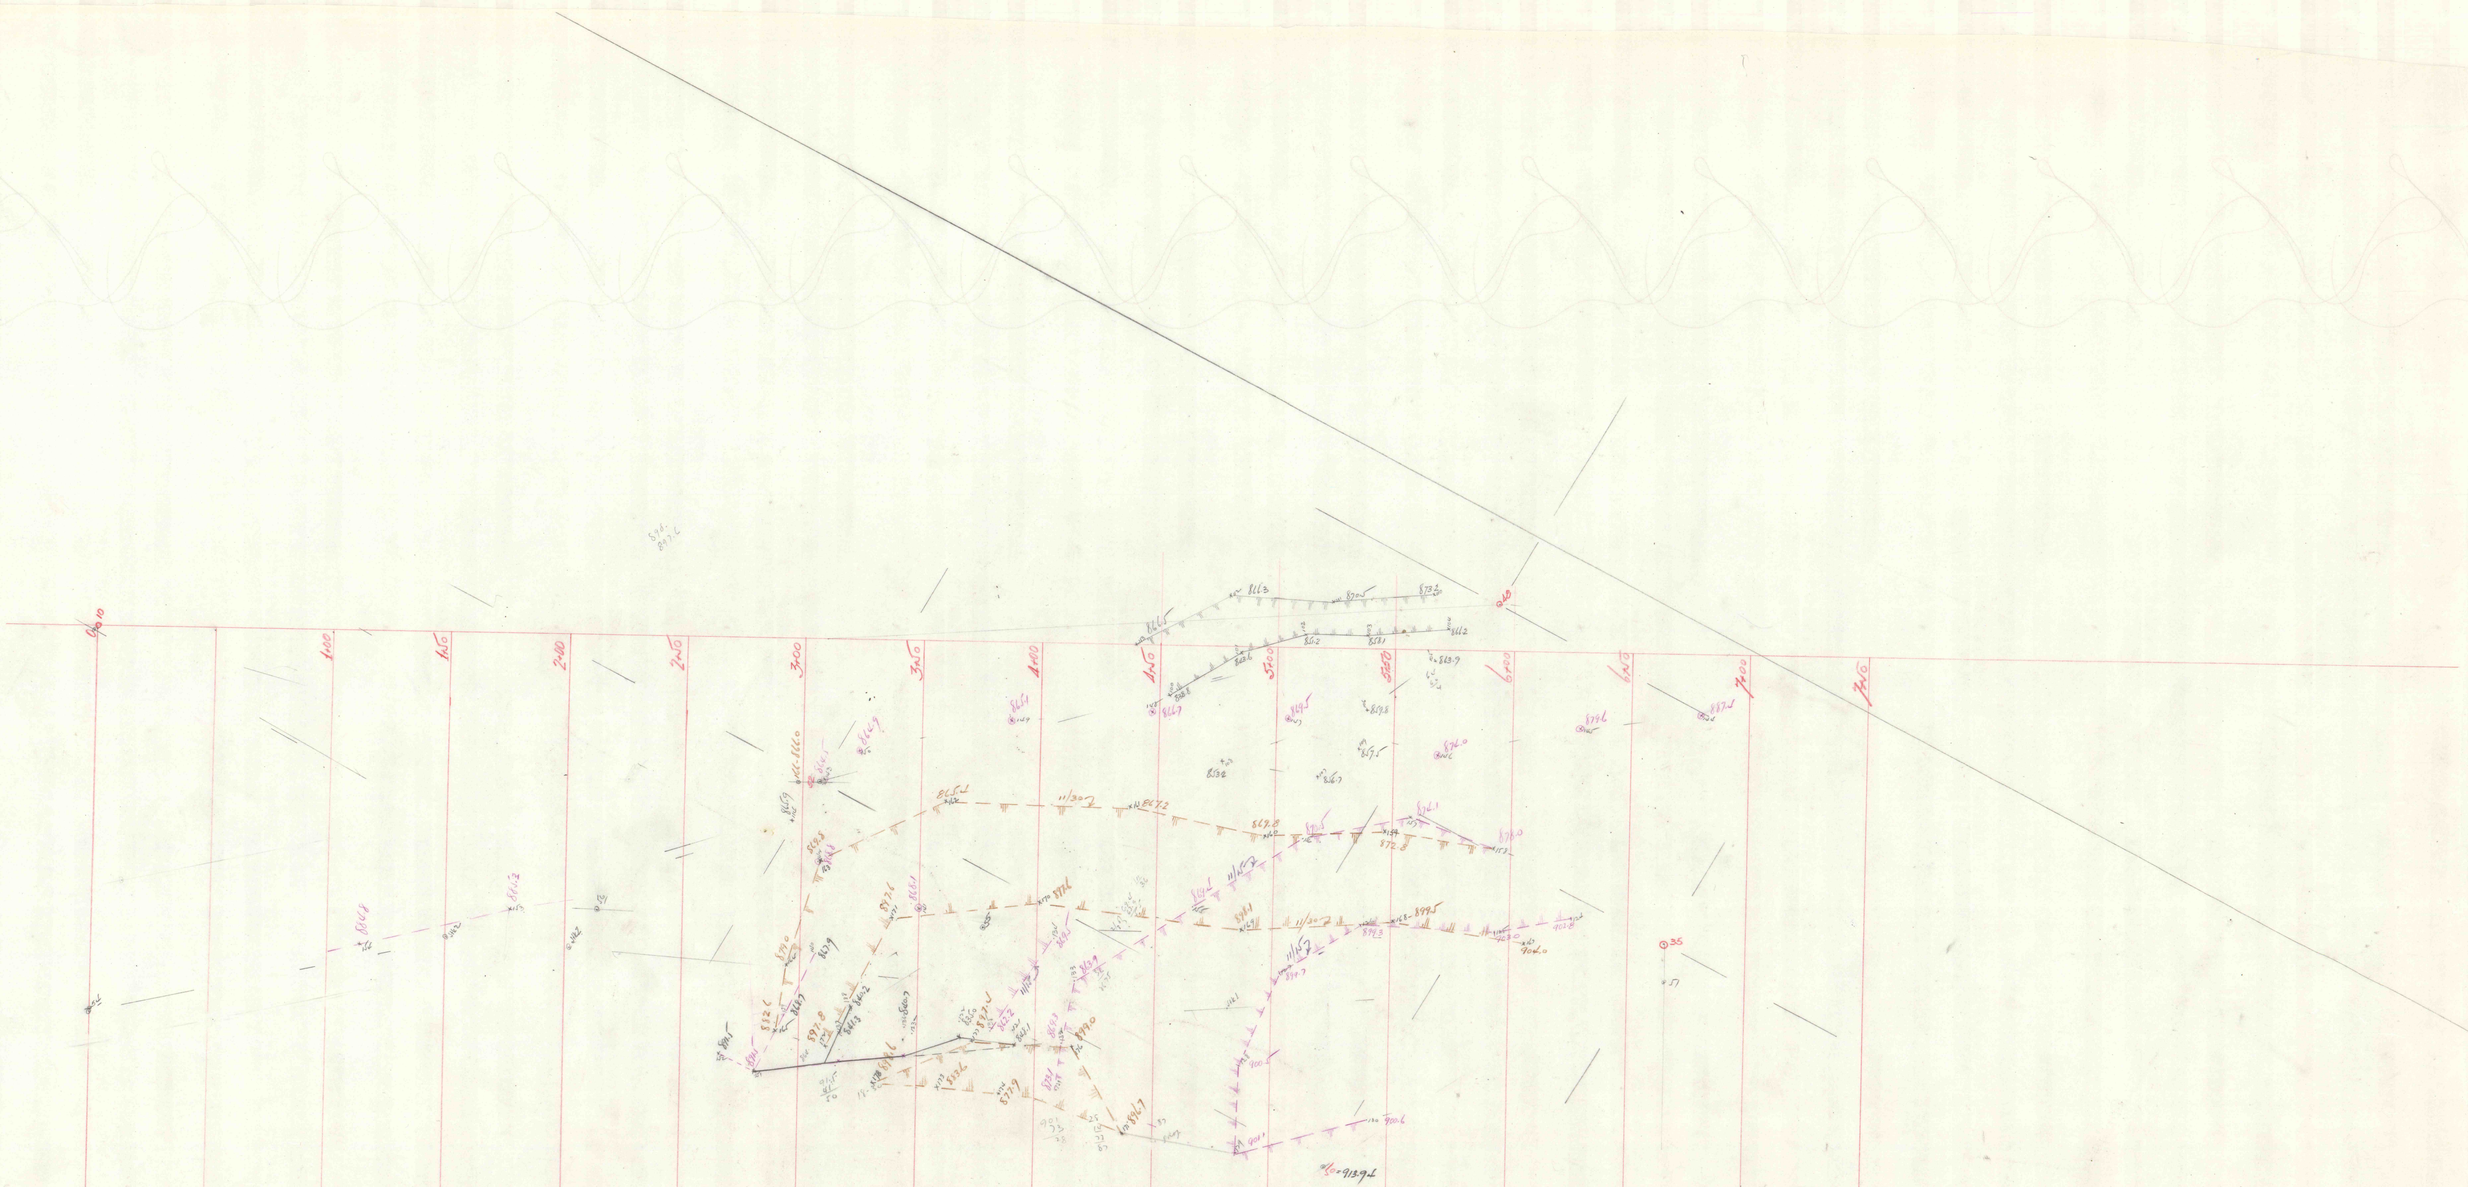

BURNSIDE PROJECT N° AS 33

ESTIMATE N° 12 & 13

SURVEYED NOV. 16. 1964

VOL 2 PG 1