


21-2
120'

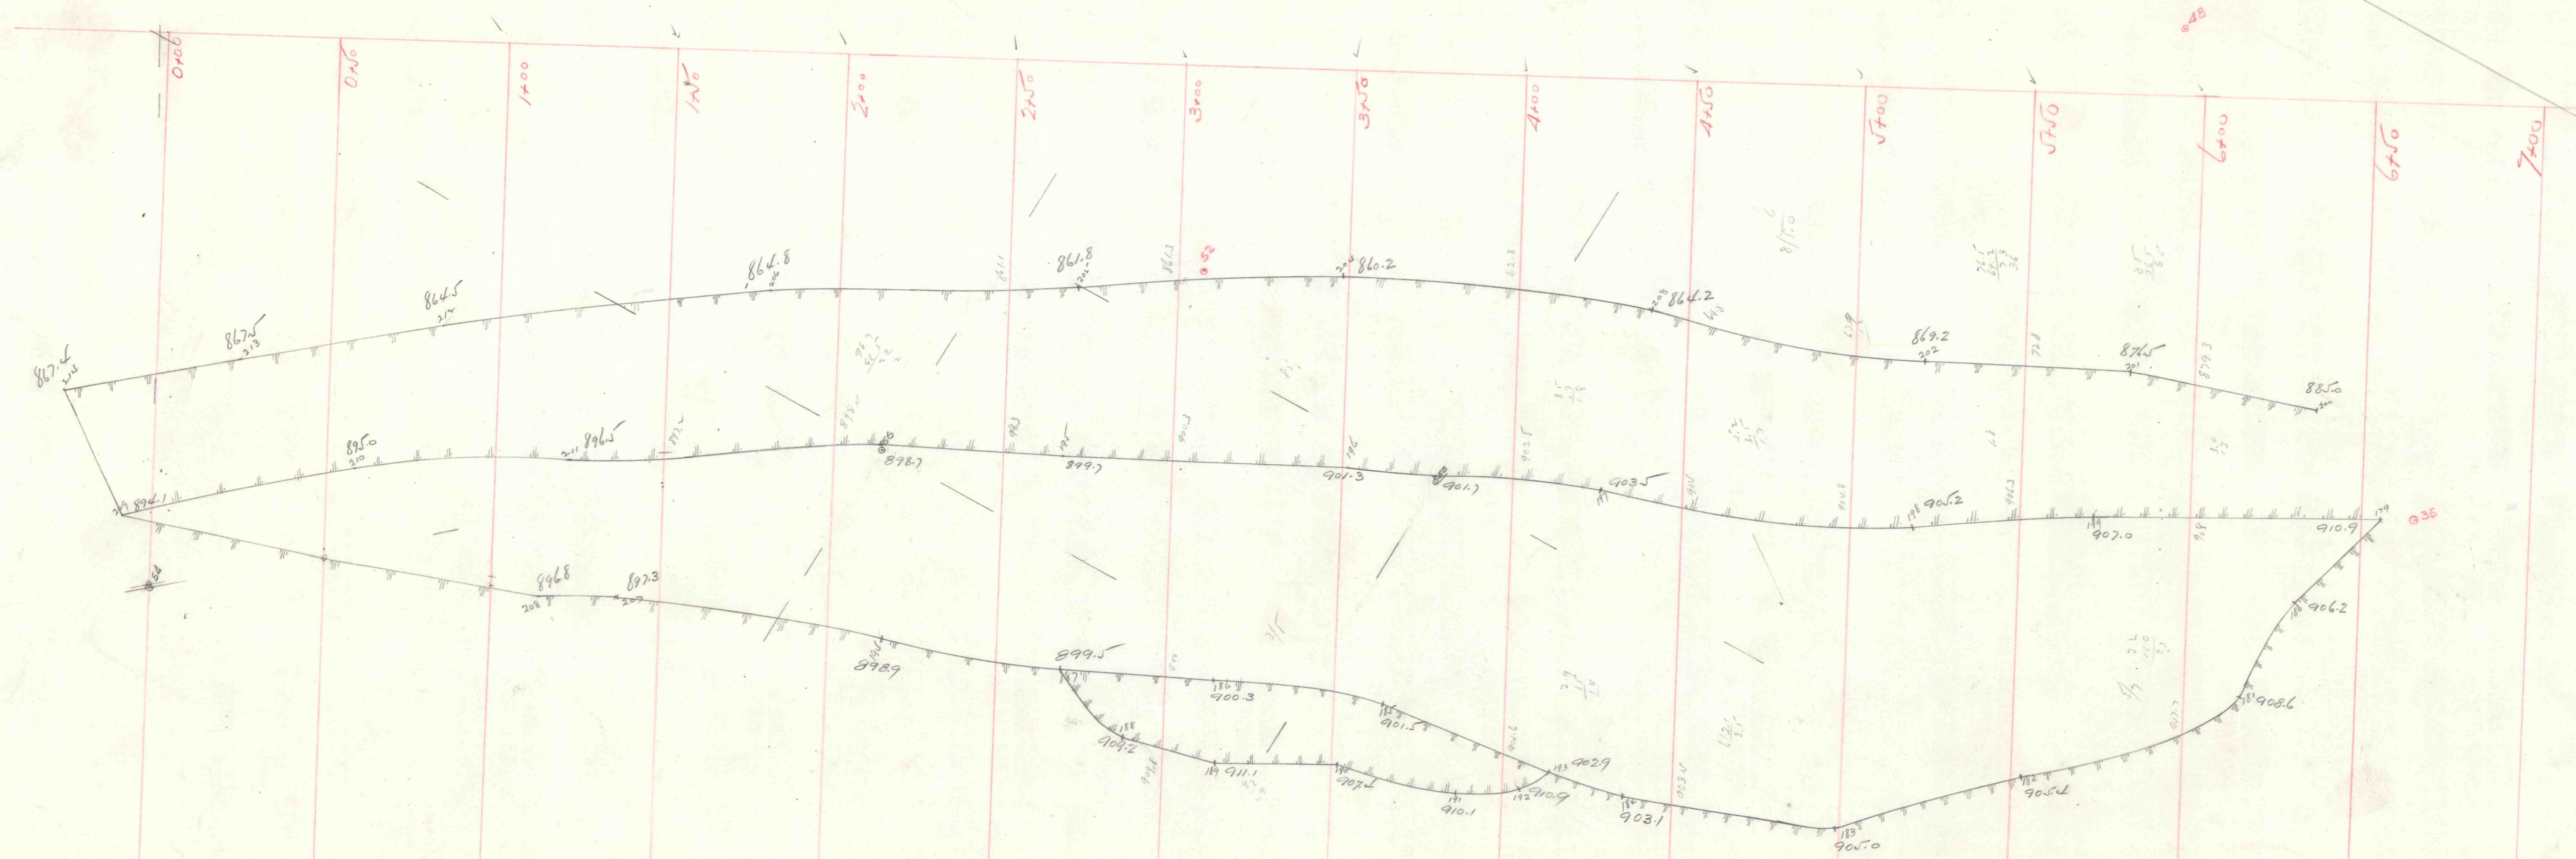

BURNSIDE PROJECT N° AS-33
FINAL ESTIMATE N° 14
SURVEYED DEC. 14, 1964
VOL 2 PAGE 9