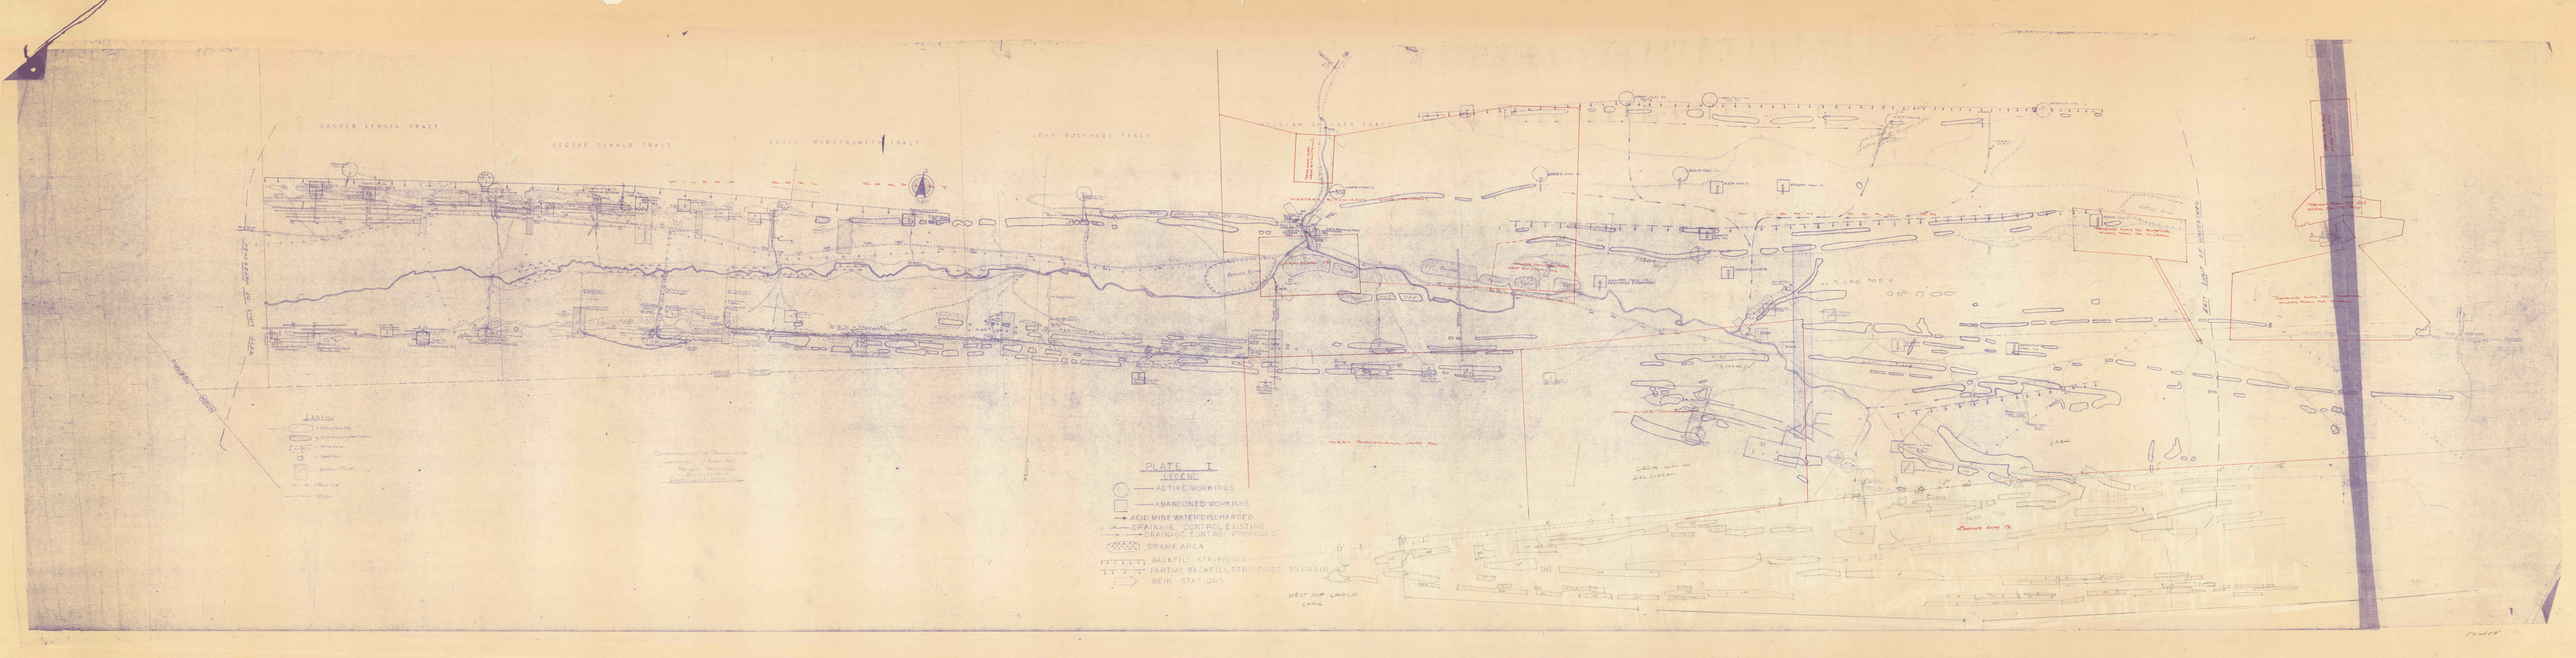
CASPER LENGEL TRACT
GEORGE DEWALD TRACT
DANIEL MEDERSMITH TRACT
JOHN BURKHART TRACT
WILLIAM SKINNER TRACT
PLATE I
LEGEND
ACTIVE WORKINGS
ABANDONED WORKINGS
ACID MINE WATER DISCHARGE
DRAINAGE CONTROL EXISTING
DRAINAGE CONTROL PROPOSED
SWAMP AREA
BACKFILL STRIPPINGS
PARTIAL BACKFILL STRIPPINGS TO DRAIN
WEIR STATIONS