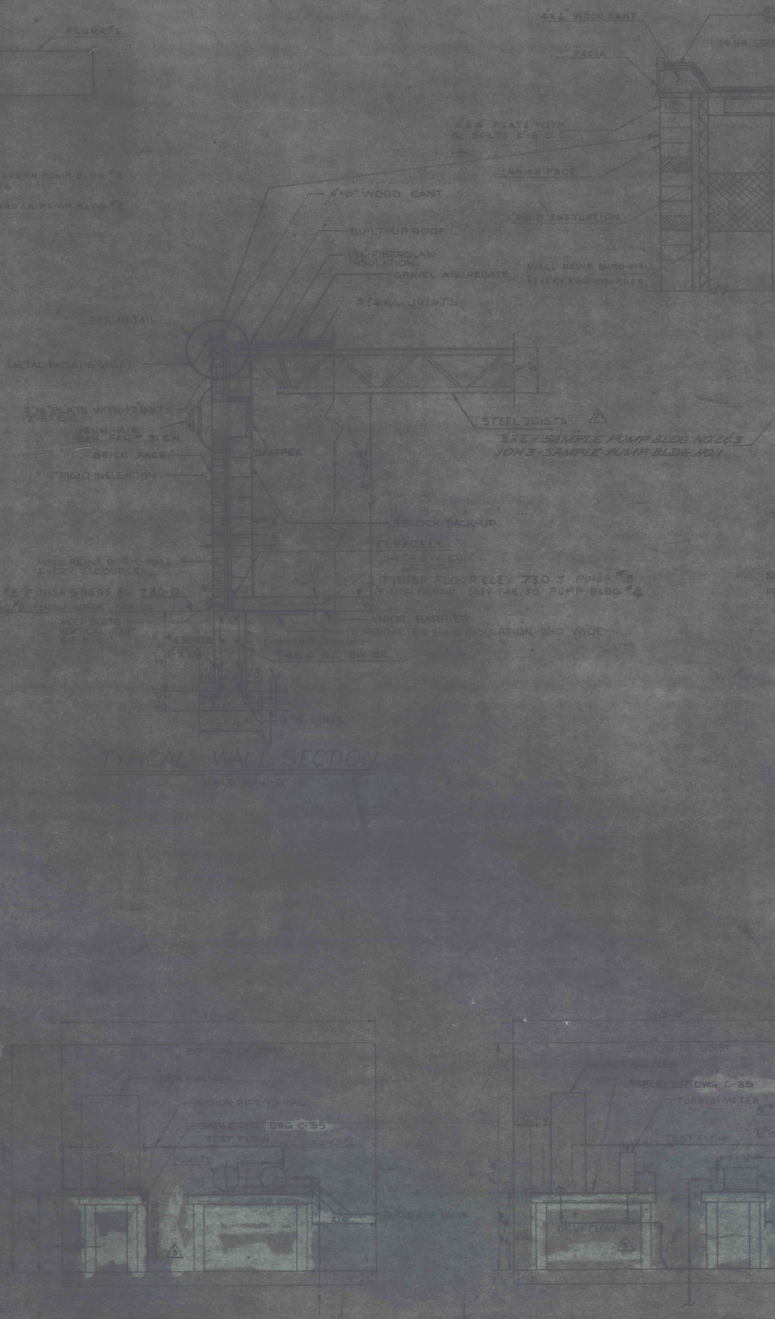

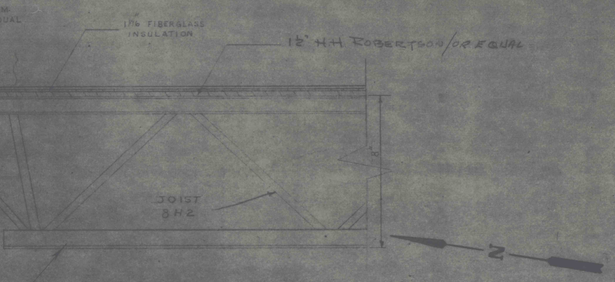

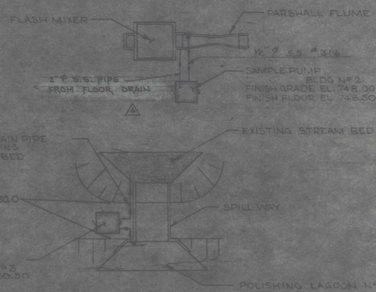

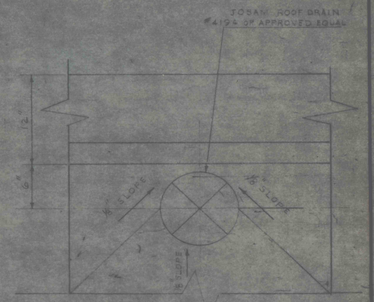

GENERAL NOTES:

1. ALL PIPING TO BE SCHEDULE 40 UNLESS OTHERWISE SPECIFIED.
2. ALL PIPE FOR BUILDING NO 2 TO BE STAINLESS STEEL #316
3. ANCHOR ALL PIPES TO WALLS W/ APPROVED ANCHORS.
4. SUBSOIL MUST BE UNIFORMLY WELL COMPACTED AS A BASE FOR CONCRETE SLABS. SUBGRADE FOR CONCRETE SLABS ON GRADE MUST BE APPROVED BEFORE CONCRETE IS POURED.
5. DRAIN TO BE SET TO SUIT DRAINAGE AREA.
6. ALL PIPES ENTERING / LEAVING BUILDING MUST BE SLEEVED.
7. ALL PUMPS & EQUIPMENT TO BE BOLTED TO TABLES.
8. ALL PIPING & FITTINGS TO PUMPS IN SAMPLE PUMP BLDG #2 SHALL BE #316 STAINLESS STEEL.
9. ALL PIPING & FITTINGS TO PUMPS IN SAMPLE PUMP BLDG #2 SHALL BE SCHEDULE 40.

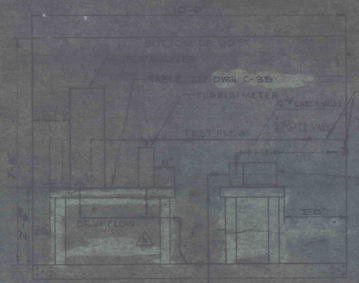

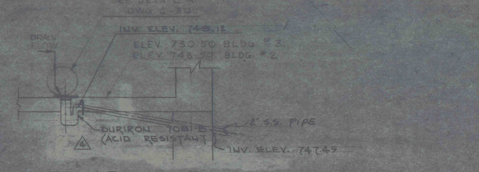

4	3-16-71	Rev. FLOOR DRAIN - AS INDICATED	(F.D.'s)
3	2-25-71	Rev. TABLES AS IND.	(F.D.'s)
2	11-17-70	REV. FLR. DRAIN AS IND.	
1	9-29-70	EGW	CHANGE 8 H 2 JOIST TO 10 H 3 JOIST IN SAMPLE PUMP BLDG #1

REVISIONS

SAMPLE PUMP BUILDING NO. 2 & 3

CONSTRUCTION OF TREATMENT FACILITIES FOR ACID MINE DRAINAGE
RAUSCH CREEK WATERSHED
SCHUYLKILL COUNTY, PENNSYLVANIA

JOB NO. 6-1570
DATE: AUG. 1970
SCALE: AS SHOWN
DRAWN:
APPROVED:

ANTHRACITE RESEARCH & DEVELOPMENT CO. INC.
consulting engineers
POTTSVILLE TAMAQUA
PENNSYLVANIA

DRAWING NO.
C-31