



PLAN-DWG C-1 & C-2
SCALE: 1/8" = 1'-0"

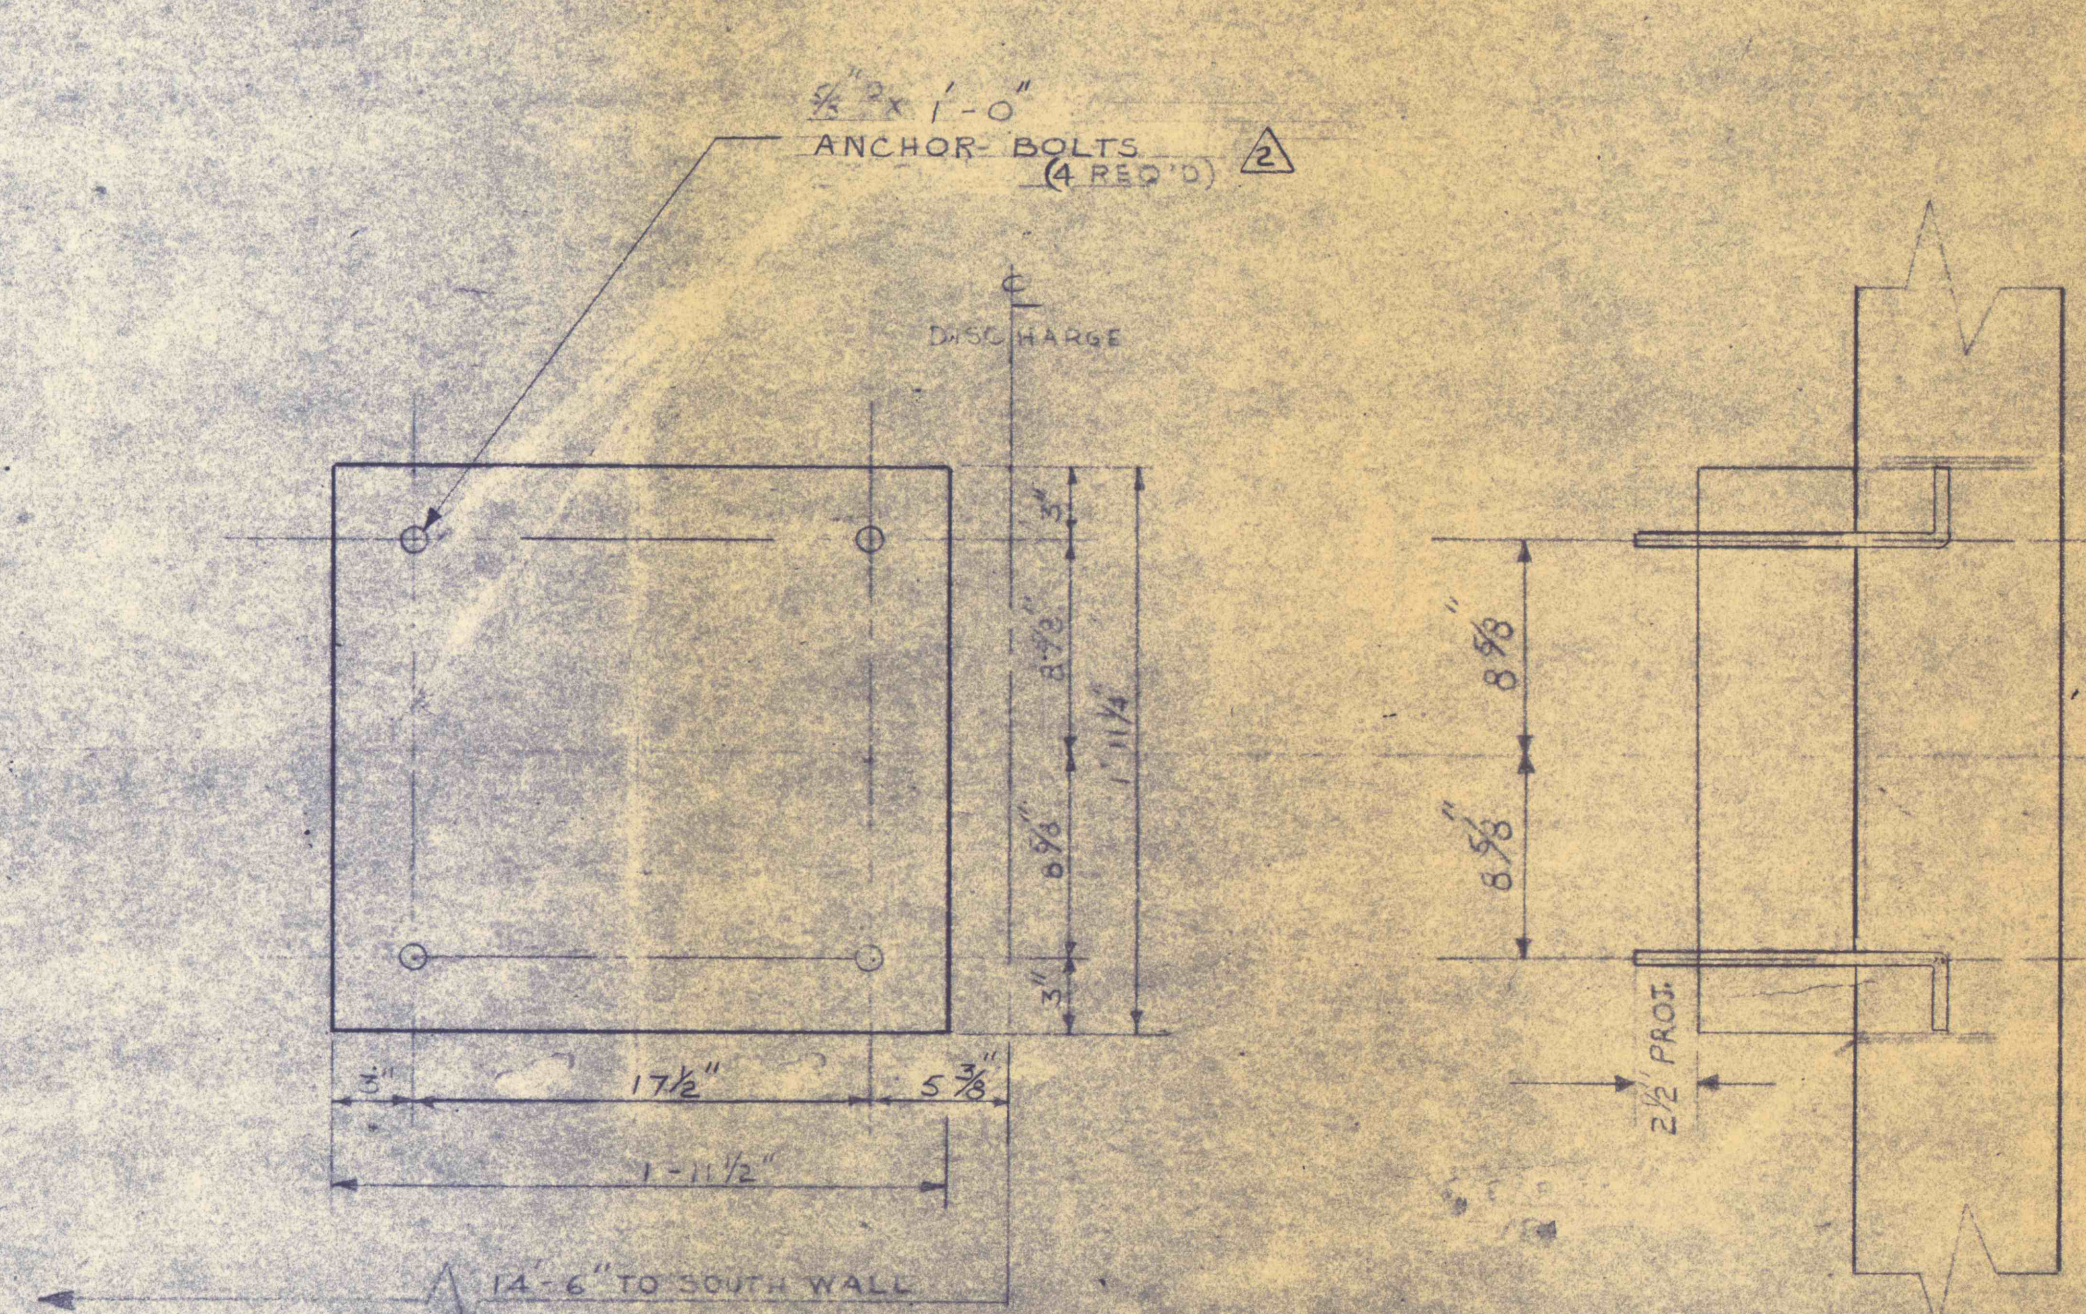


PLAN-DWG C-18 C-20 C-37
PUMP FDN (2 REQ'D)
PUMPS PP7A & PP7B
SCALE: 1/2" = 1'-0"


END VIEW
SCALE: 1/2" = 1'-0"

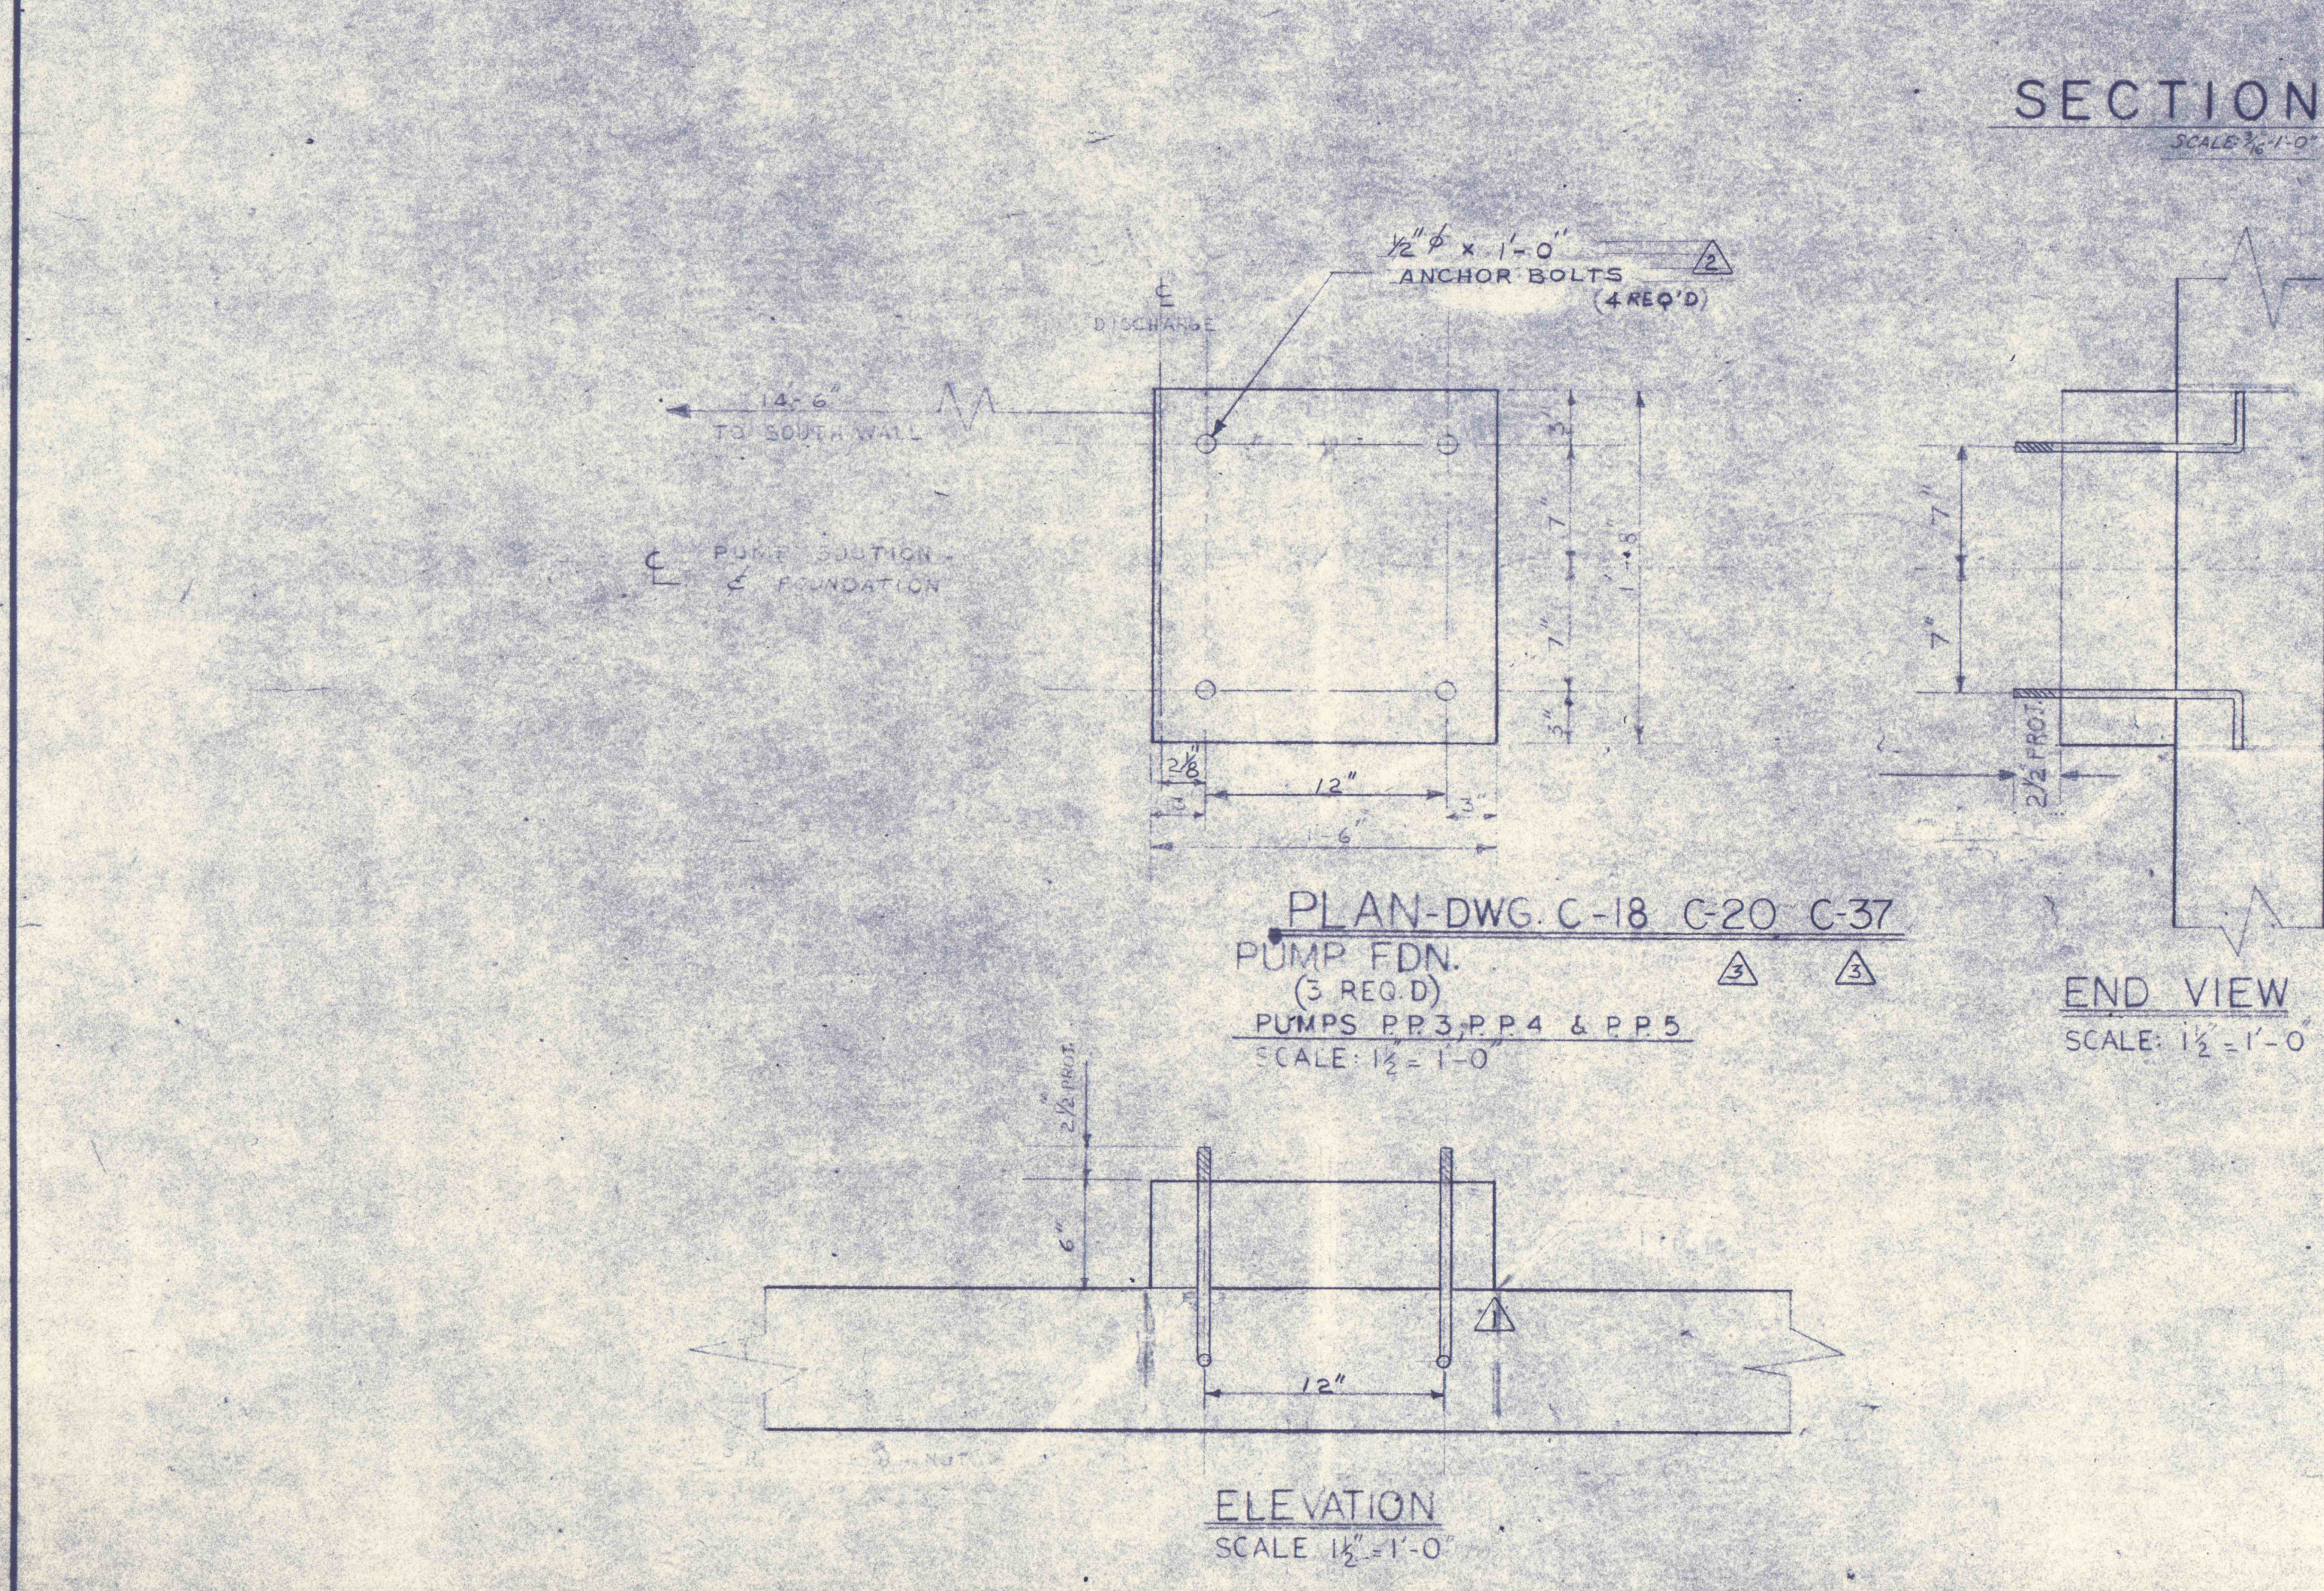

SECTION A-A
SCALE: 1/2" = 1'-0"

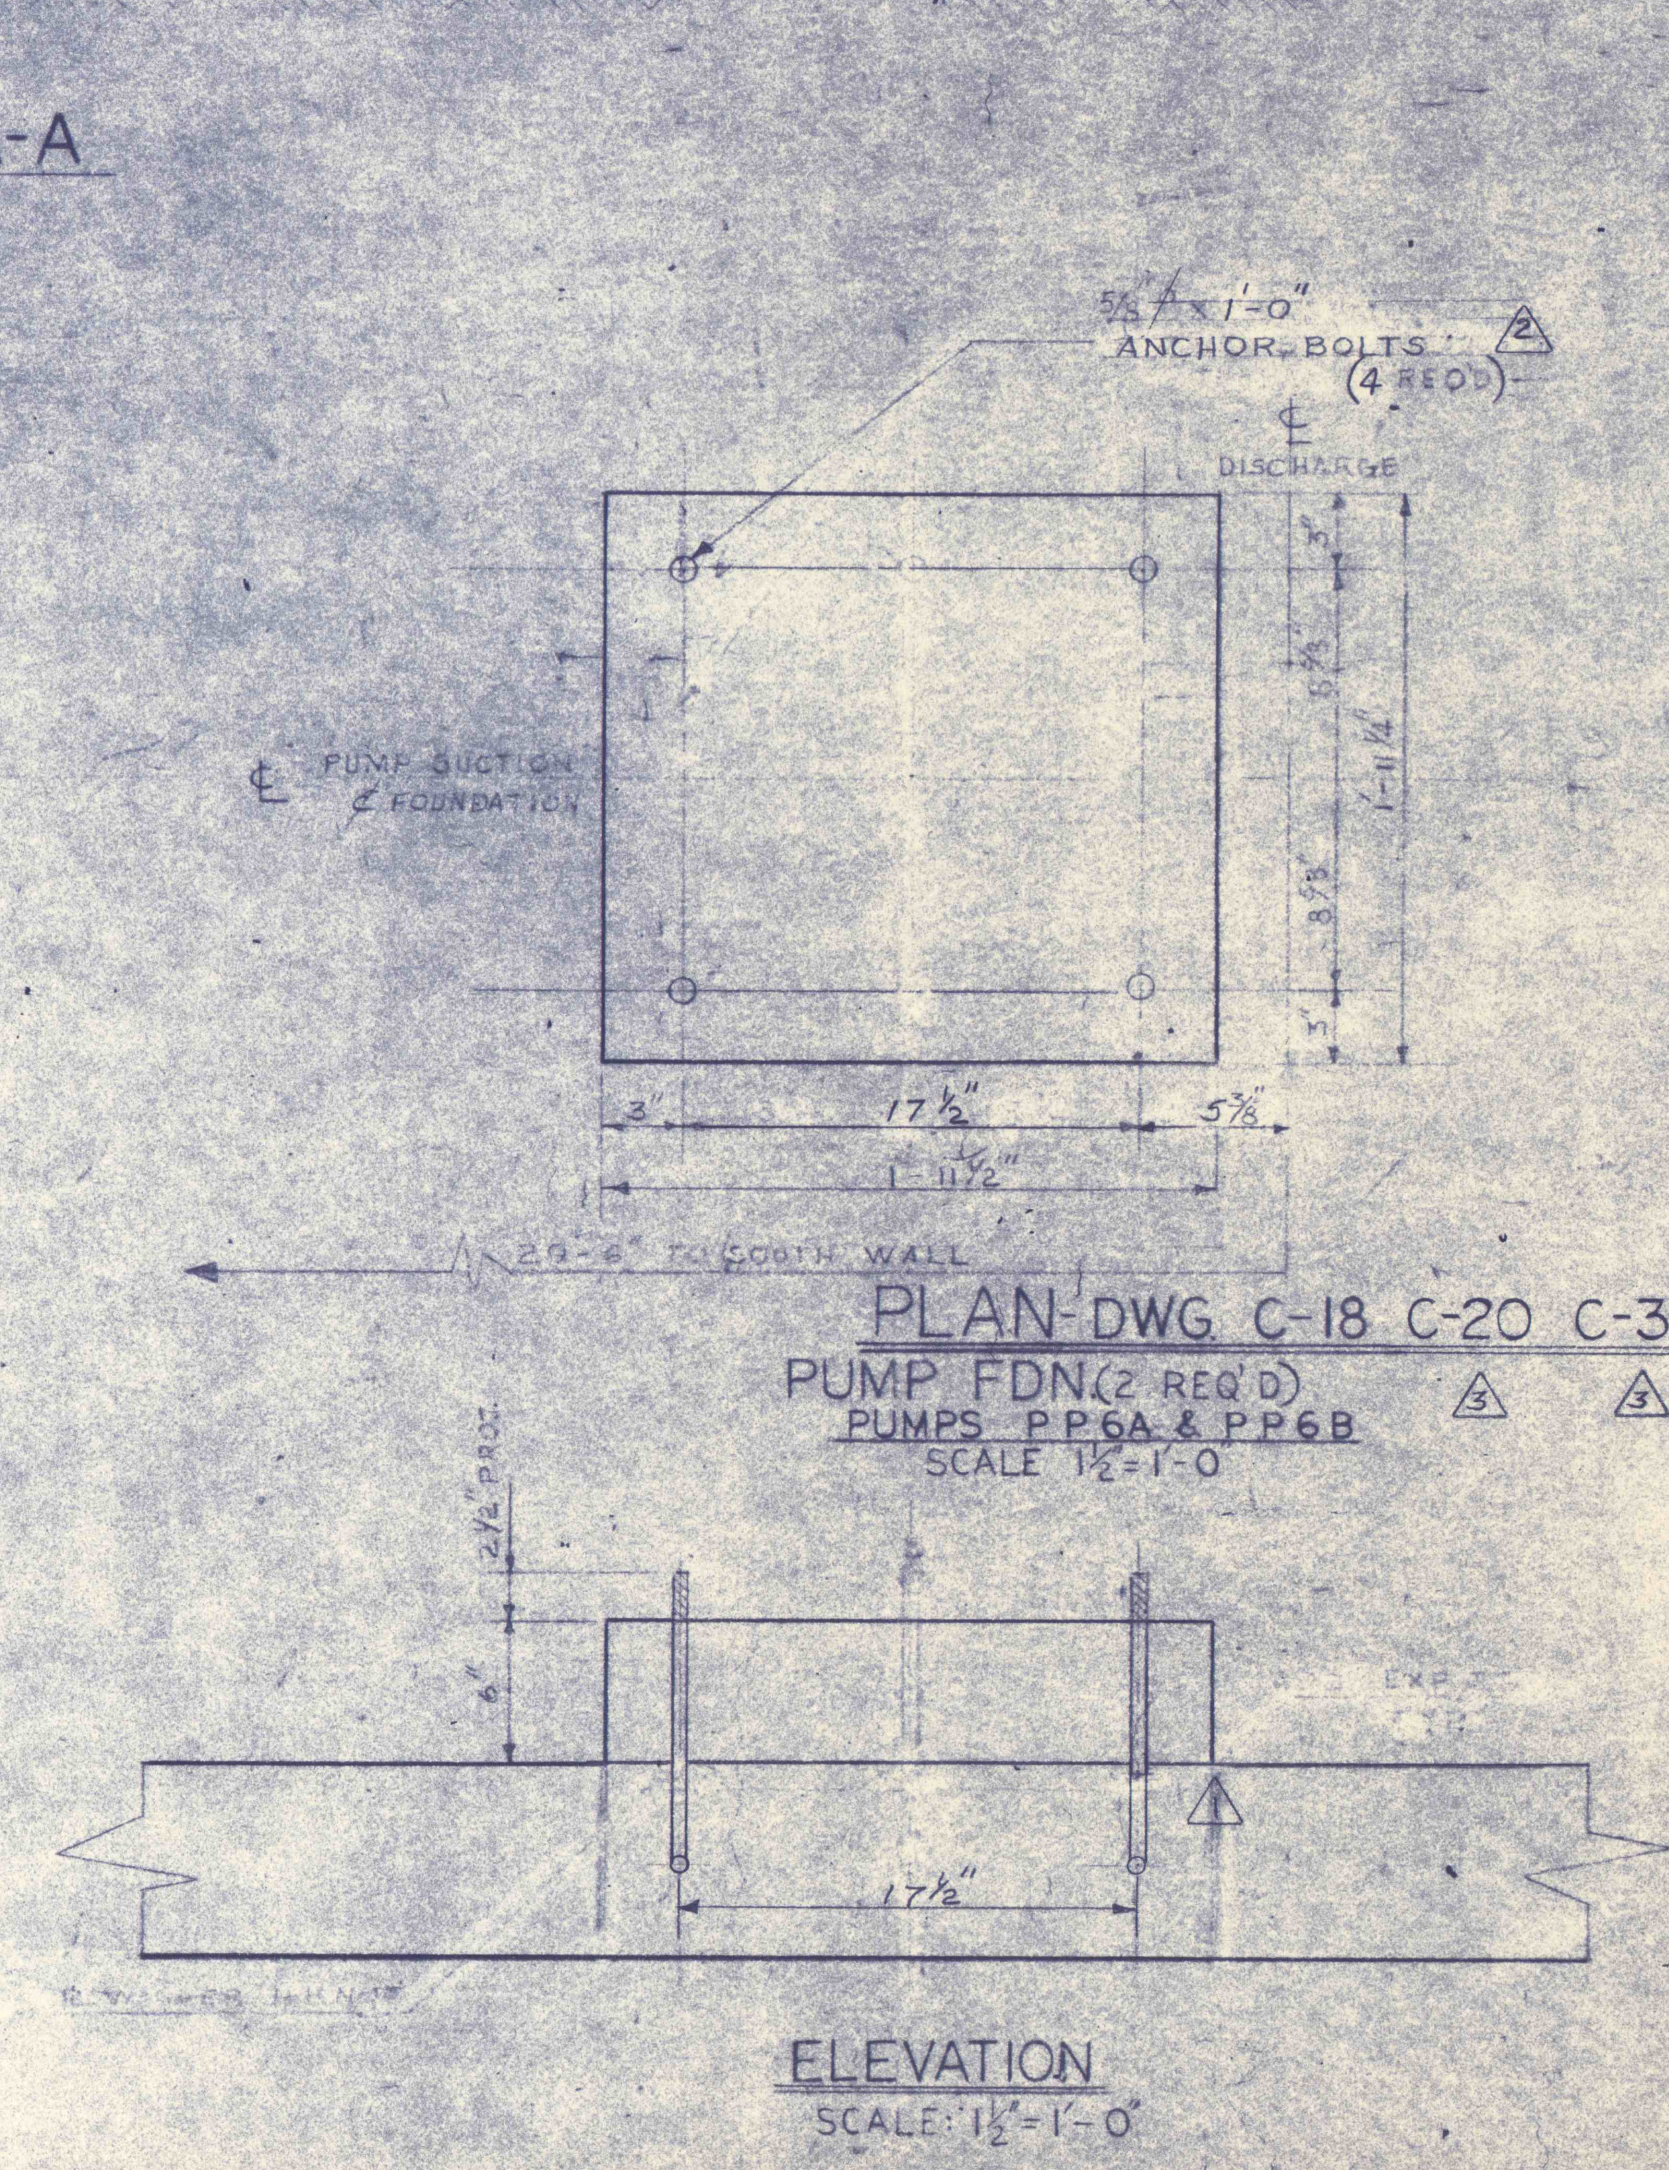


PLAN-DWG C-18 C-20 C-37
PUMP FDN (2 REQ'D)
PUMPS PP6A & PP6B
SCALE: 1/2" = 1'-0"

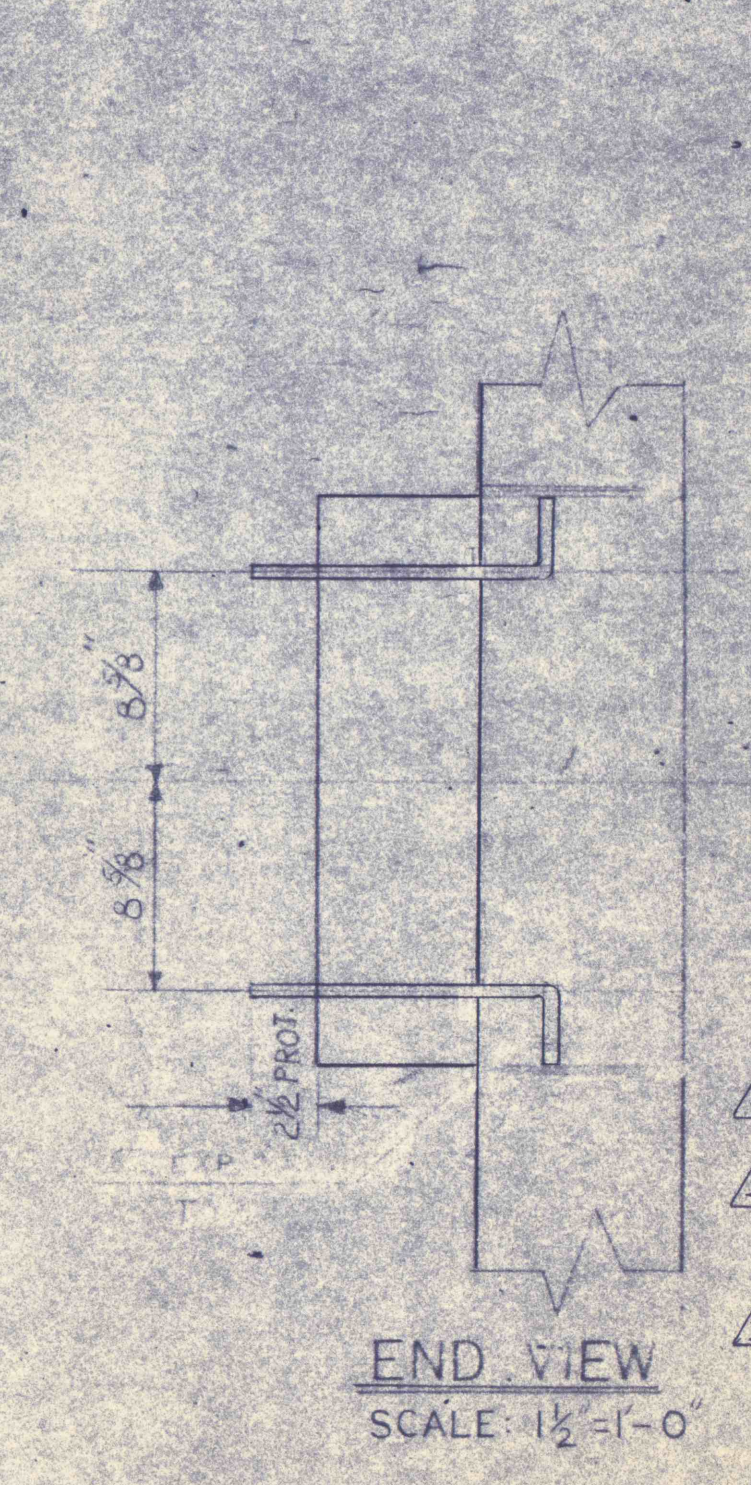

END VIEW
SCALE: 1/2" = 1'-0"

ELEVATION
SCALE: 1/2" = 1'-0"

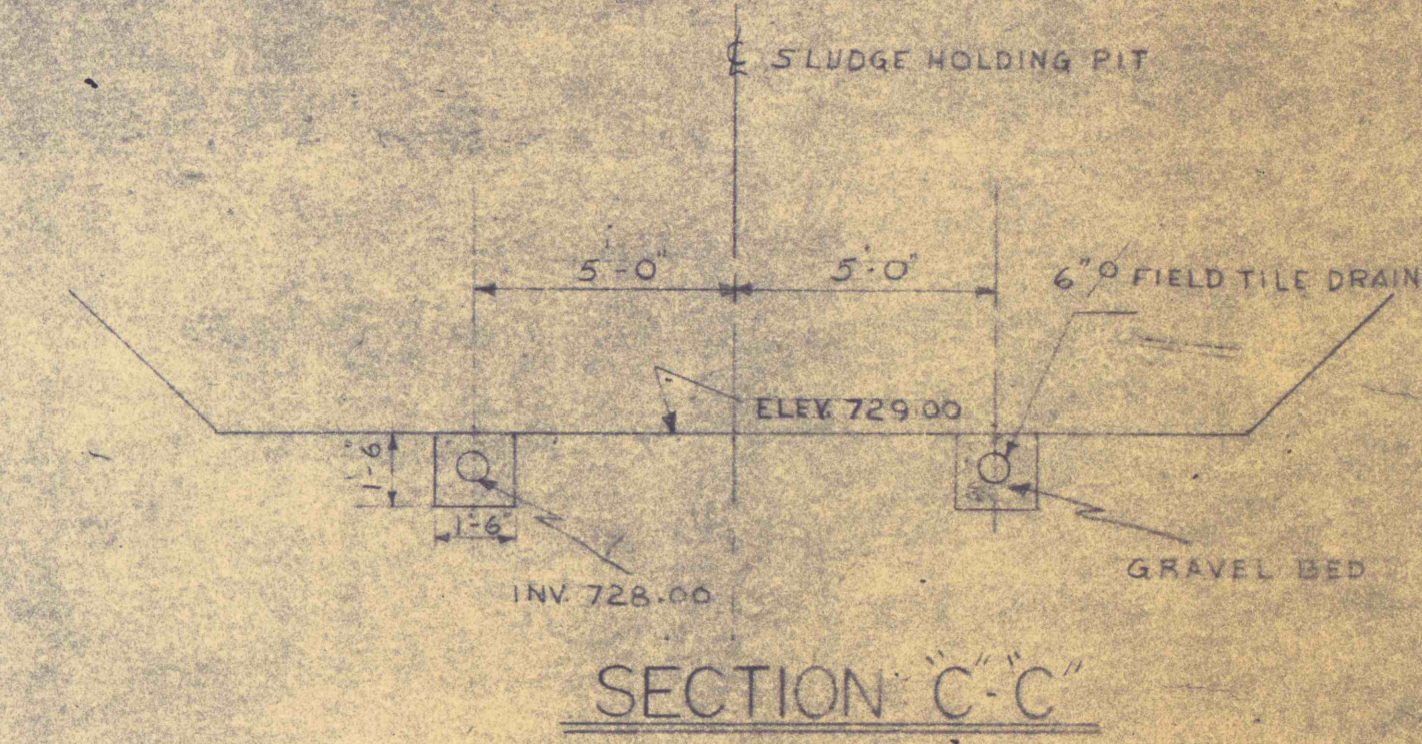

SECTION C-C

- REF DWGS
- C-20 SLUDGE THICKENR PUMP ROOM-MECH.
 - C-37 SLUDGE THICKENR-STRUCTURAL
 - C-18 SLUDGE THICKENR-STRUCTURAL
 - EHV-1 OUTLYING STRUCTURE'S EHV PLAN

<p>3. 11/2/74 CHANGED REFERENCE DWG. NUMBERS AS INDICATED</p> <p>2. 11/18/71 CHANGED ASTM A325 BOLTS TO ANCHOR BOLTS WITH BEND</p> <p>1. 11/18/71 REV PUMP PADS - TO BE POURED AS INDICATED</p>	
<p>REVISIONS</p>	
<p>SLUDGE HOLDING PIT</p>	
<p>CONSTRUCTION OF TREATMENT FACILITIES OF ACID MINE DRAINAGE RAUSCH CREEK WATERSHED SCHUYLKILL COUNTY PENNSYLVANIA</p>	
<p>JOB NO: 6806</p> <p>DATE: NOV. 1969</p> <p>SCALE: NOTED</p> <p>DRAWN: G.C.E.</p> <p>APPROVED: T.H.R. J.W.</p>	<p>DRAWING NO:</p> <p>C-21</p>
<p>ANTHRACITE RESEARCH & DEVELOPMENT CO. INC. consulting engineers POTTSVILLE PENNSYLVANIA TAMAQUA</p>	

