

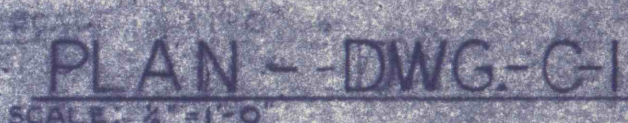


STRUCTURAL

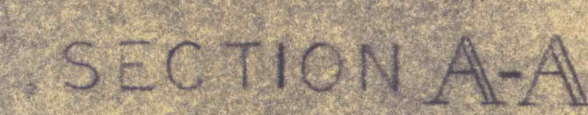


MECHANICAL

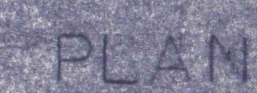

THRUST BLOCK DETAIL

SCALE 1/2" = 1'-0"

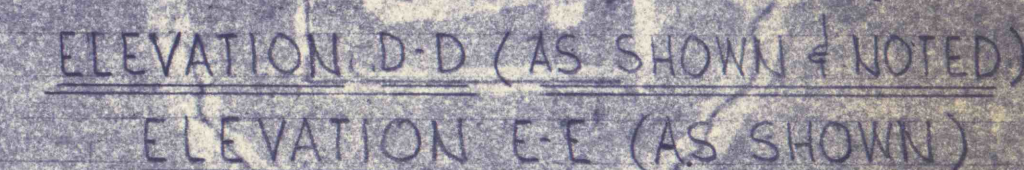

ELEV H-H



2	E-T	CHANGED NOTE - 14" C.C.P. & 12" STEEL PIPE	(E.T.)
1	W-10	DELETED DETAIL * ADDED DETAILS: F&G, ELEV. D, E, H	
REVISIONS			
FLASH MIXER — MECH. & STRUCTURAL			
CONSTRUCTION OF TREATMENT FACILITIES FOR ACID MINE DRAINAGE RAUSH CREEK WATERSHED SCHUYLKILL COUNTY, PENNSYLVANIA			JOB NO. 0050 DATE: NOV. 1982 SCALE: AS SHOWN DRAWN: R.B. BROWN APPROVED: J.W. HALL
ANTIRACIST RESEARCH & DEVELOPMENT CO. INC. consulting engineers			DRAWING NO. C-1

C-13