



SECTION B-B

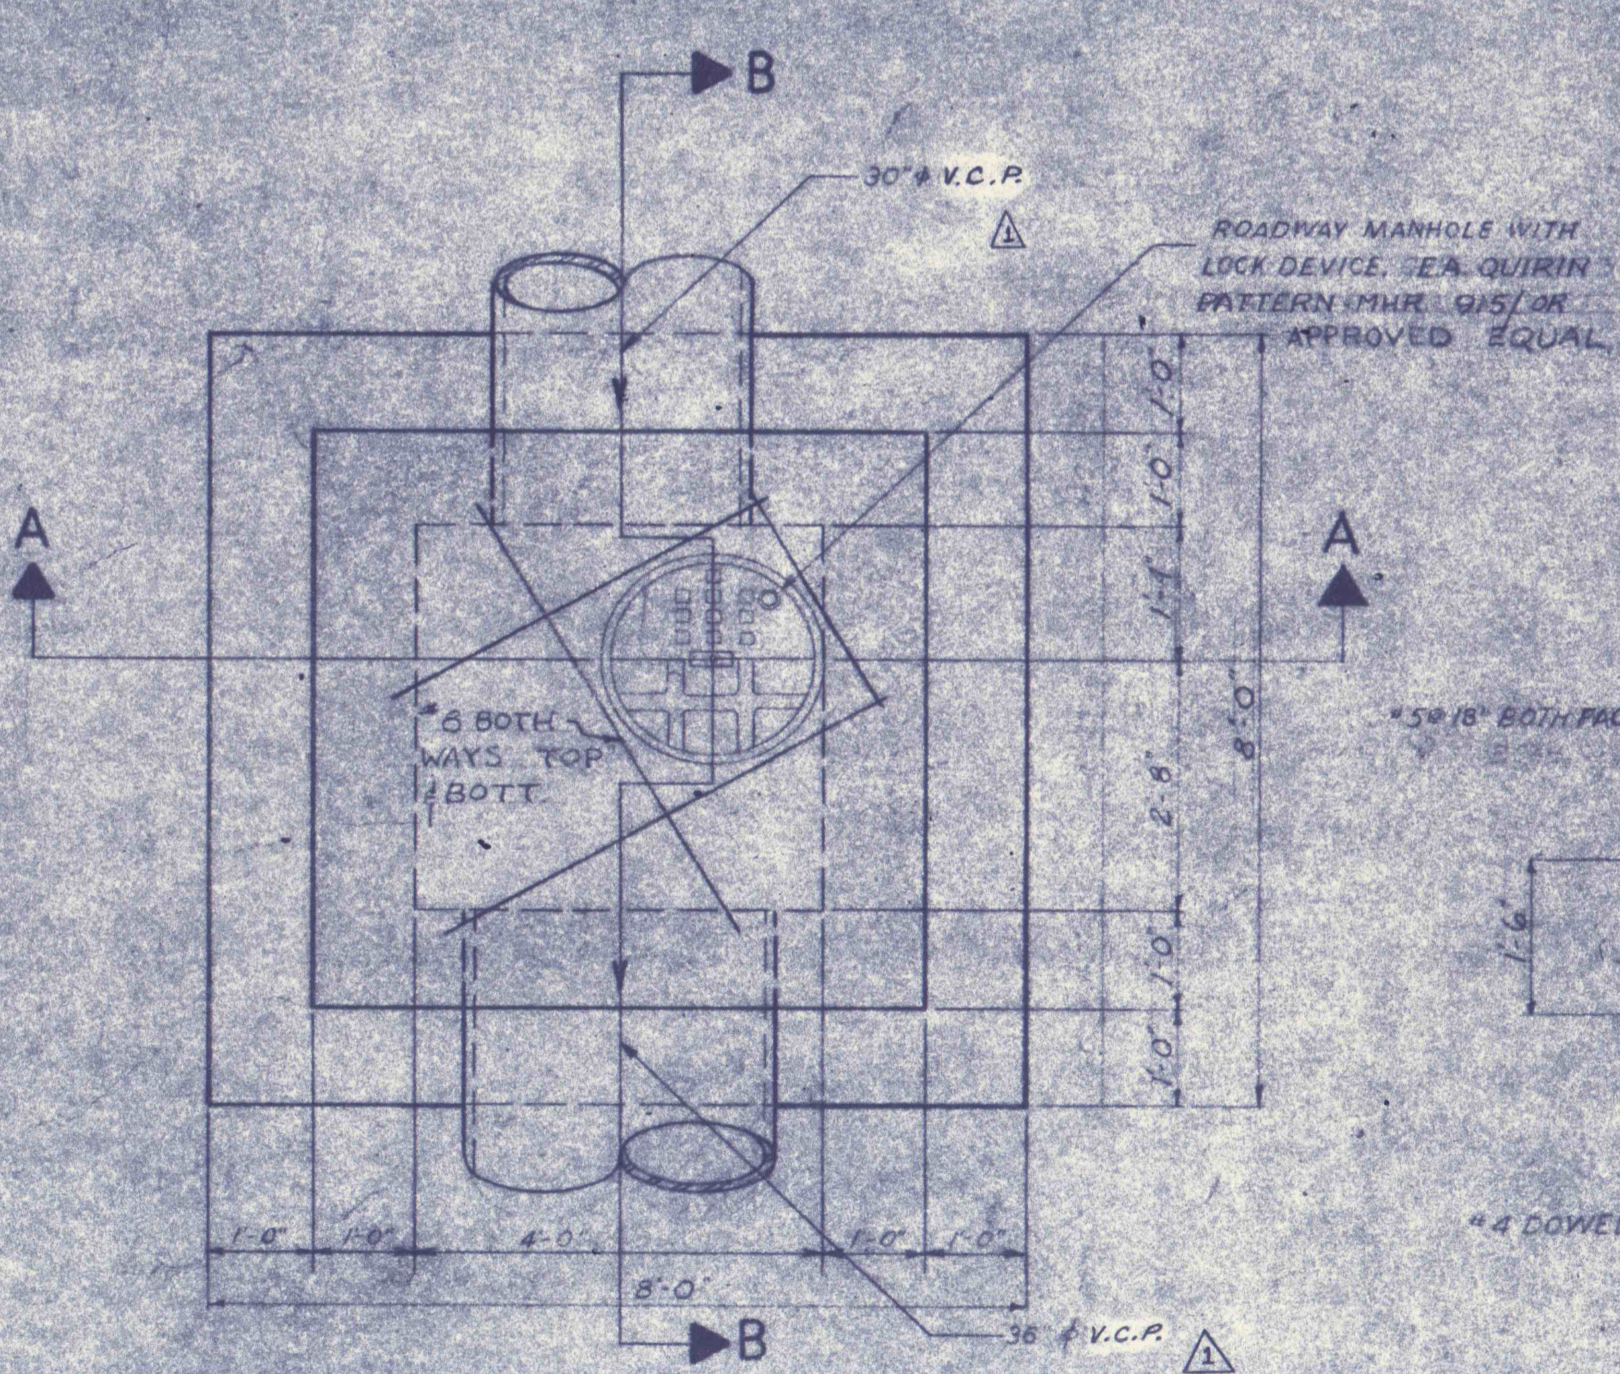


PLAN

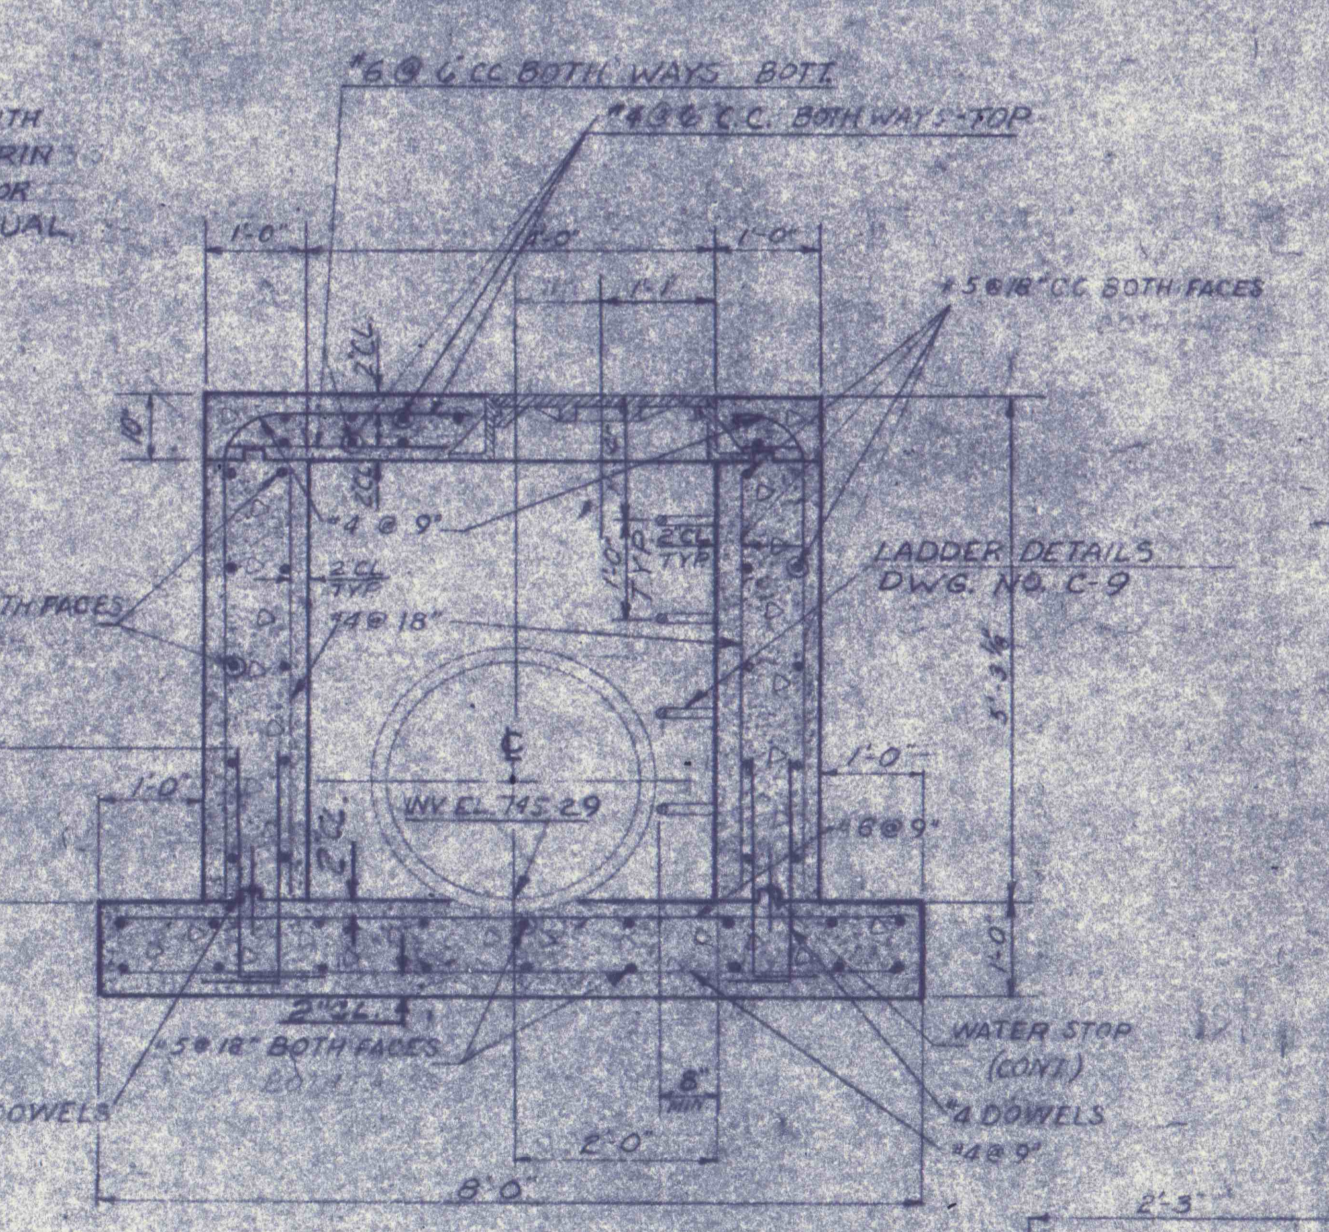


SECTION A-A

INTERCEPTOR BOX NO. 1 - DWG. C-1

SCALE: 1/4\"/>

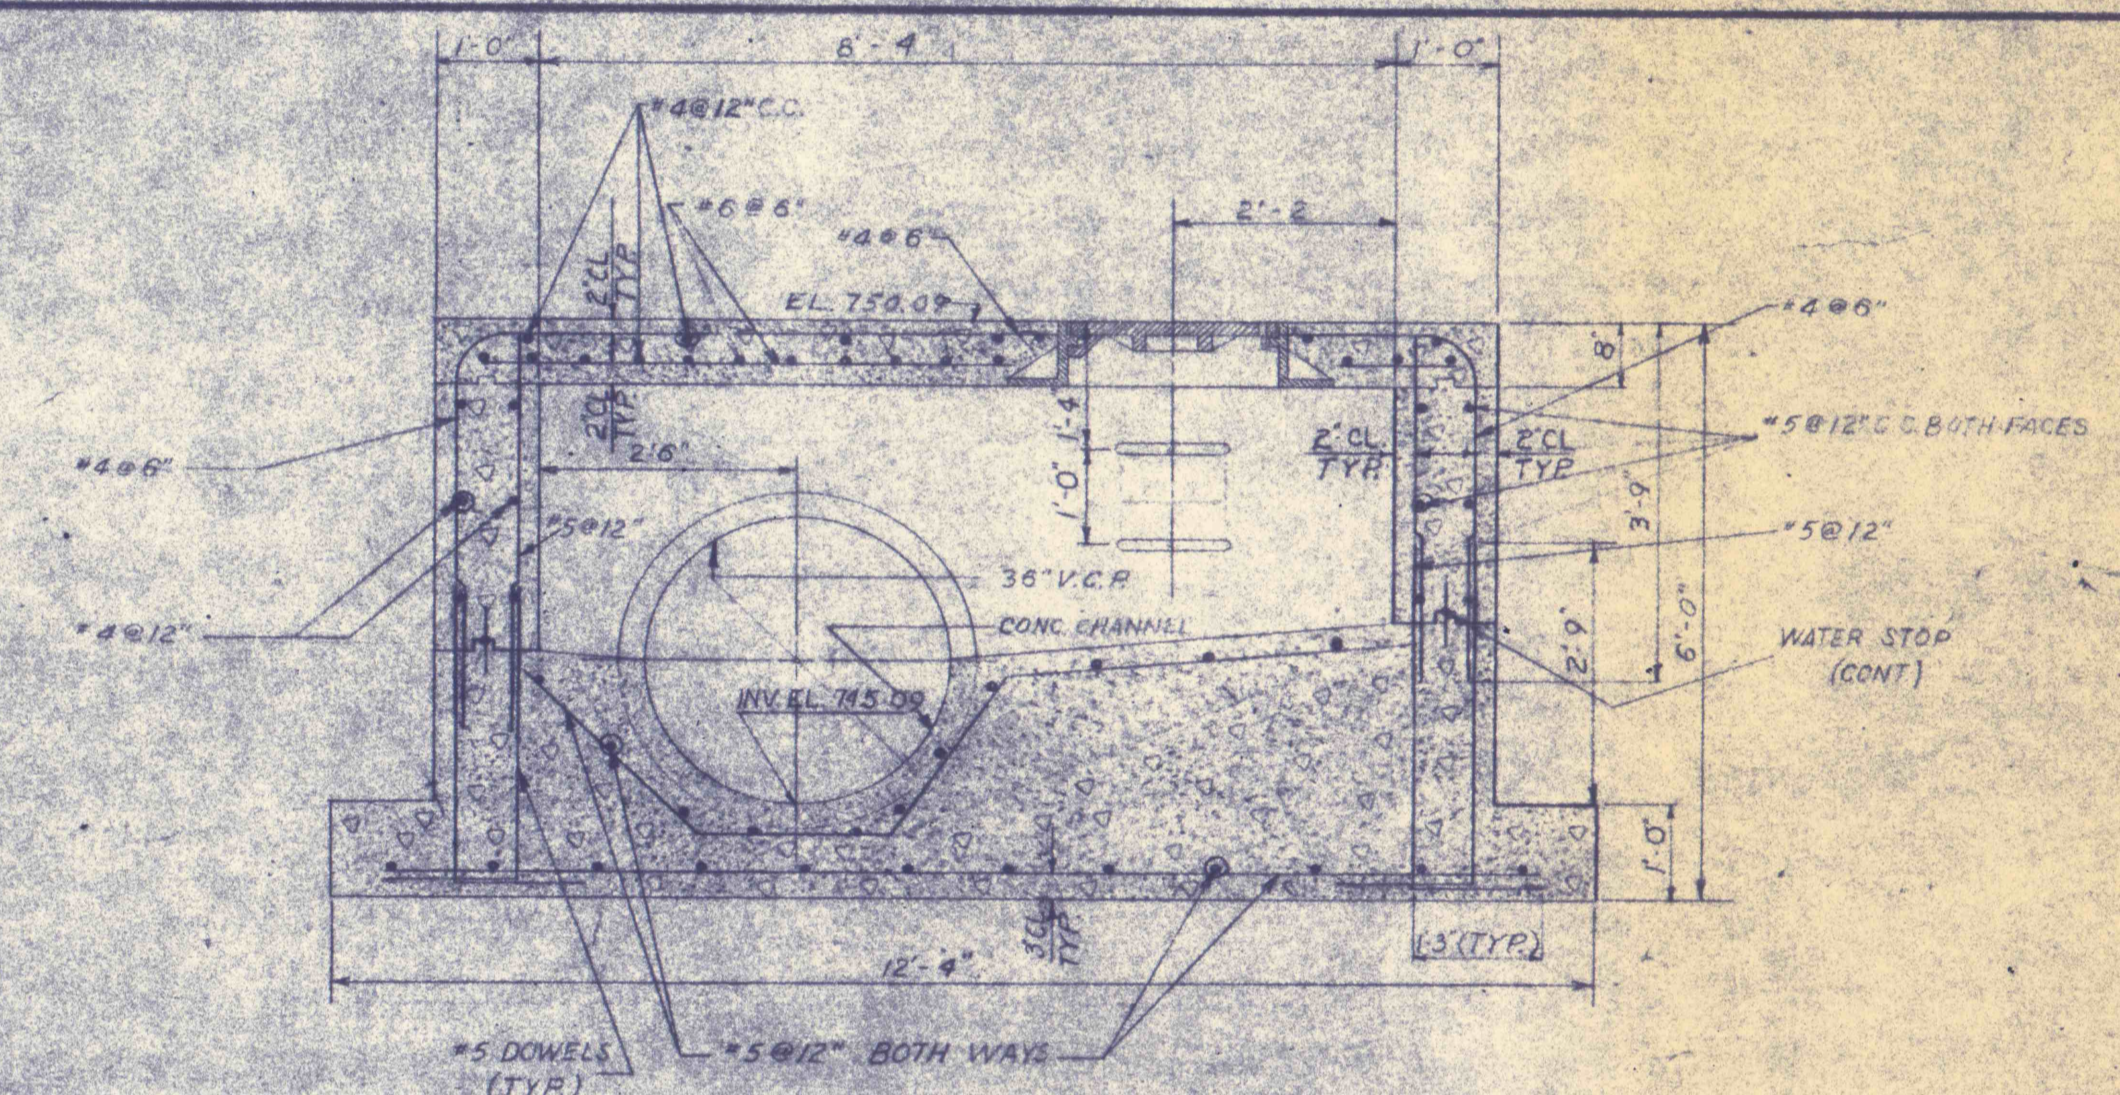

SECTION B-B

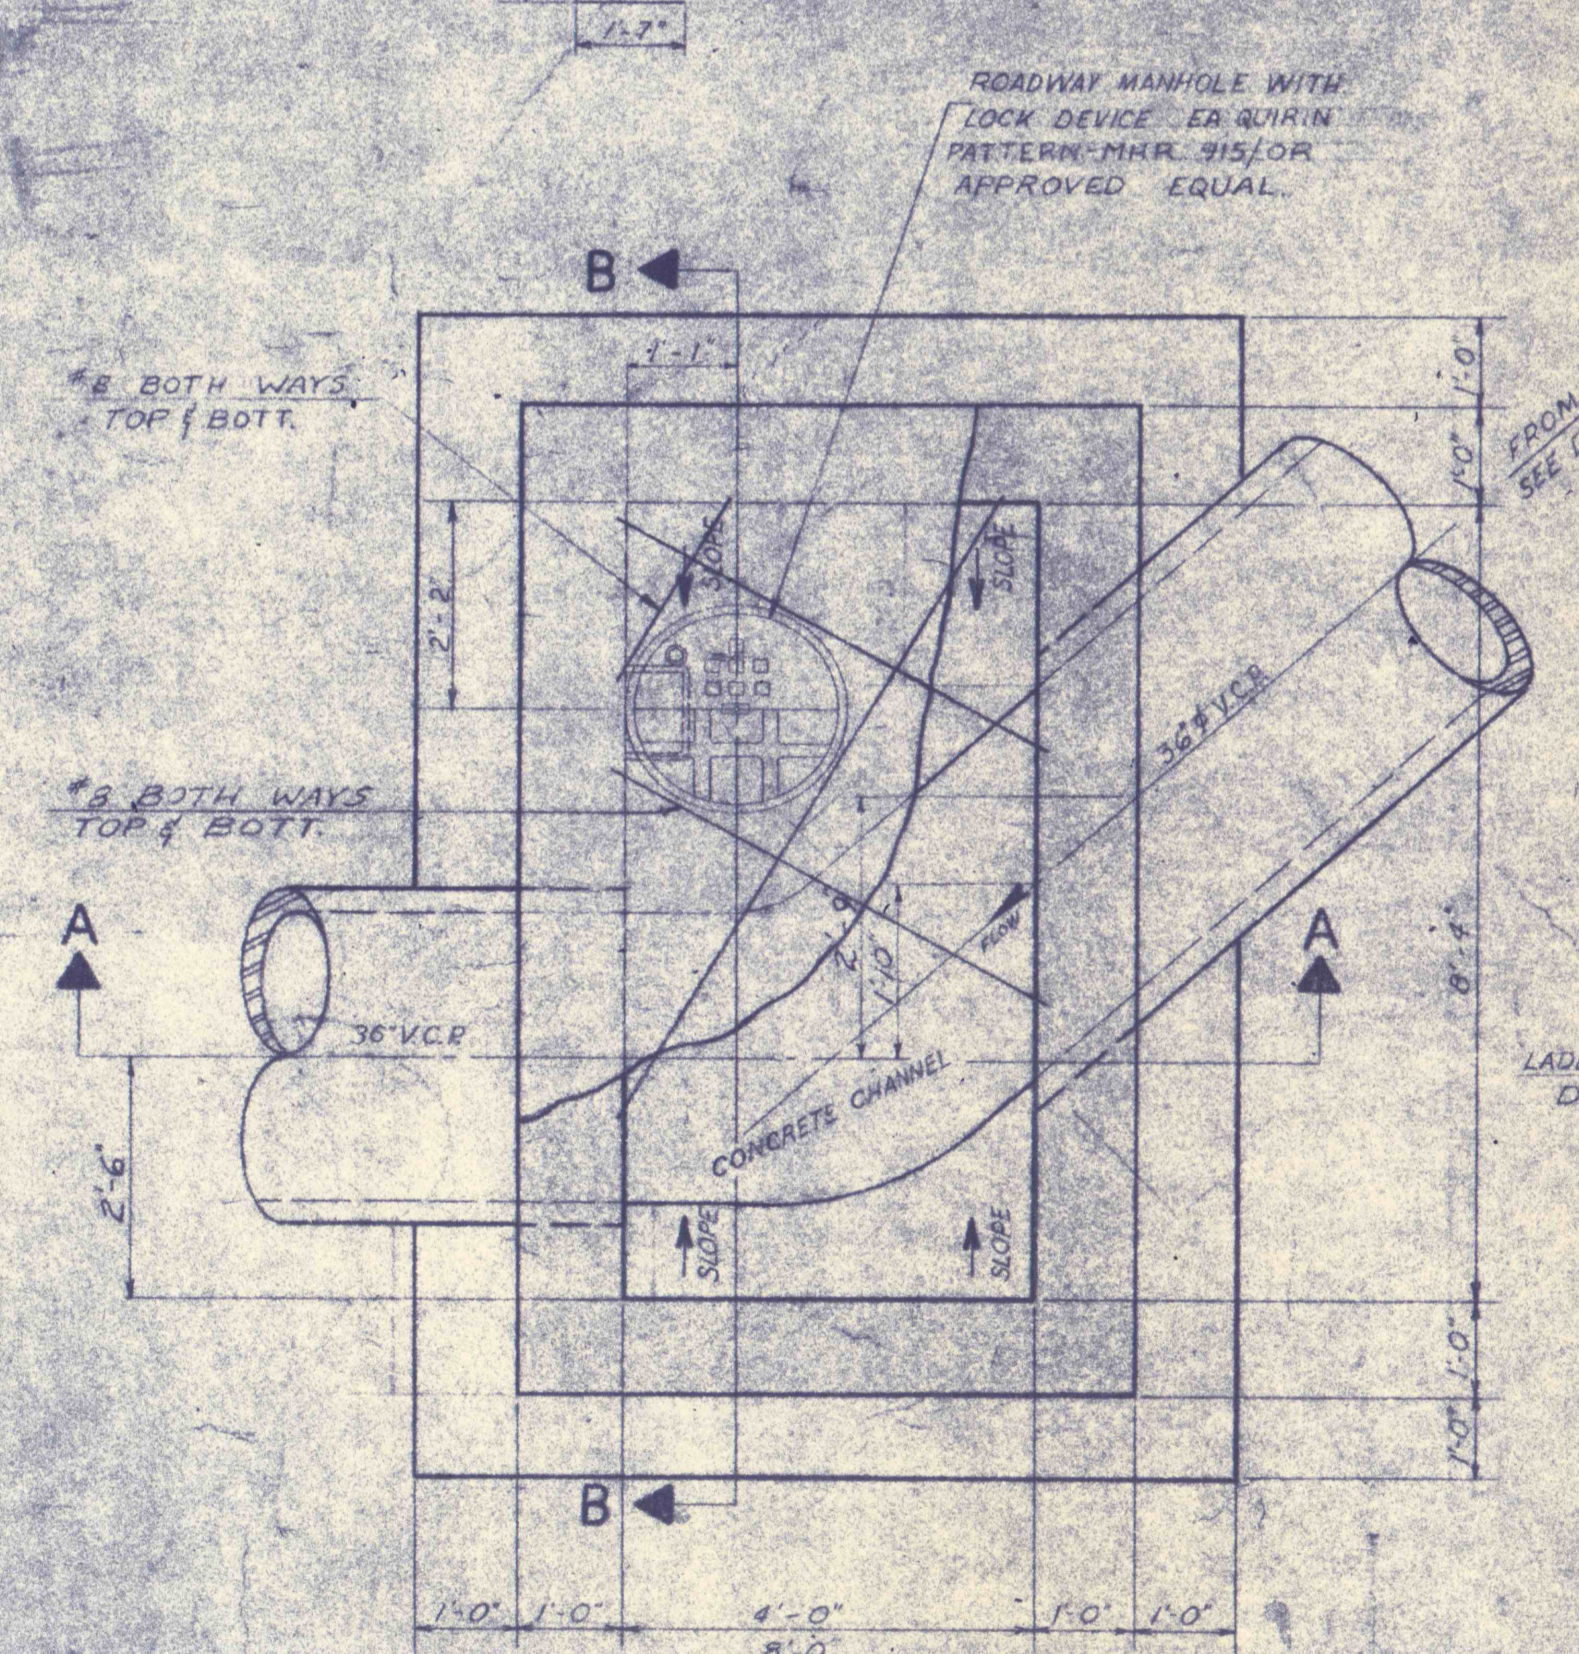


PLAN

INTERCEPTOR BOX NO. 2 - DWG. C-1 & C-2

SCALE: 1/4\"/>

**NOTE:**  
ALL CONSTRUCTION JOINTS BELOW WATER LEVEL TO HAVE 9\"/>

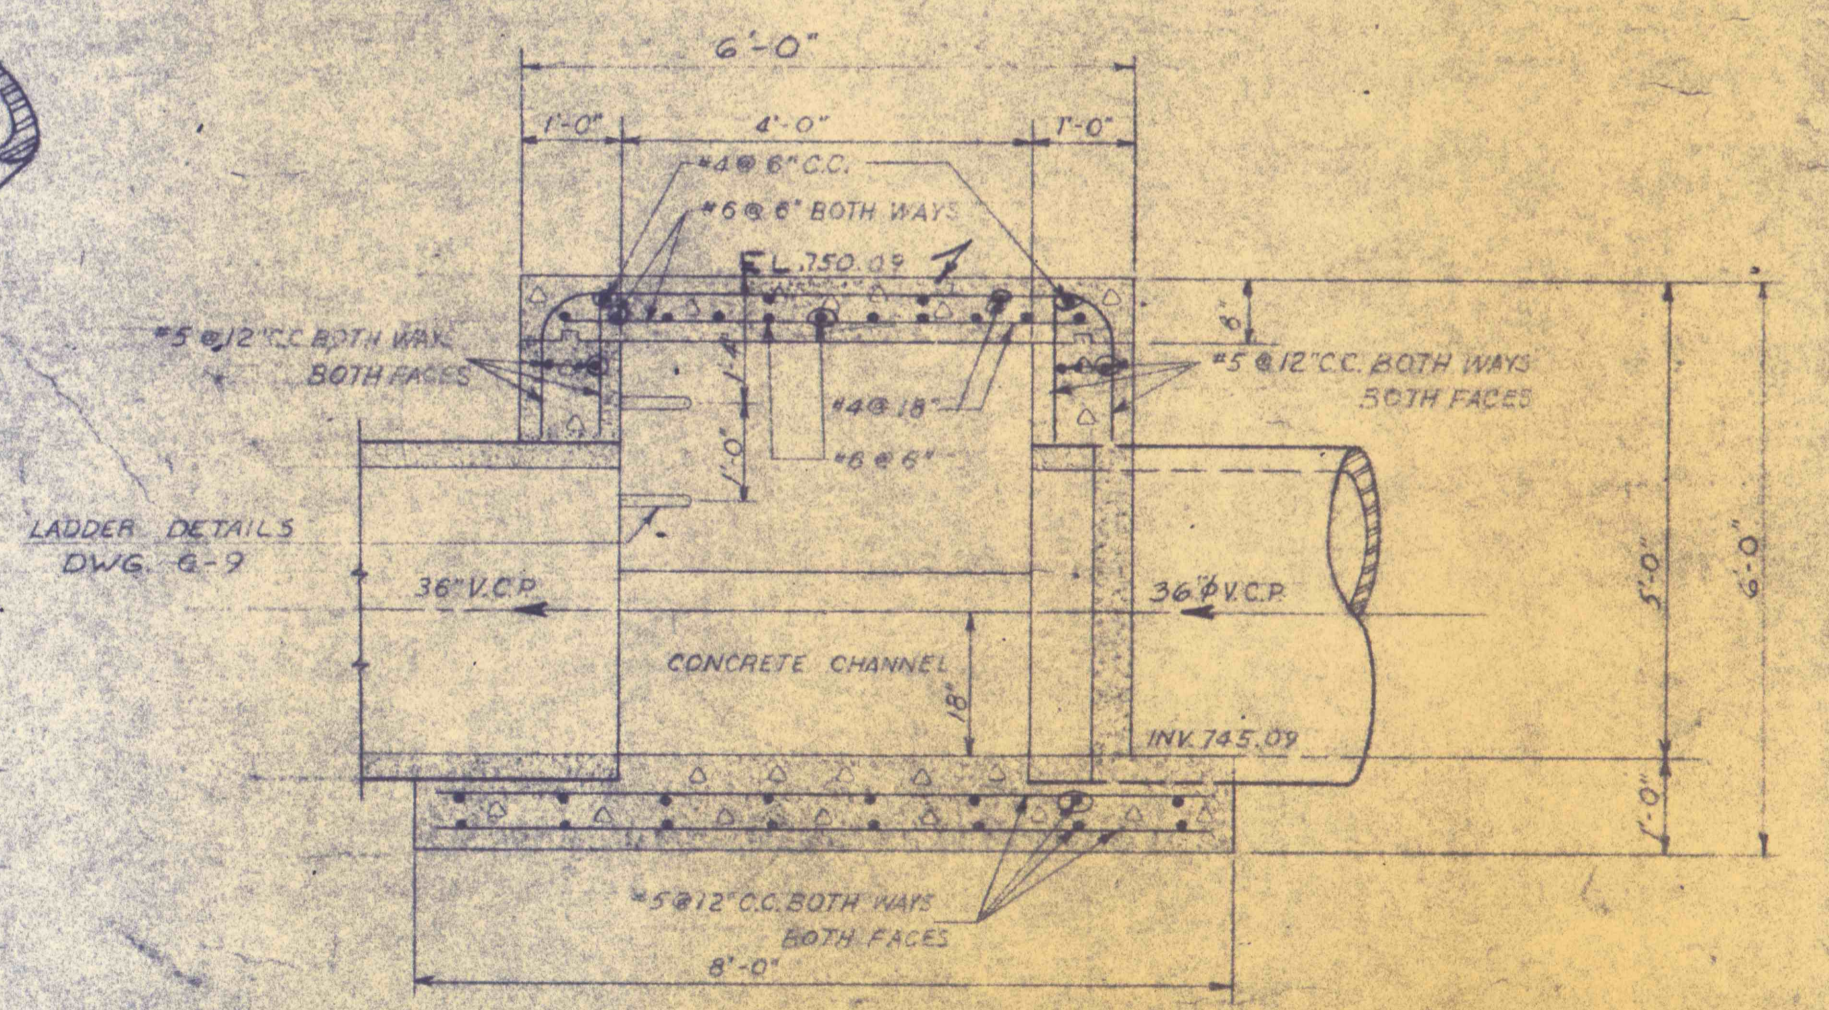

SECTION A-A



1	5-20-71 CHANGED FROM C.I.P. TO V.C.P.	(E.D.S.)
REVISIONS		
CONSTRUCTION DETAILS INTERCEPTORS NO. 1 & 2		
CONSTRUCTION OF TREATMENT FACILITIES FOR ACID MINE DRAINAGE RAUSCH CREEK WATERSHED SCHUYLKILL COUNTY PENNSYLVANIA		JOB NO. 6805 DATE: NOV. 1969 SCALE: NOTED DRAWN: J.S.N. APPROVED: H.R.J.U.L.
ANTHRACITE RESEARCH & DEVELOPMENT CO. INC. CONSULTING ENGINEERS POTTSVILLE PENNSYLVANIA TAMAGUA		DRAWING NO. C-22