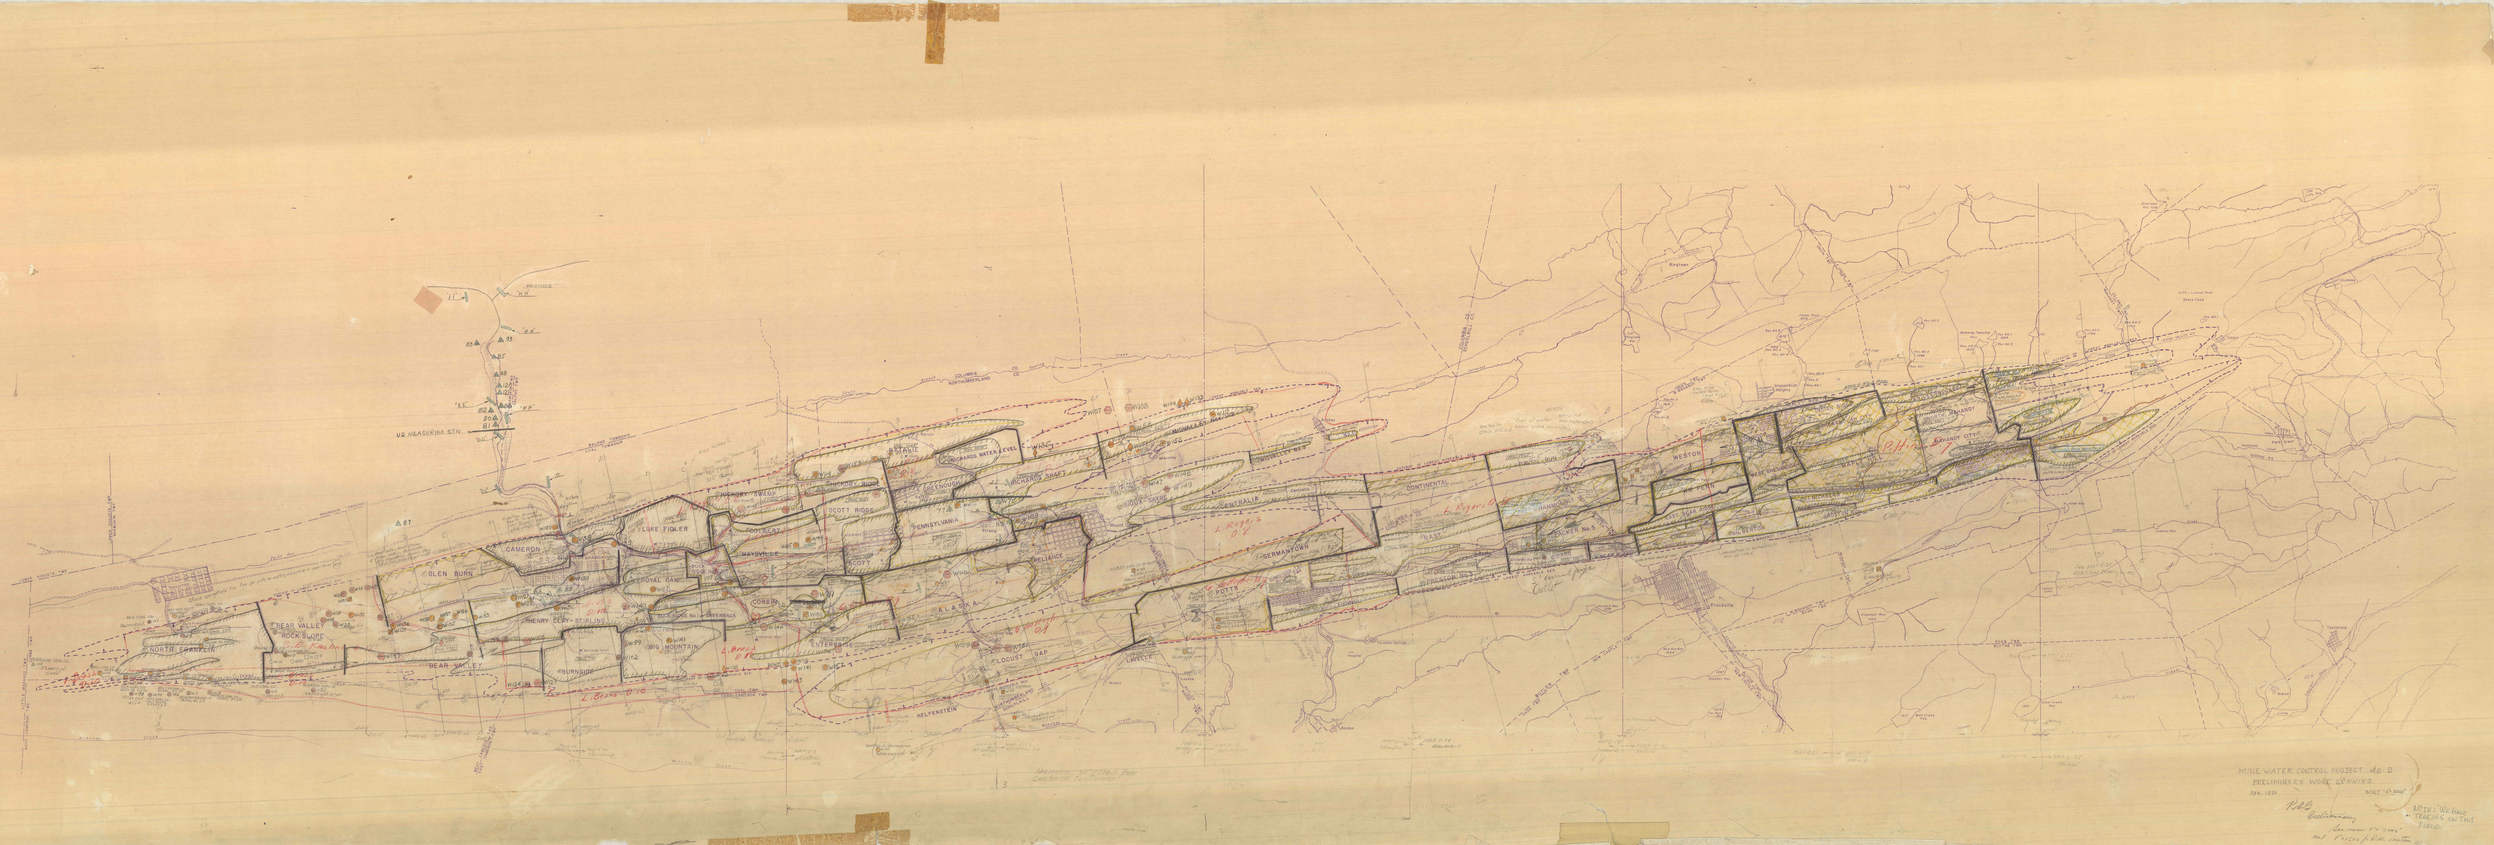
MINE WATER CONTROL PROJECT AB-D
PRELIMINARY WORK DRAWING
JAN. 1939
NOTE: USE HAND TRACING ON THIS FIGURE
US MEASURING STN.
CAMERON
GLEN BURN
BEAR VALLEY
ROYAL OAK
CORBIN
PENNSYLVANIA
ALASKA
BERMANTOWN
DONTINENTAL
WESTON
