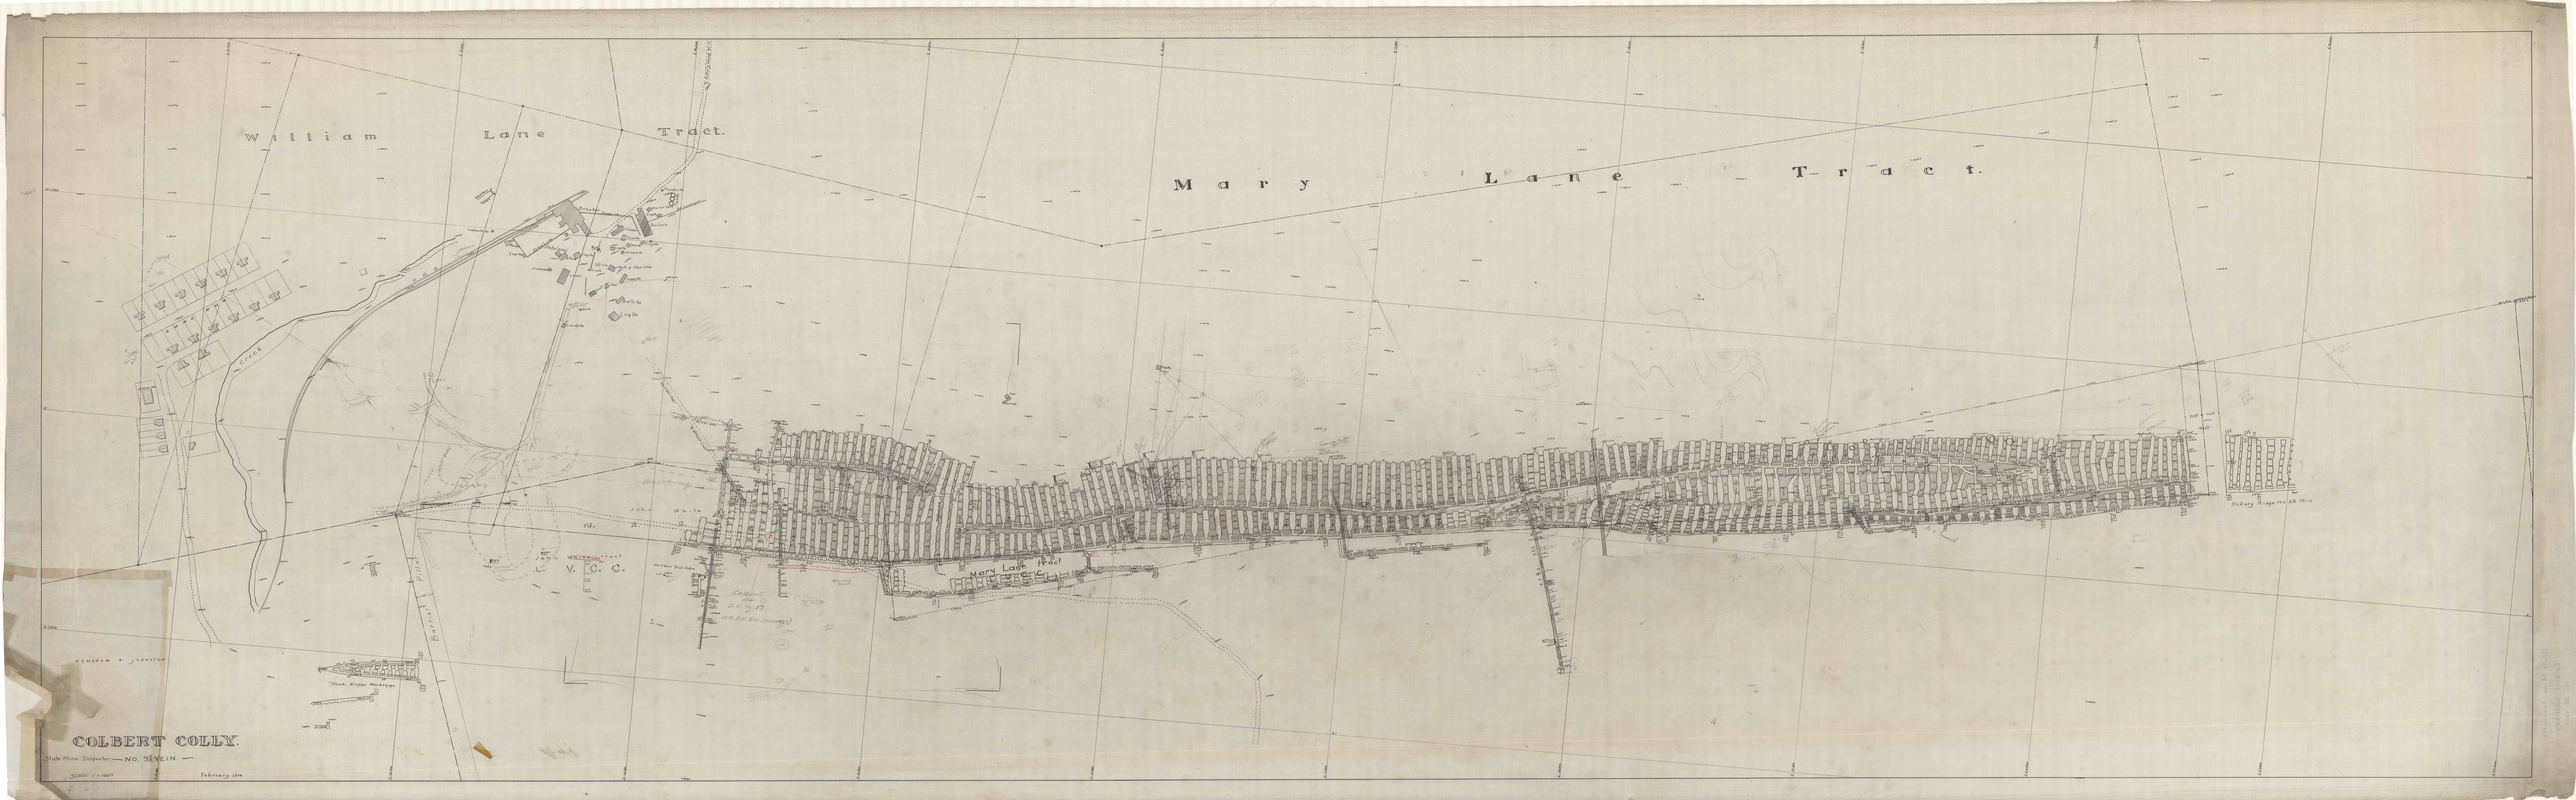

William Lane Tract.
Mary Lane Tract.
Mary Lane Tract
L. V. C. C.
Hickory Ridge Head Veins
COLBERT COLLY.
