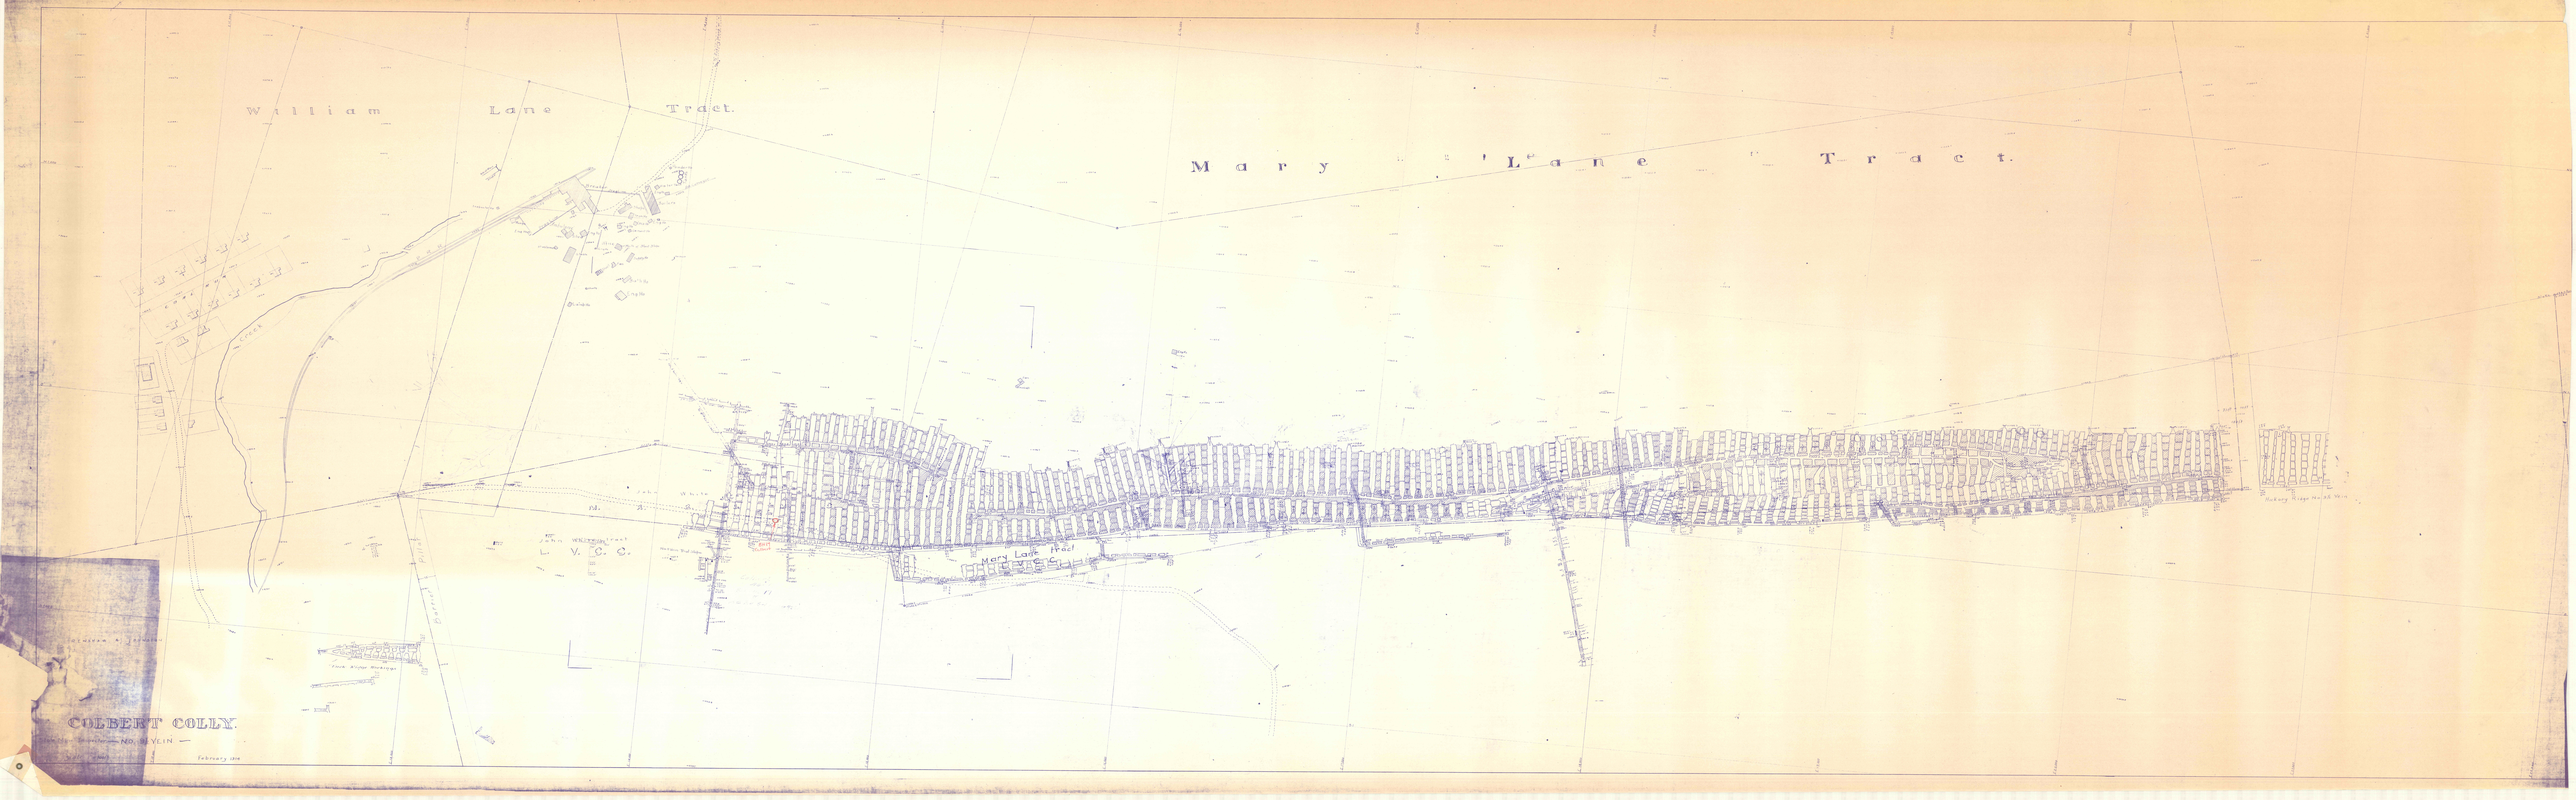
William Lane Tract.
Mary Lane Tract.
Mary Lane Tract
COLBERT COLLY.
— VEIN —