


Village of Marjeville

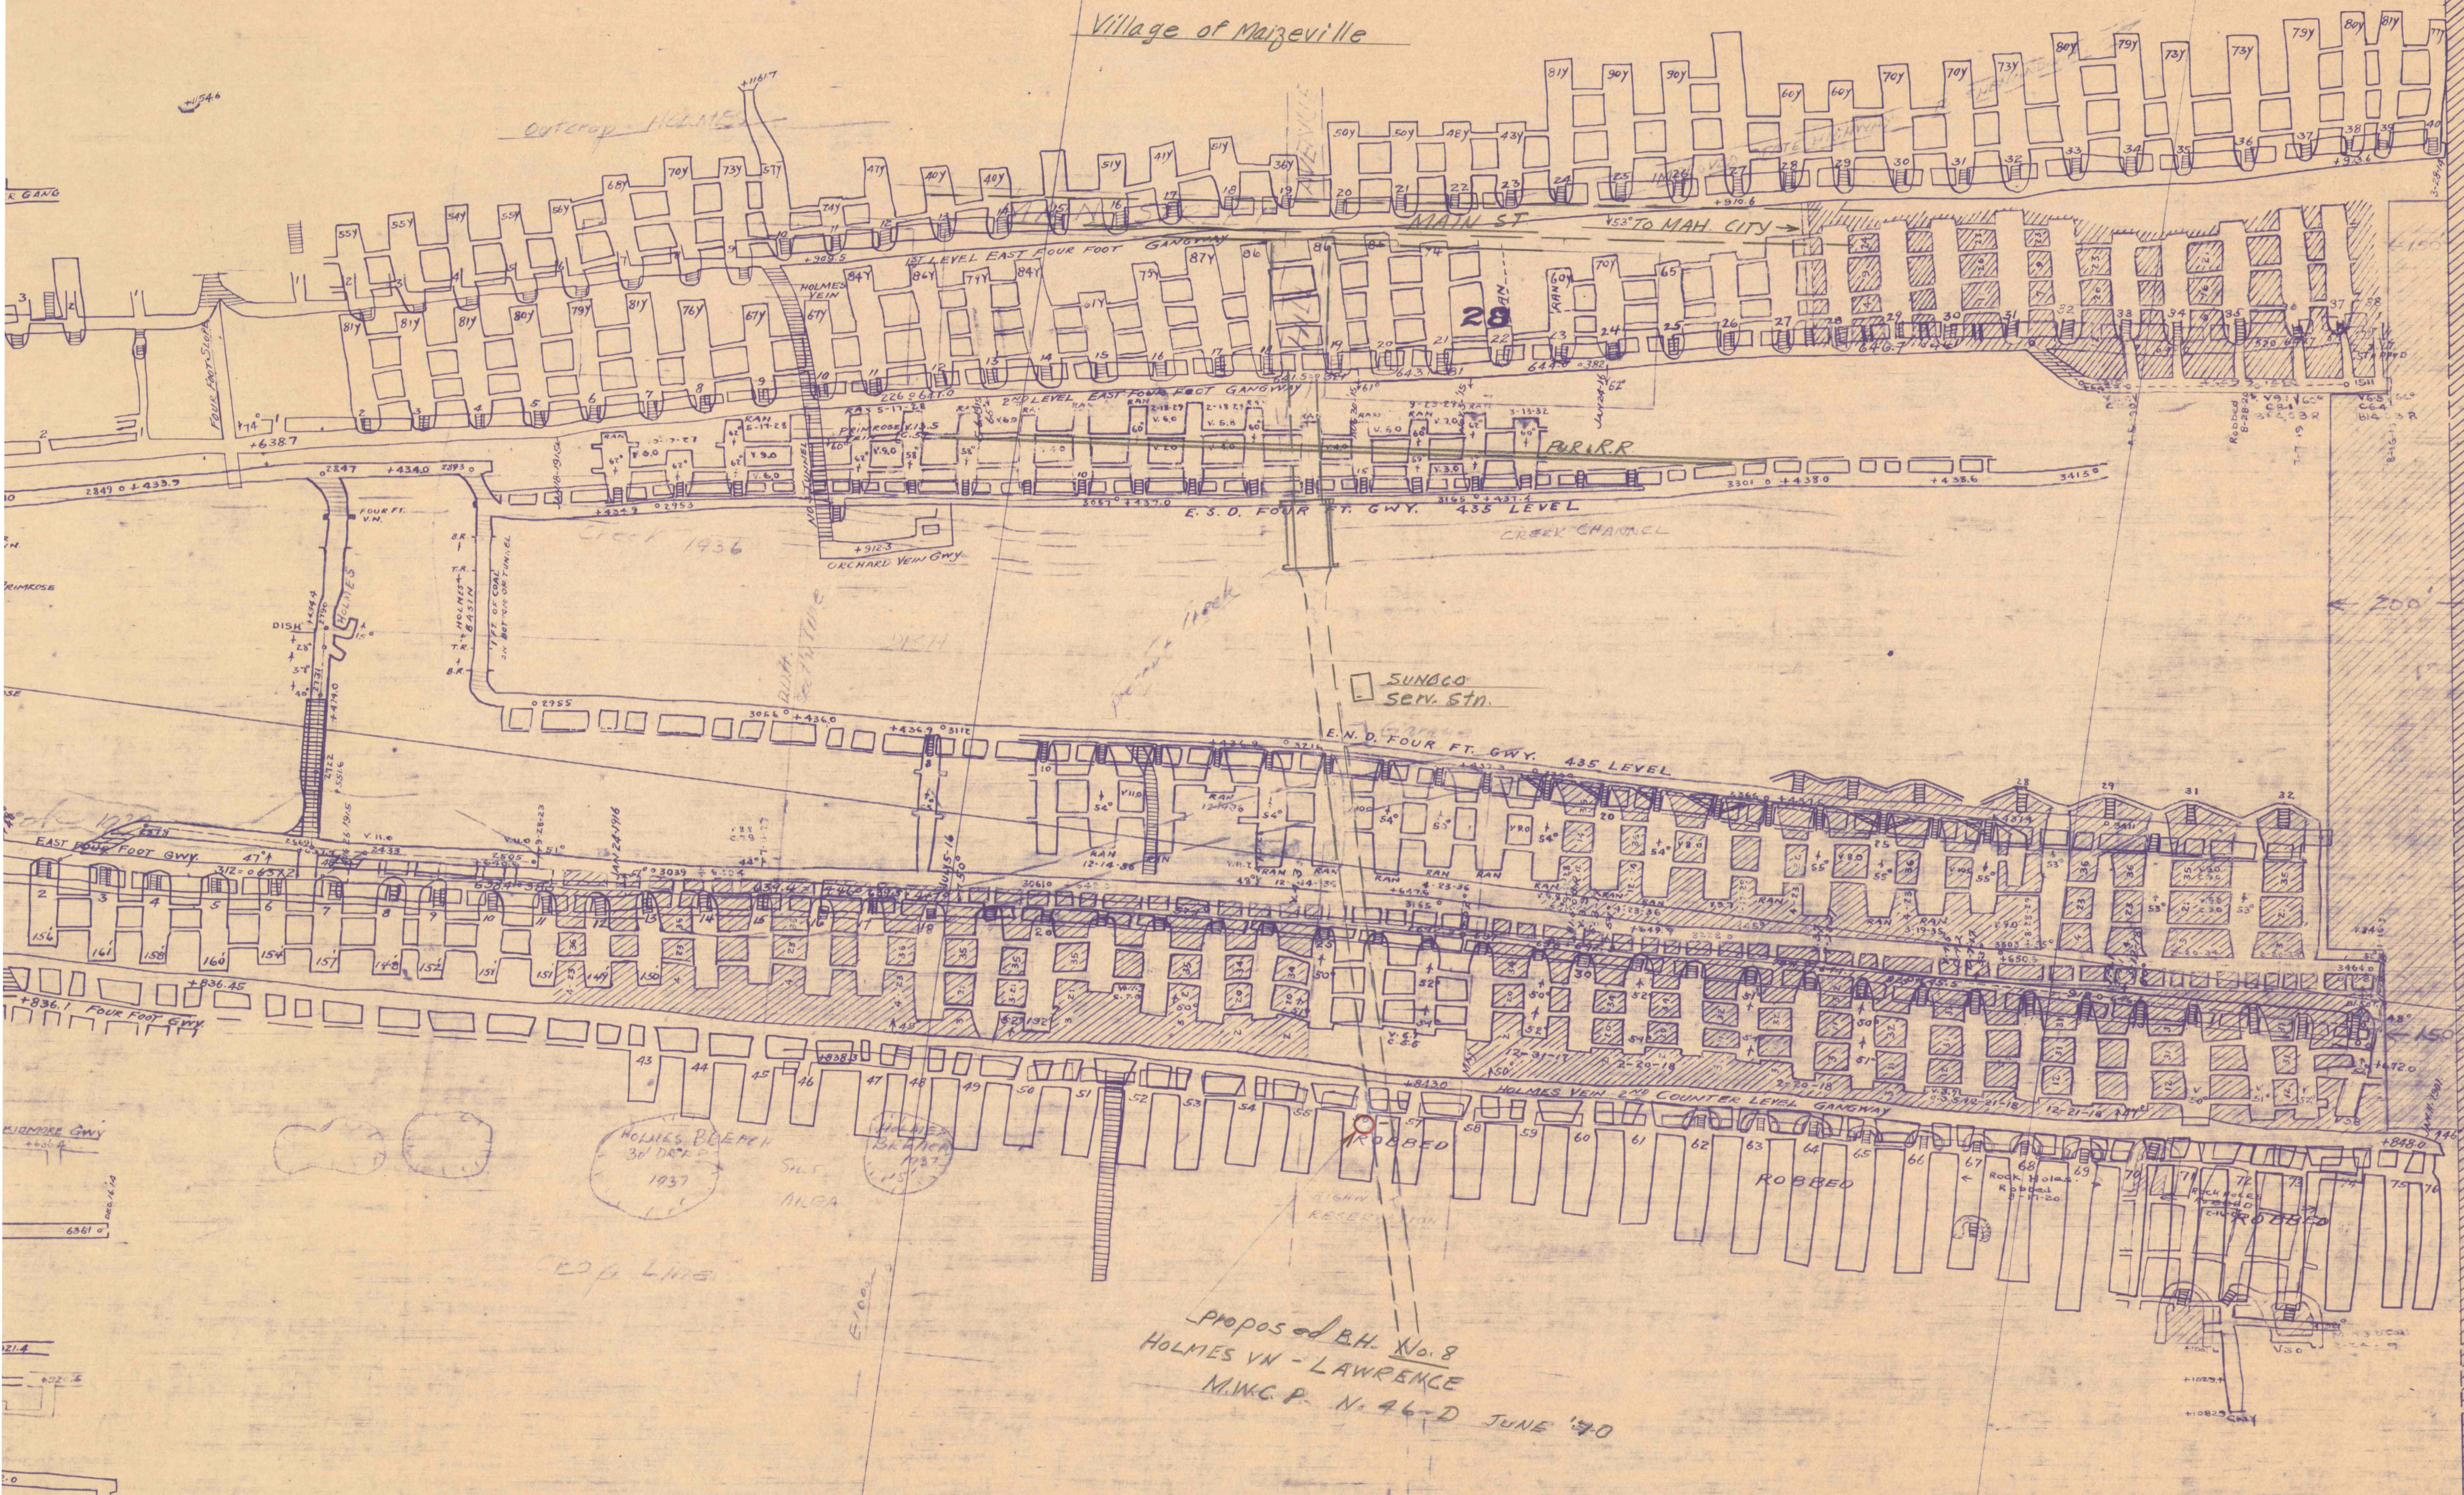

Proposed B.H. No. 8  
 HOLMES VN - LAWRENCE  
 M.W.C.P. No. 46-D JUNE '70

MOLMES BLEEK  
 30 DEC 1937

ROBBED

ROBBED

ROBBED

ROBBED

BARBER PILLAR

CRIP LINDS

OLD HIGHWAY TO CHERRY