


Looking N

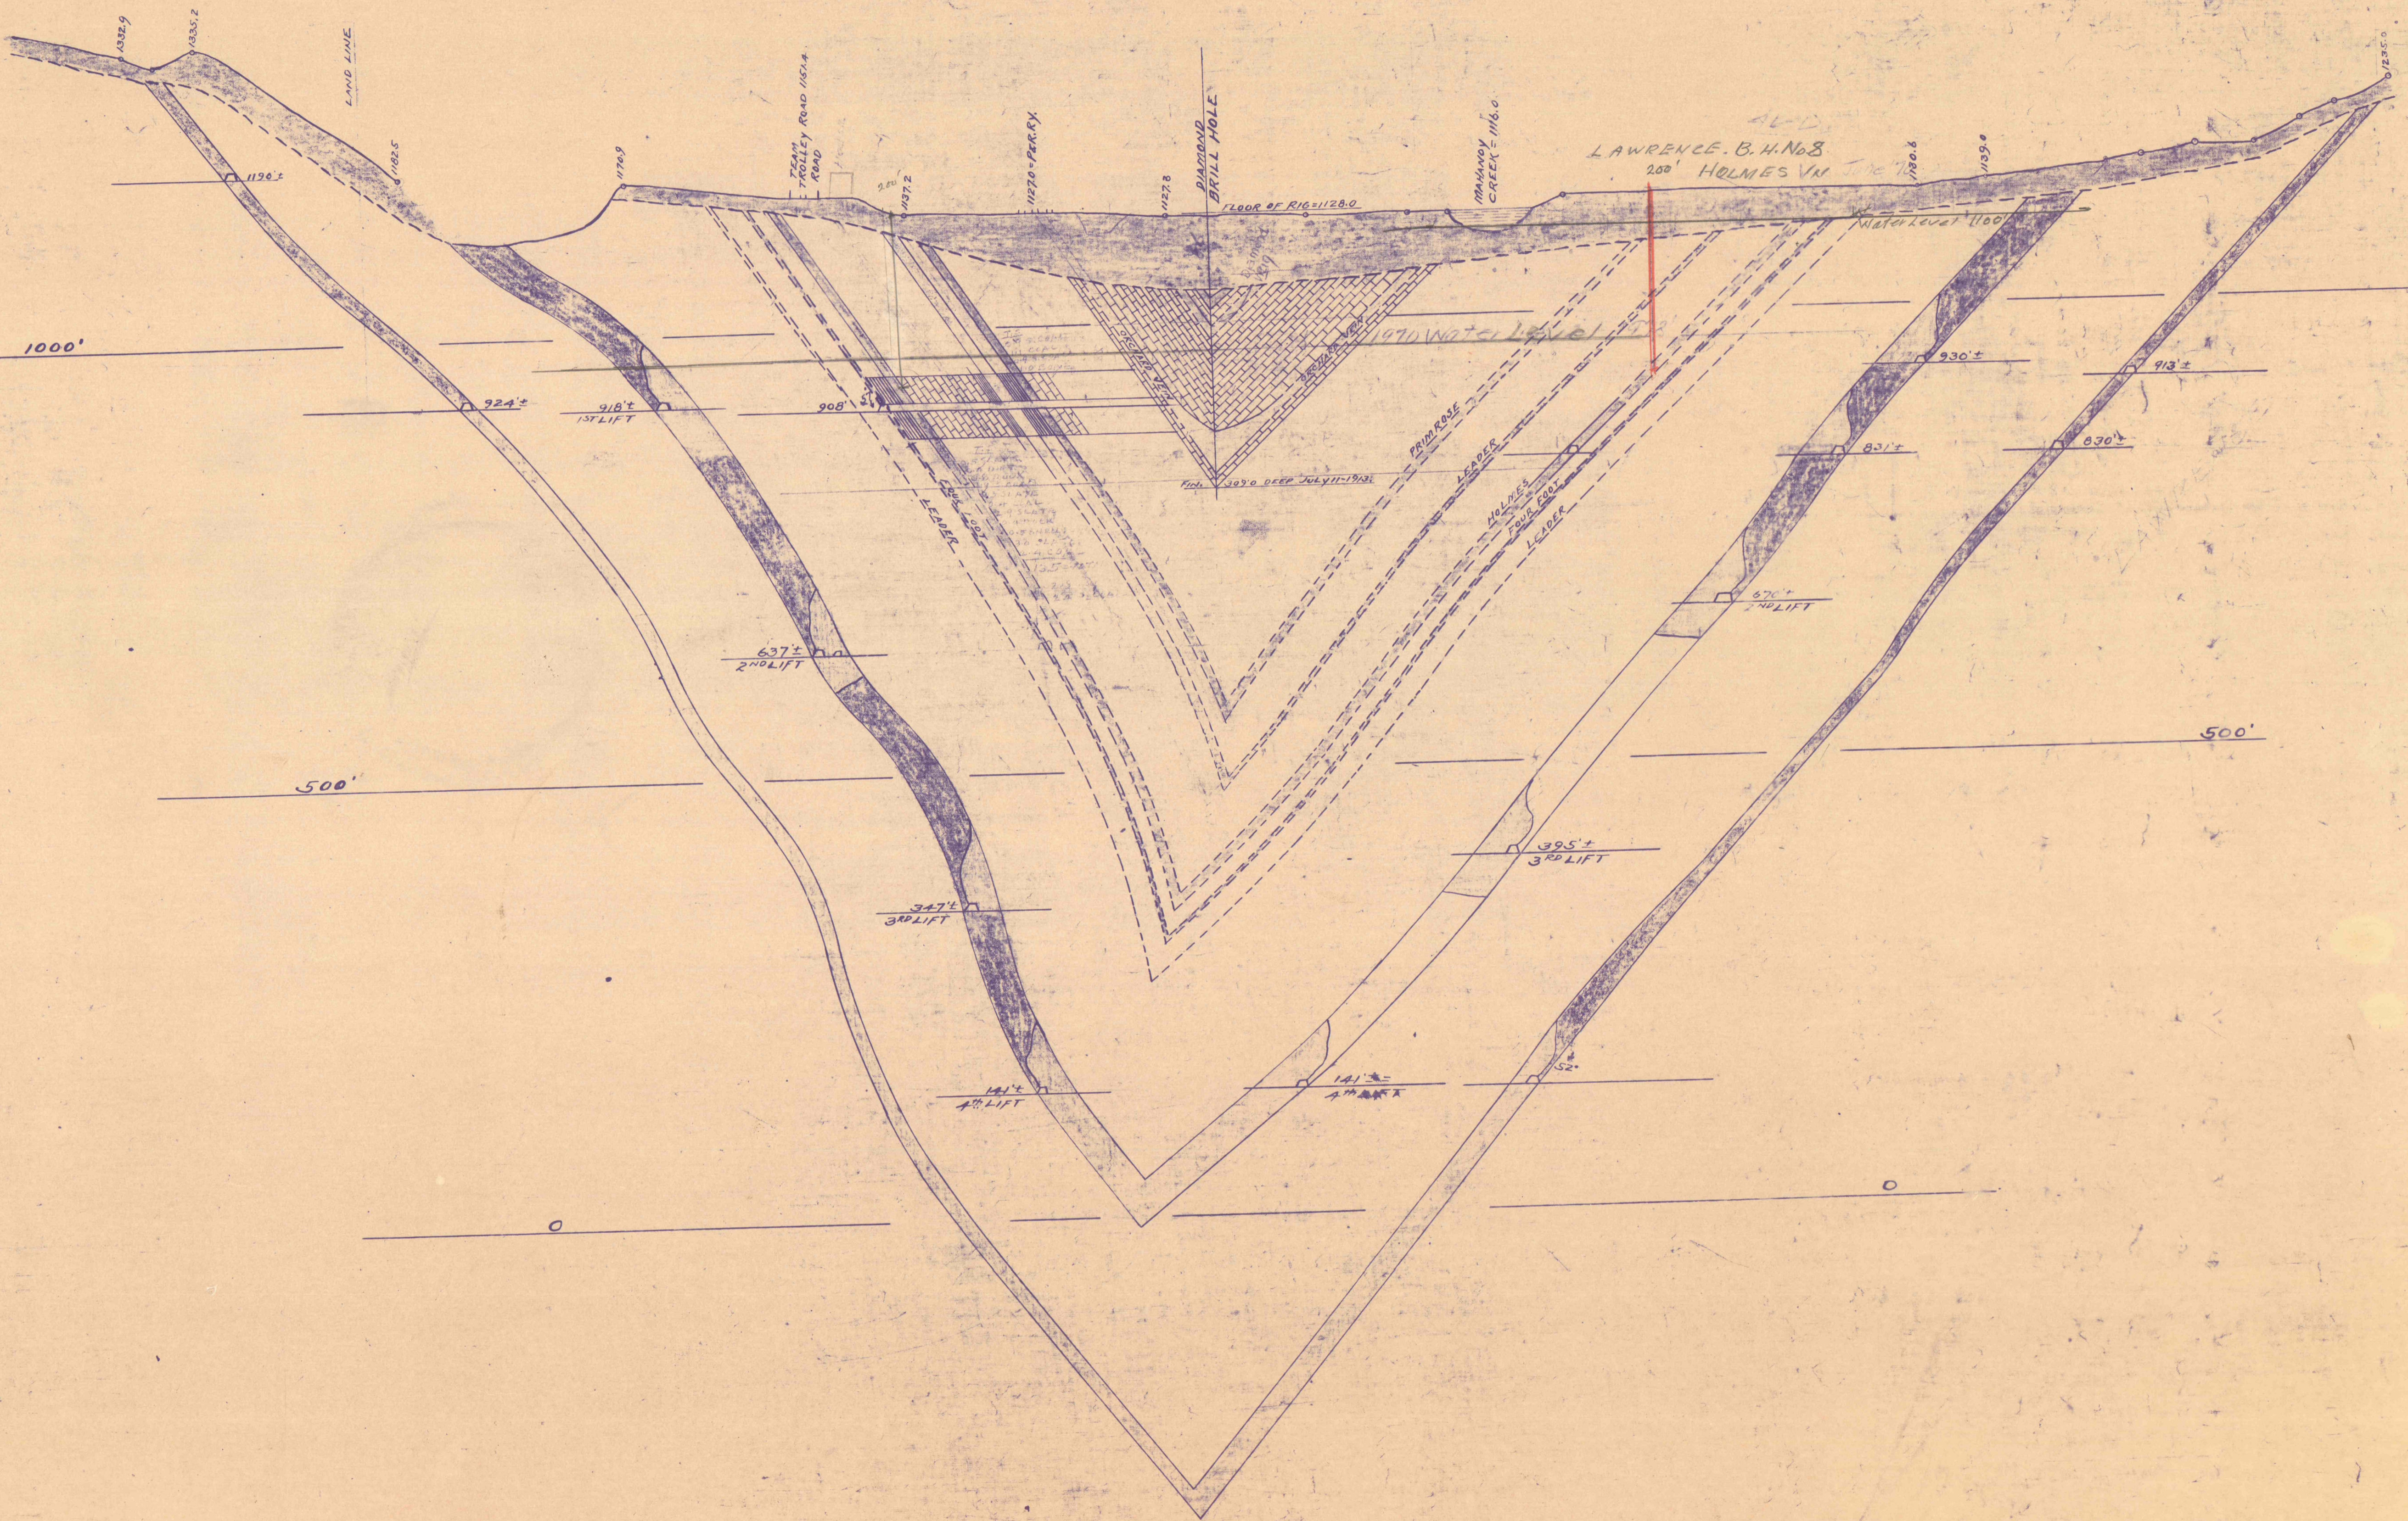

1021