OUTCROP OF LOWEST WORKABLE BED
SIBLEY
PYNE
HYDE PARK
CAPOUSE
STORRS
CAYUGA
JERMYN
TAYLOR
DIAMOND
MARVINE
OLD FORGE
BAKER
BROADWELL
GREENWOOD
NATIONAL
PINE BROOK
GREEN RIDGE
MARVINE
UNDERWOOD
No 5 SHAFT
No 1 SHAFT
LEGEND
BARRIER PILLARS
EXISTING POOLS OF WATER
SCALE IN FEET

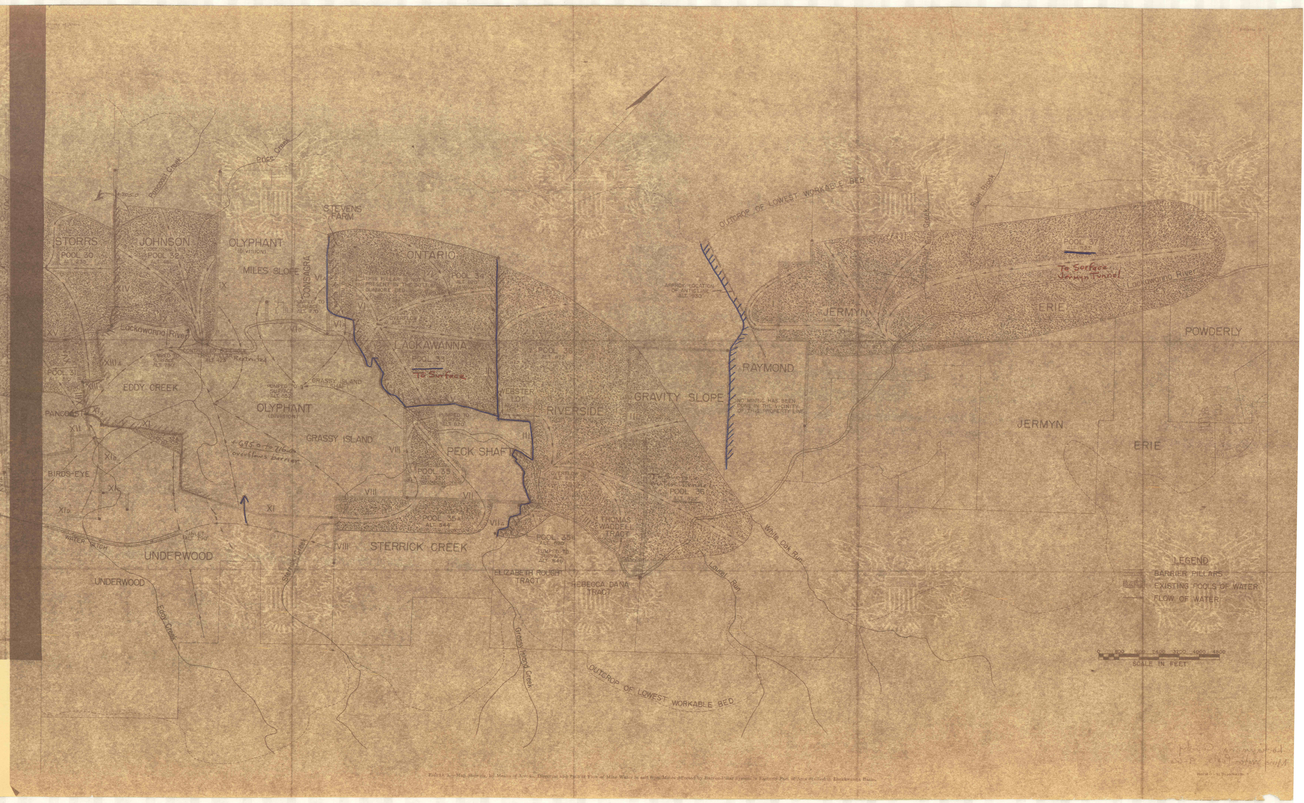
STORRS
JOHNSON
OLYPHANT
ONTARIO
MILES SLOPE
LACKAWANNA
EDDY CREEK
OLYPHANT
GRASSY ISLAND
PECK SHAFT
RIVERSIDE
GRAVITY SLOPE
RAYMOND
JERMYN
ERIE
POWDERLY
JERMYN
ERIE
UNDERWOOD
STERRICK CREEK
UNDERWOOD
OUTCROP OF LOWEST WORKABLE BED
LEGEND
BARRIER PILLARS
EXISTING POOLS OF WATER
FLOW OF WATER
SCALE IN FEET