


Area 1 - Deleted
 Area = 4P% of
 full area (clear & grub)

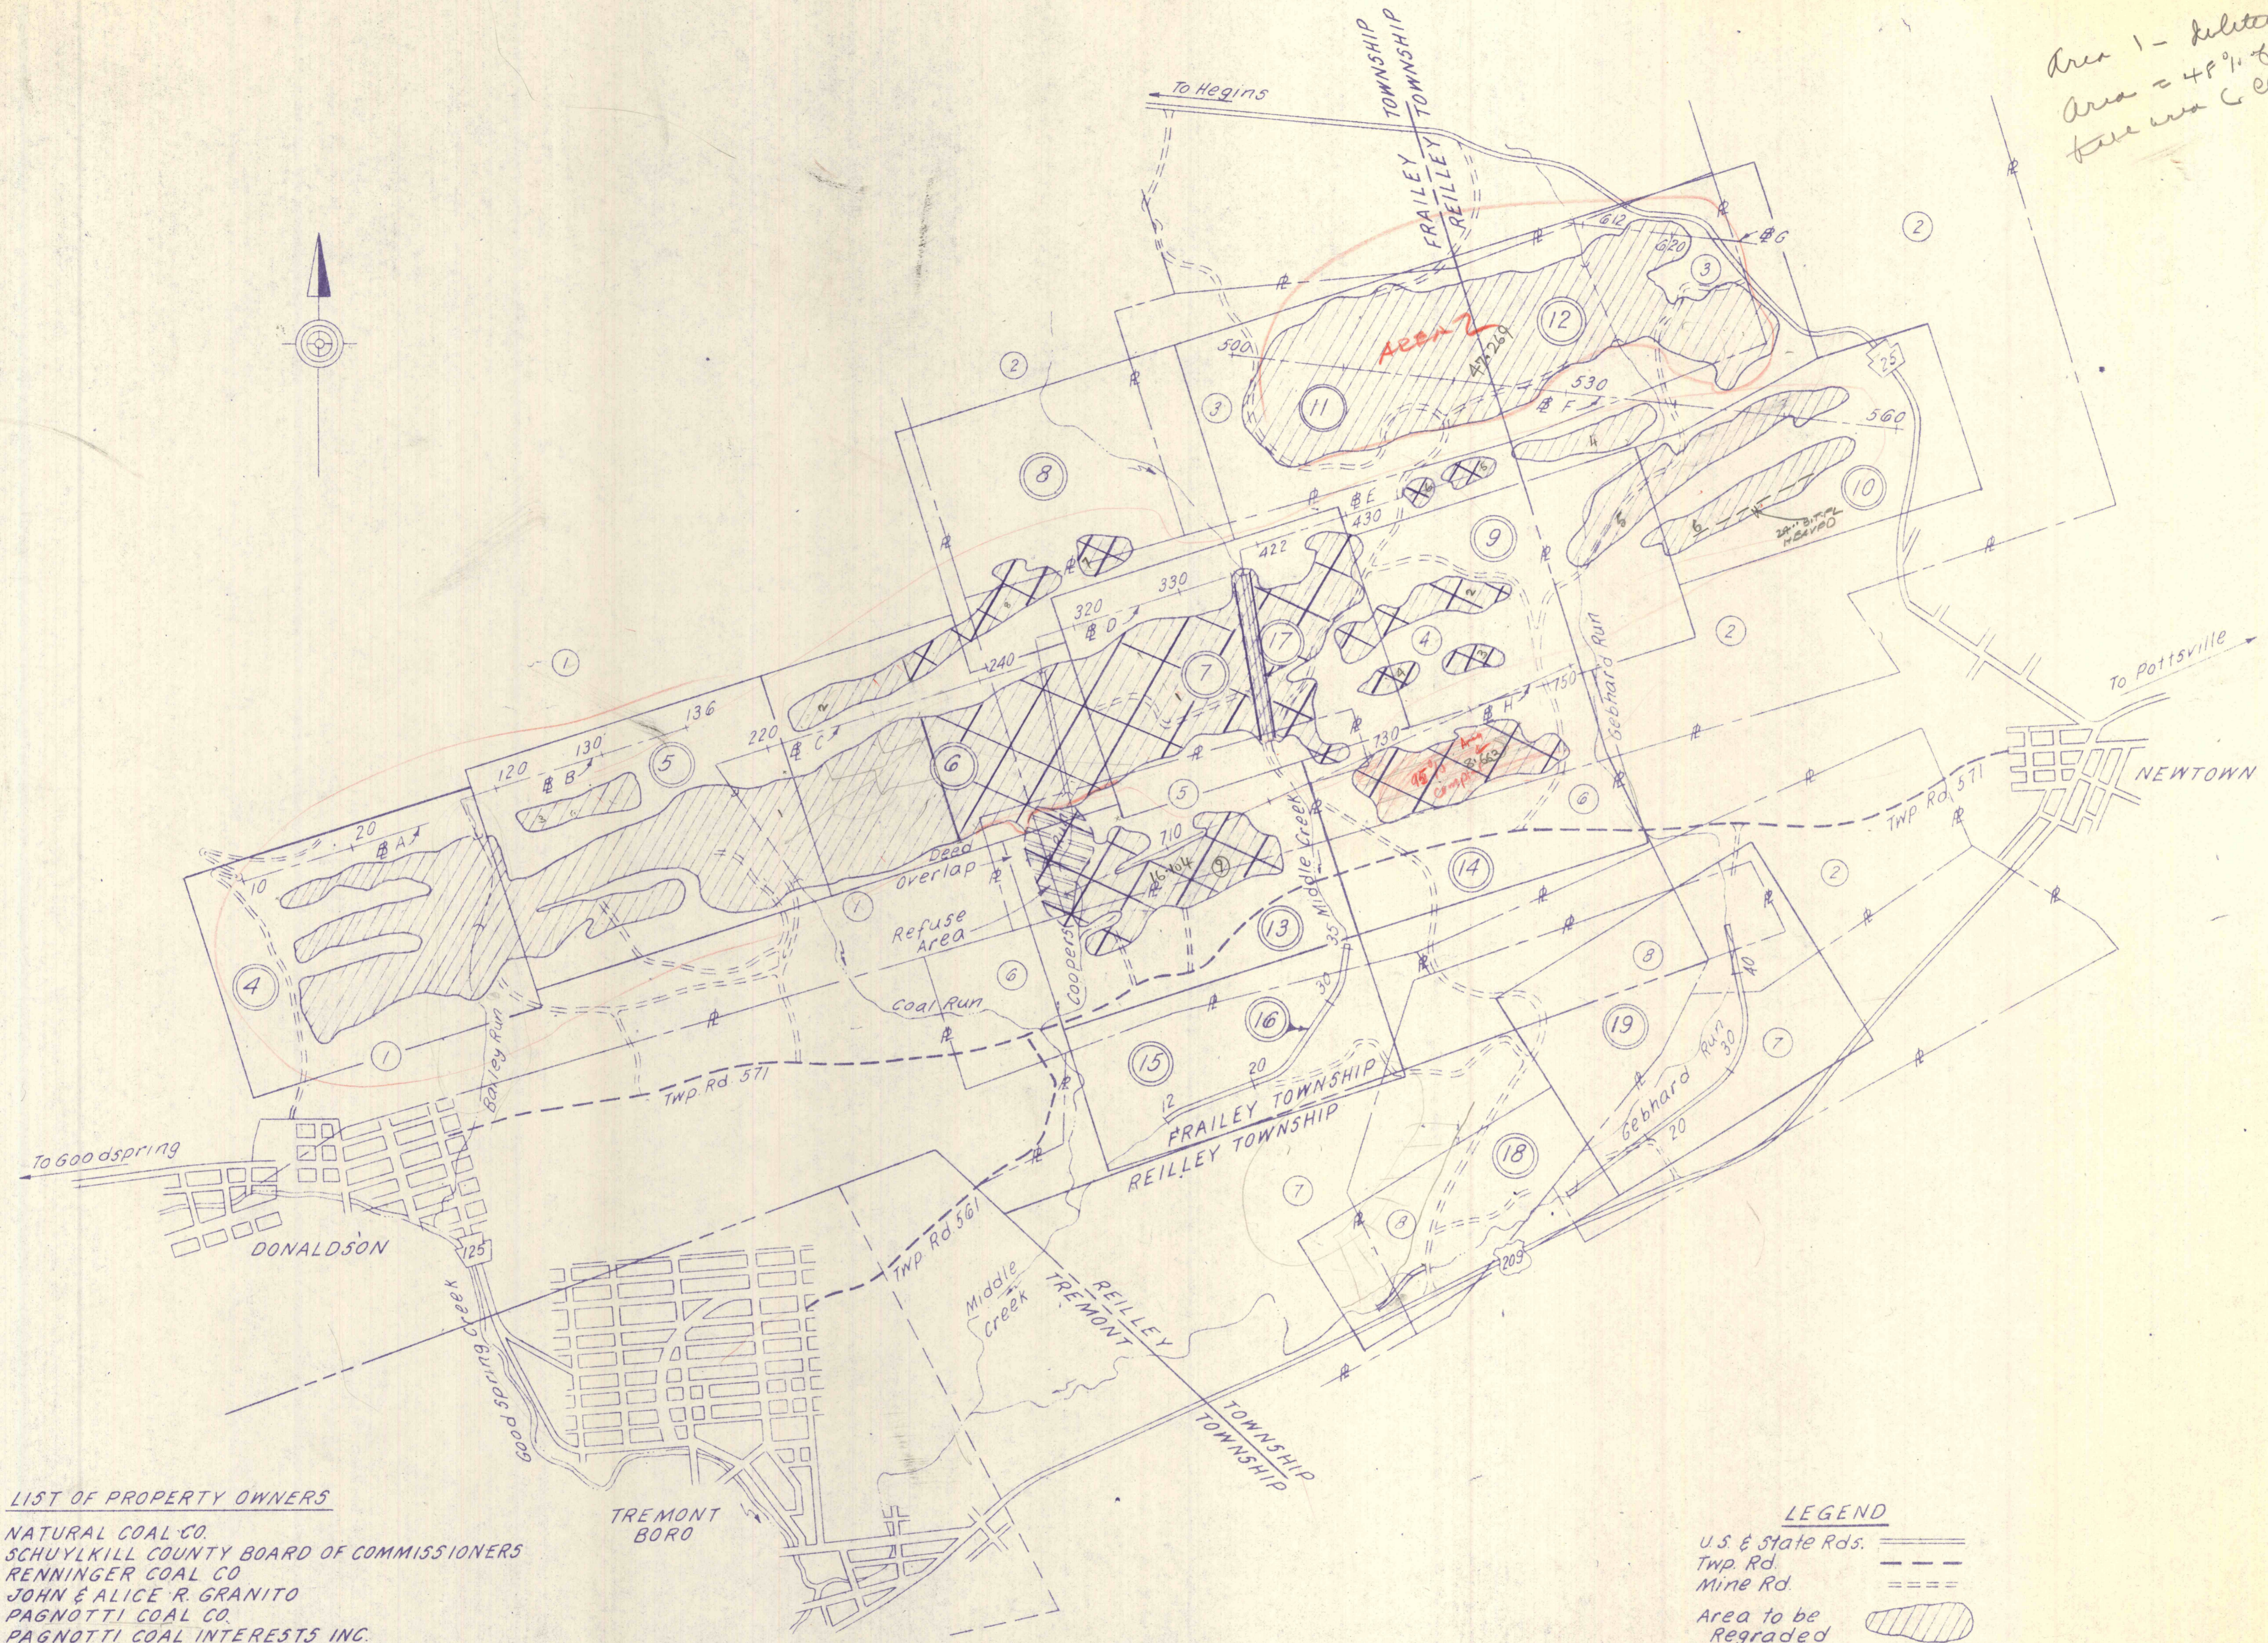

- LIST OF PROPERTY OWNERS
- ① NATURAL COAL CO.
 - ② SCHUYLKILL COUNTY BOARD OF COMMISSIONERS
 - ③ RENNINGER COAL CO.
 - ④ JOHN & ALICE R. GRANITO
 - ⑤ PAGNOTTI COAL CO.
 - ⑥ PAGNOTTI COAL INTERESTS INC.
 - ⑦ INDIAN HEAD COAL CO.
 - ⑧ SULLIVAN TRAIL COAL CO.

- LEGEND
- U.S. & State Rds.
 - Twp Rd.
 - Mine Rd.
 - Area to be Regraded
 - Plan sheet
 - Property Owner

Deleted Portions of
 Project SL 126-2-7

NO	DATE	REVISION	APPR.
SUBMITTED <i>Norma S. Munkler</i>			
PROFESSIONAL			
APPROVED <i>Robert A. Pannone</i>			
CHIEF - DIVISION OF MINE DRAINAGE REHABILITATION			
APPROVED <i>John P. Pannone</i>			
DIRECTOR - BUREAU OF CONSULTING SERVICES			
COMMONWEALTH OF PENNSYLVANIA DEPARTMENT OF ENVIRONMENTAL RESOURCES OFFICE OF ENGINEERING AND CONSTRUCTION			
PROJECT NO. SL-126-2-7			
MINE DRAINAGE POLLUTION ABATEMENT SWATARA CREEK WATERSHED SCHUYLKILL COUNTY			
BERGER ASSOCIATES, INC. Consulting Engineers P.O. Box 1943 Harrisburg			
INDEX MAP			
DRAWN BY W. G.	DATE APR. 17, 1973	DRAWING NO.	
CHECKED BY M. W.	SCALE 1" = 800'	3 of 4	

Revised - July 15, 1974