
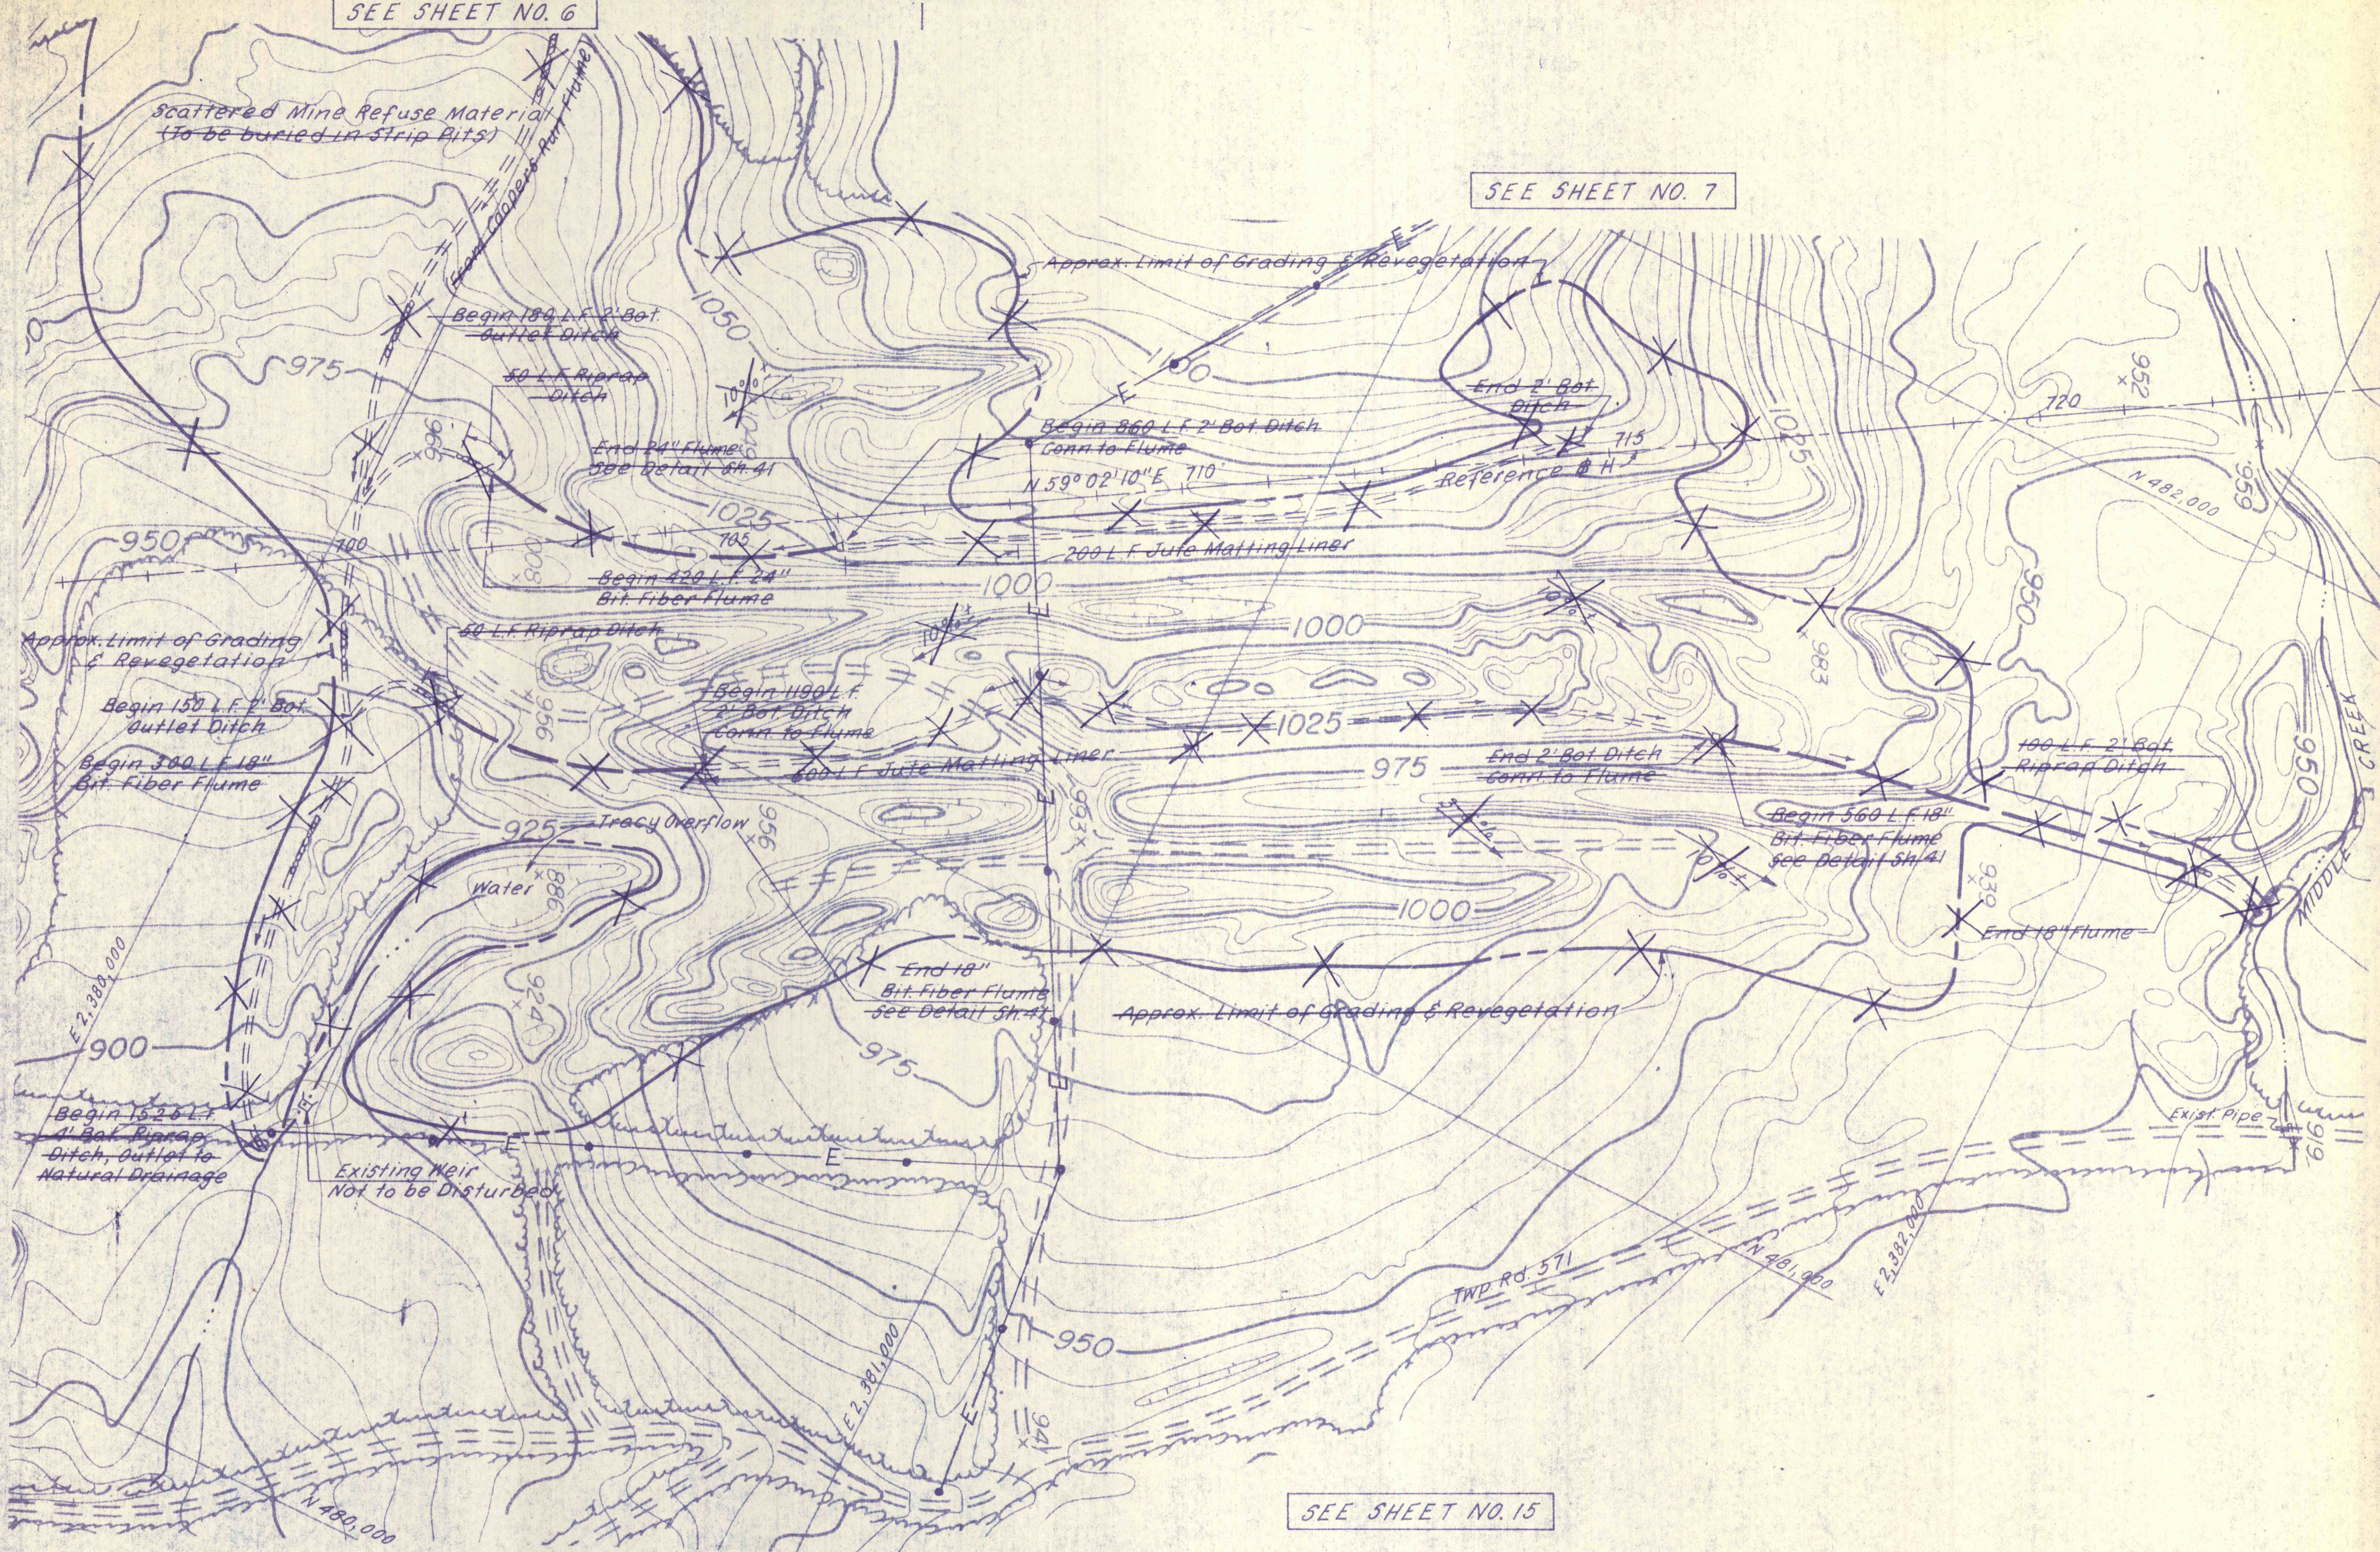


SEE SHEET NO. 6

SEE SHEET NO. 7

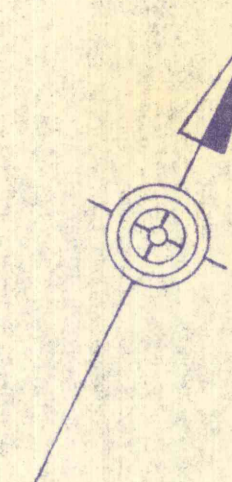

SEE SHEET NO. 14

SEE SHEET NO. 15

For Grading Sections
See Sheet Nos 36 & 37

NO	DATE	REVISION	APPR.
SUBMITTED	Norman E. Mutcher		
PROFESSIONAL			
APPROVED	Albert A. Ramey		
	CHIEF - DIVISION OF MINE DRAINAGE REHABILITATION		
APPROVED	Don Pansico		
	DIRECTOR - BUREAU OF CONSULTING SERVICES		



COMMONWEALTH OF PENNSYLVANIA
DEPARTMENT OF ENVIRONMENTAL RESOURCES
OFFICE OF ENGINEERING AND CONSTRUCTION

PROJECT NO. SL-126-2-7

MINE DRAINAGE
POLLUTION ABATEMENT
SWATARA CREEK WATERSHED
SCHUYLKILL COUNTY

BERGER ASSOCIATES, INC.
Consulting Engineers

P.O. Box 1943 Harrisburg, Penna.

PLAN STRIP MINE RECLAMATION

DRAWN BY W. G.	DATE APR. 17, 1973	DRAWING NO. 13 of 43
CHECKED BY T. T.	SCALE 1" = 100'	

Rev. 7/15/74