
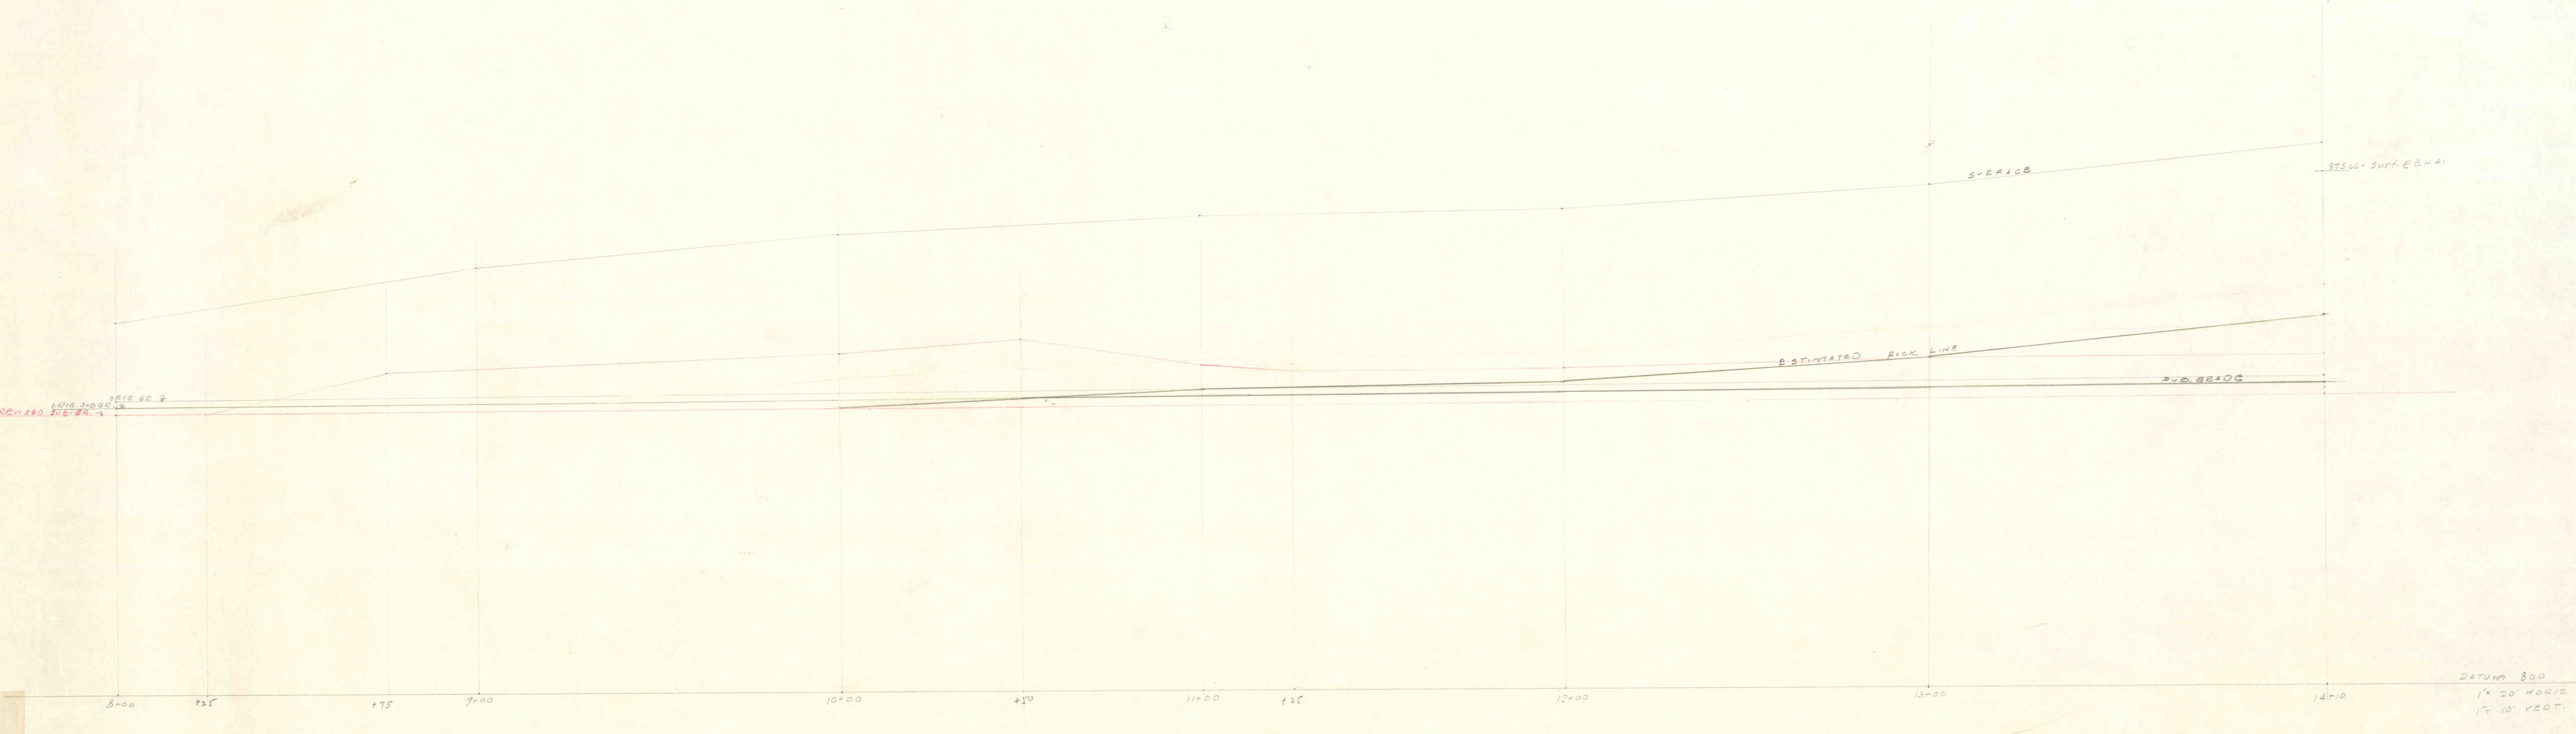
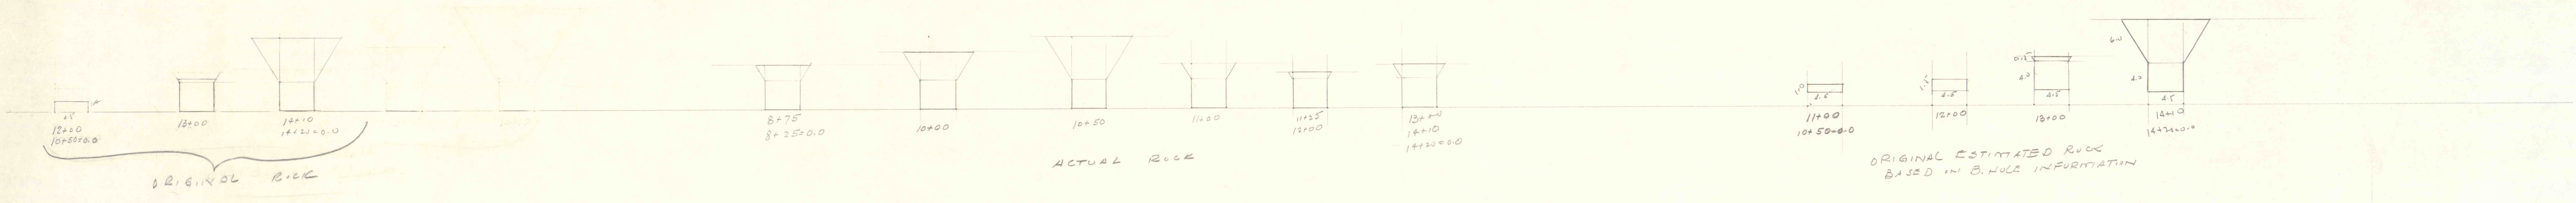


7  
1000  
1/4

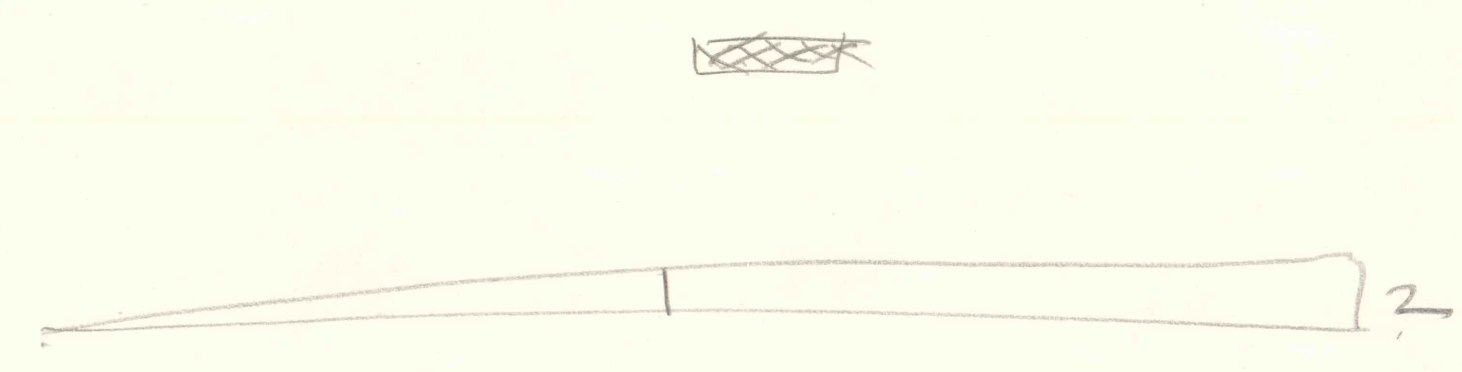

RAHSHAW - A-19-B  
DITCH FOR 24" R.C.C. PIPE