


HUDSON COAL CO. OLYPHANT, PA.
 OLYPHANT COLLYERY No 1 BED - WINE INSPECTOR'S
 NORTHERN COAL FIELD, LACKAWANNA COUNTY

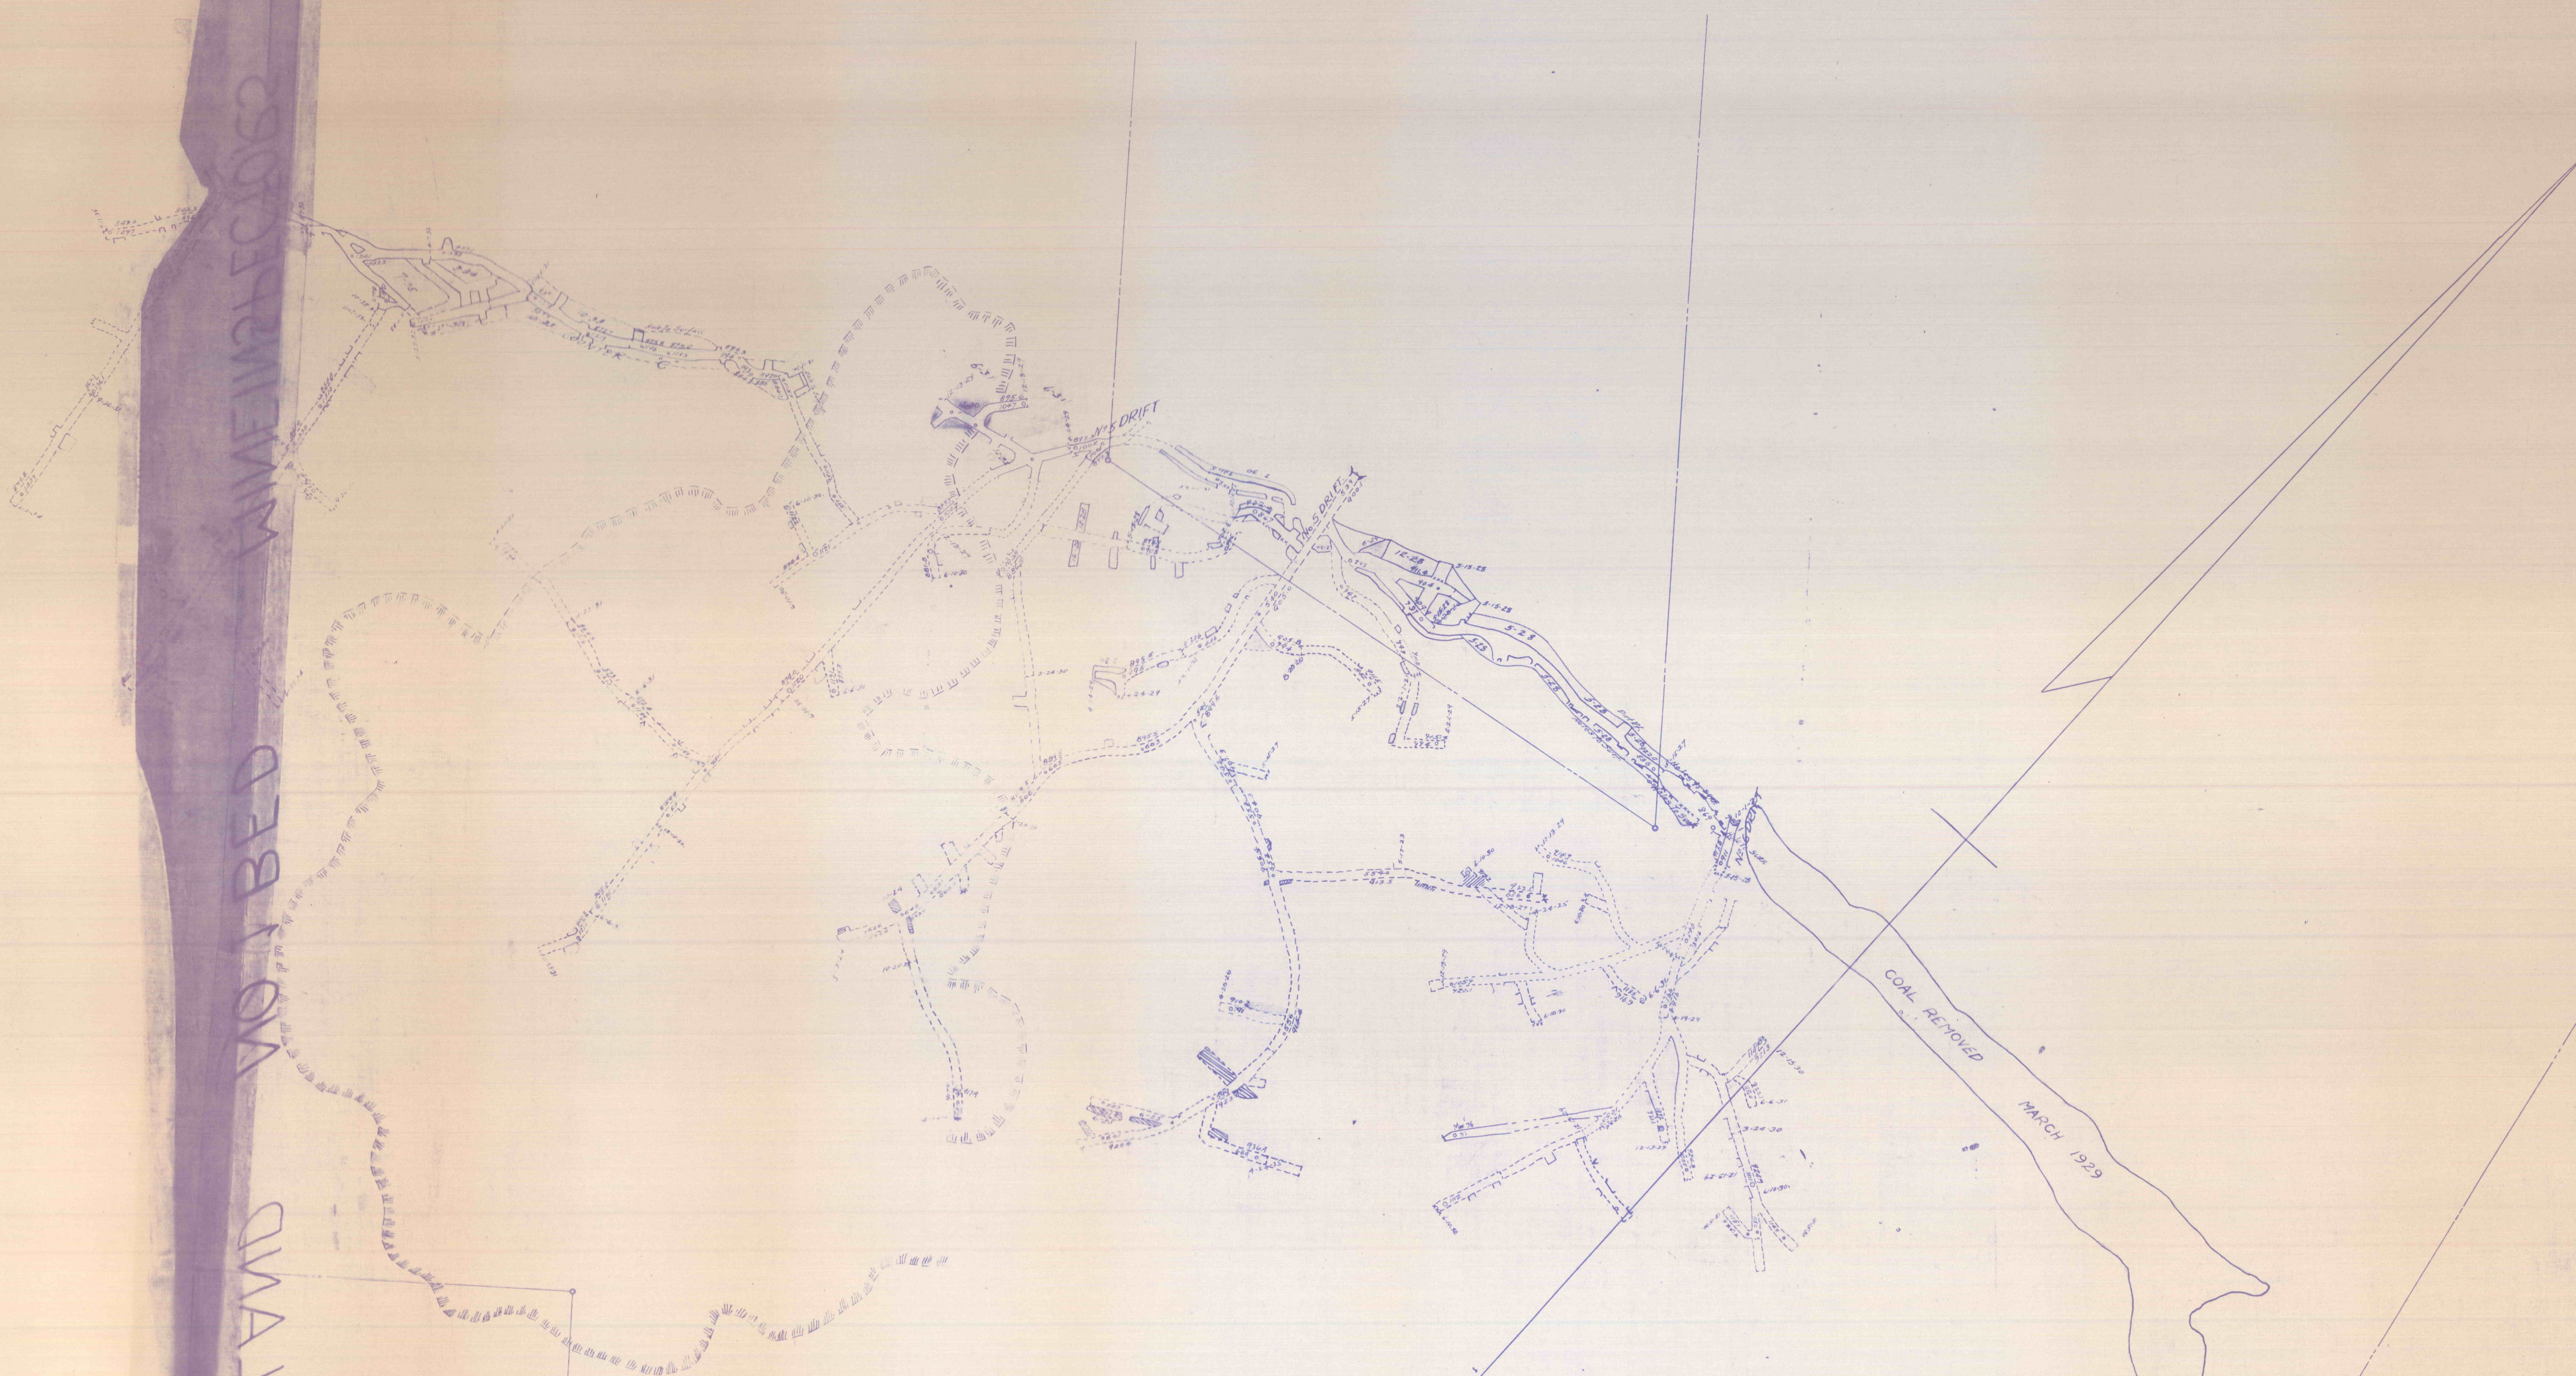

DATE OF POSTING	DATE OF ROBBING
APRIL 24 - 1925	APRIL 24 1925
FEB. 1926	FEB. 1926
OCT. 1926	

NORTHERN COAL FIELD
 OLYPHANT COLLIERY
GRASSY ISLAND No. 1 BED
 MINE INSPECTOR TRACING SCALE 1" = 100'
 BLAKELY TWP., LACKAWANNA COUNTY,
 HUDSON COAL CO., OLYPHANT, PA.

WINE INSPECTOR'S
 No 1 BED
 GRASSY ISLAND

