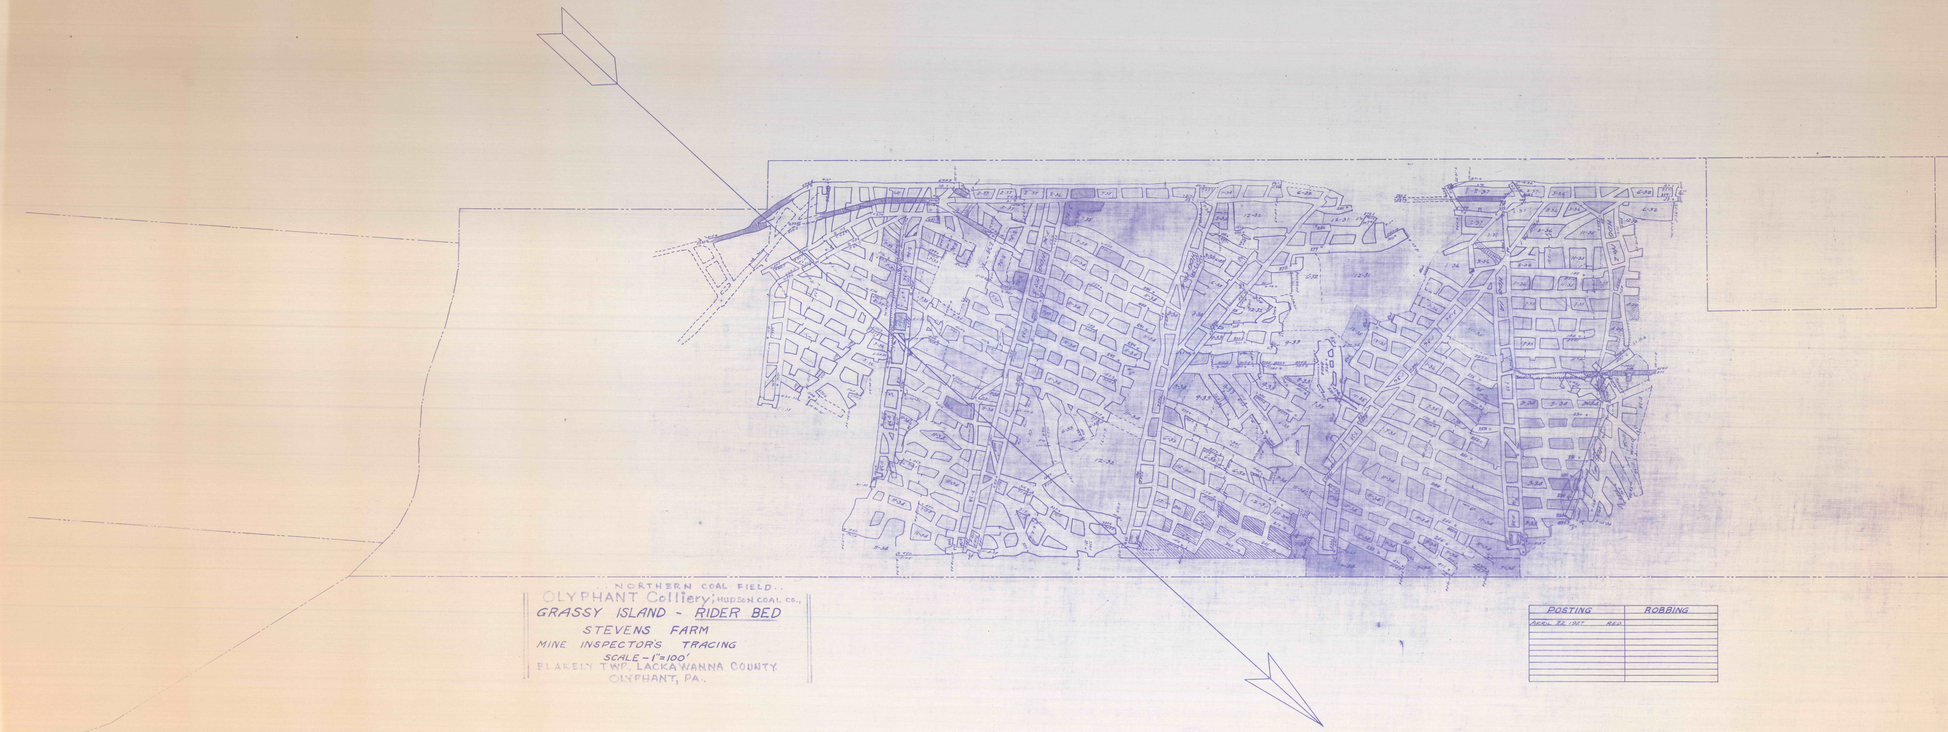

NORTHERN COAL FIELD...
OLYPHANT Colliery; HUD&SH COAL CO.,
GRASSY ISLAND - RIDER BED
STEVENS FARM
MINE INSPECTOR'S TRACING
SCALE - 1" = 100'
BLAKELY TWP., LACKAWANNA COUNTY
OLYPHANT, PA.

POSTING	ROBBING
ROOM EL. 707'	

F.3.3