



DELAWARE & HUDSON CO.

PENNA. COAL CO. EXCH. BELL LOT.

PENNA. COAL CO. SARAH BELL.

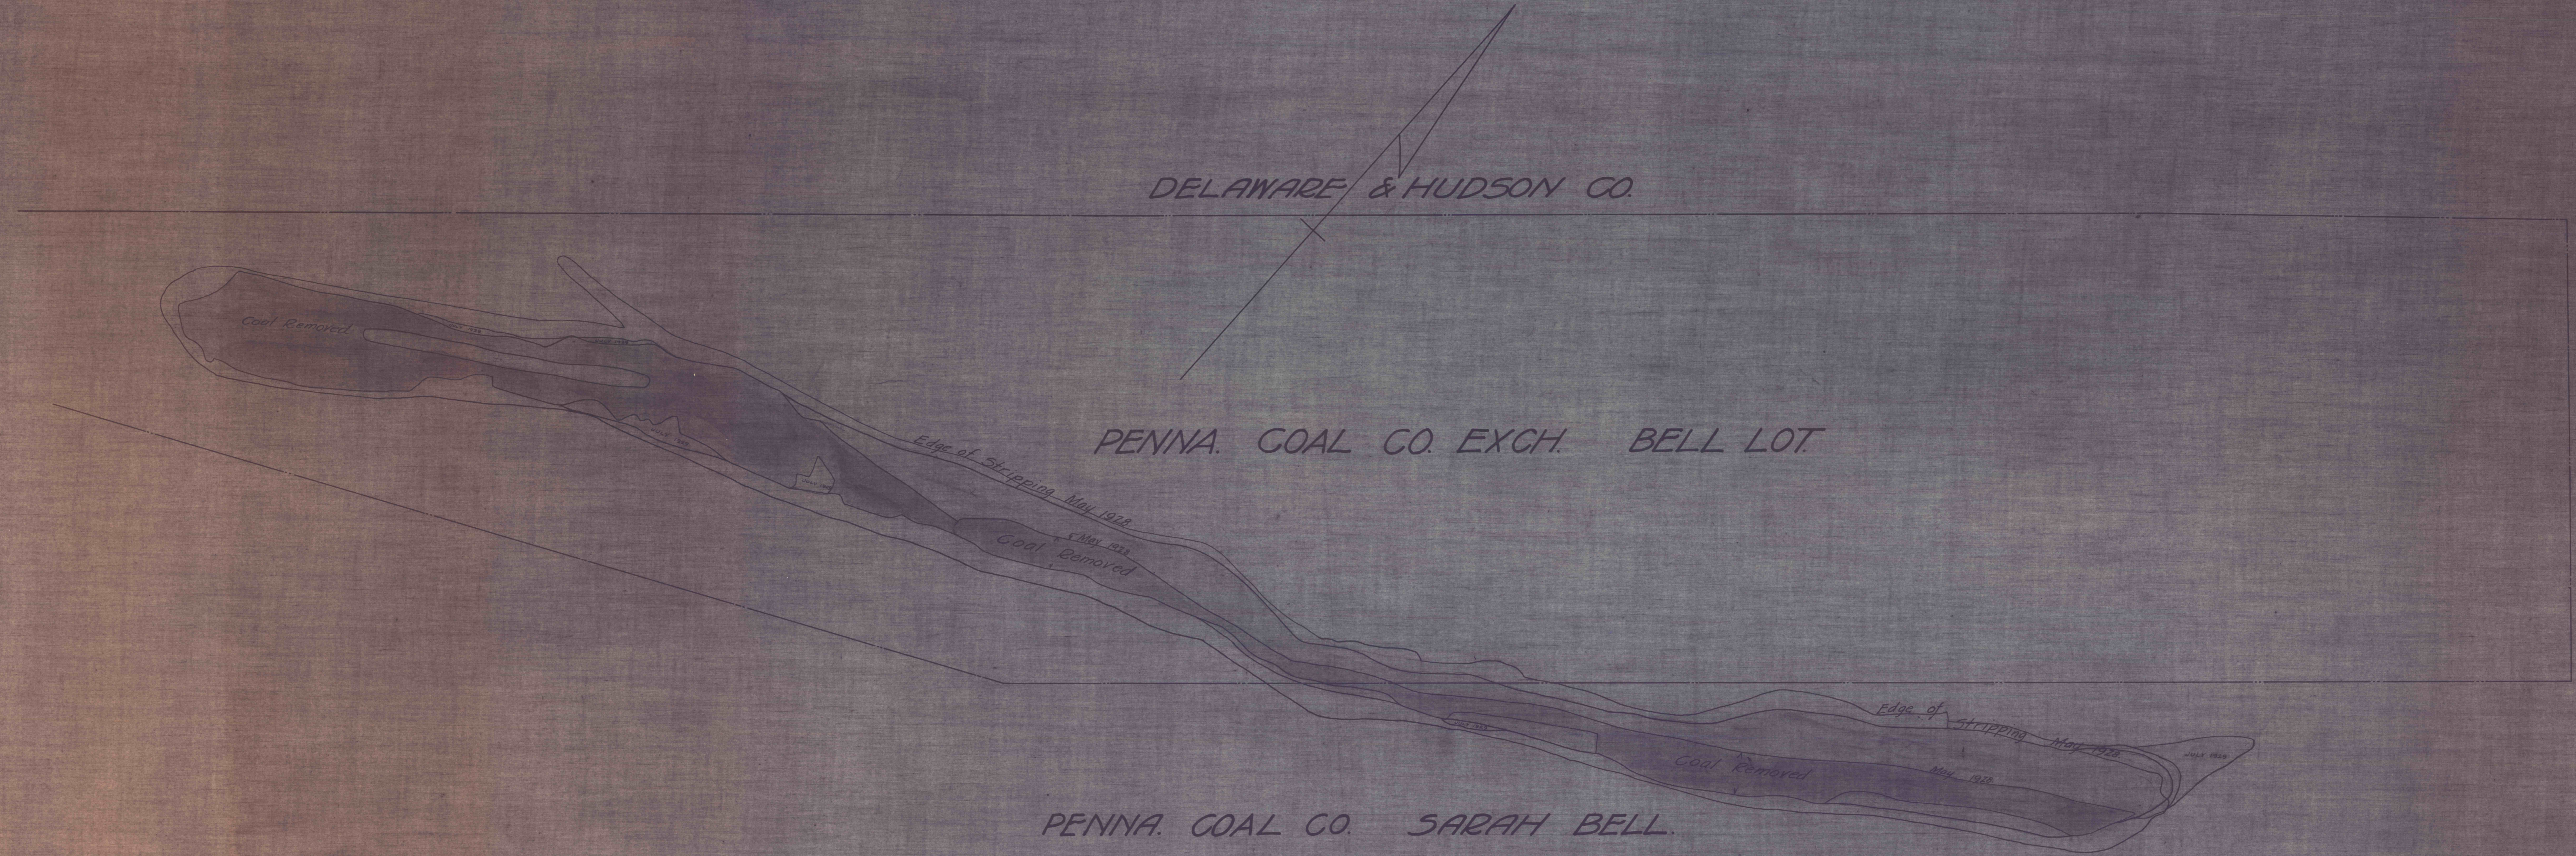

MINE INSPECTOR'S TRACING
 NORTHERN COAL FIELD
 SHOWING THE
 • FOURTEEN FOOT BED STRIPPING
 OLYPHANT COLLY BLAKELY
 TWP. LACKAWANNA
 HUDSON COAL CO. COUNTY
 SCALE 1"=100'