


CLARKSON LOT

LOT

FERRIS LOT

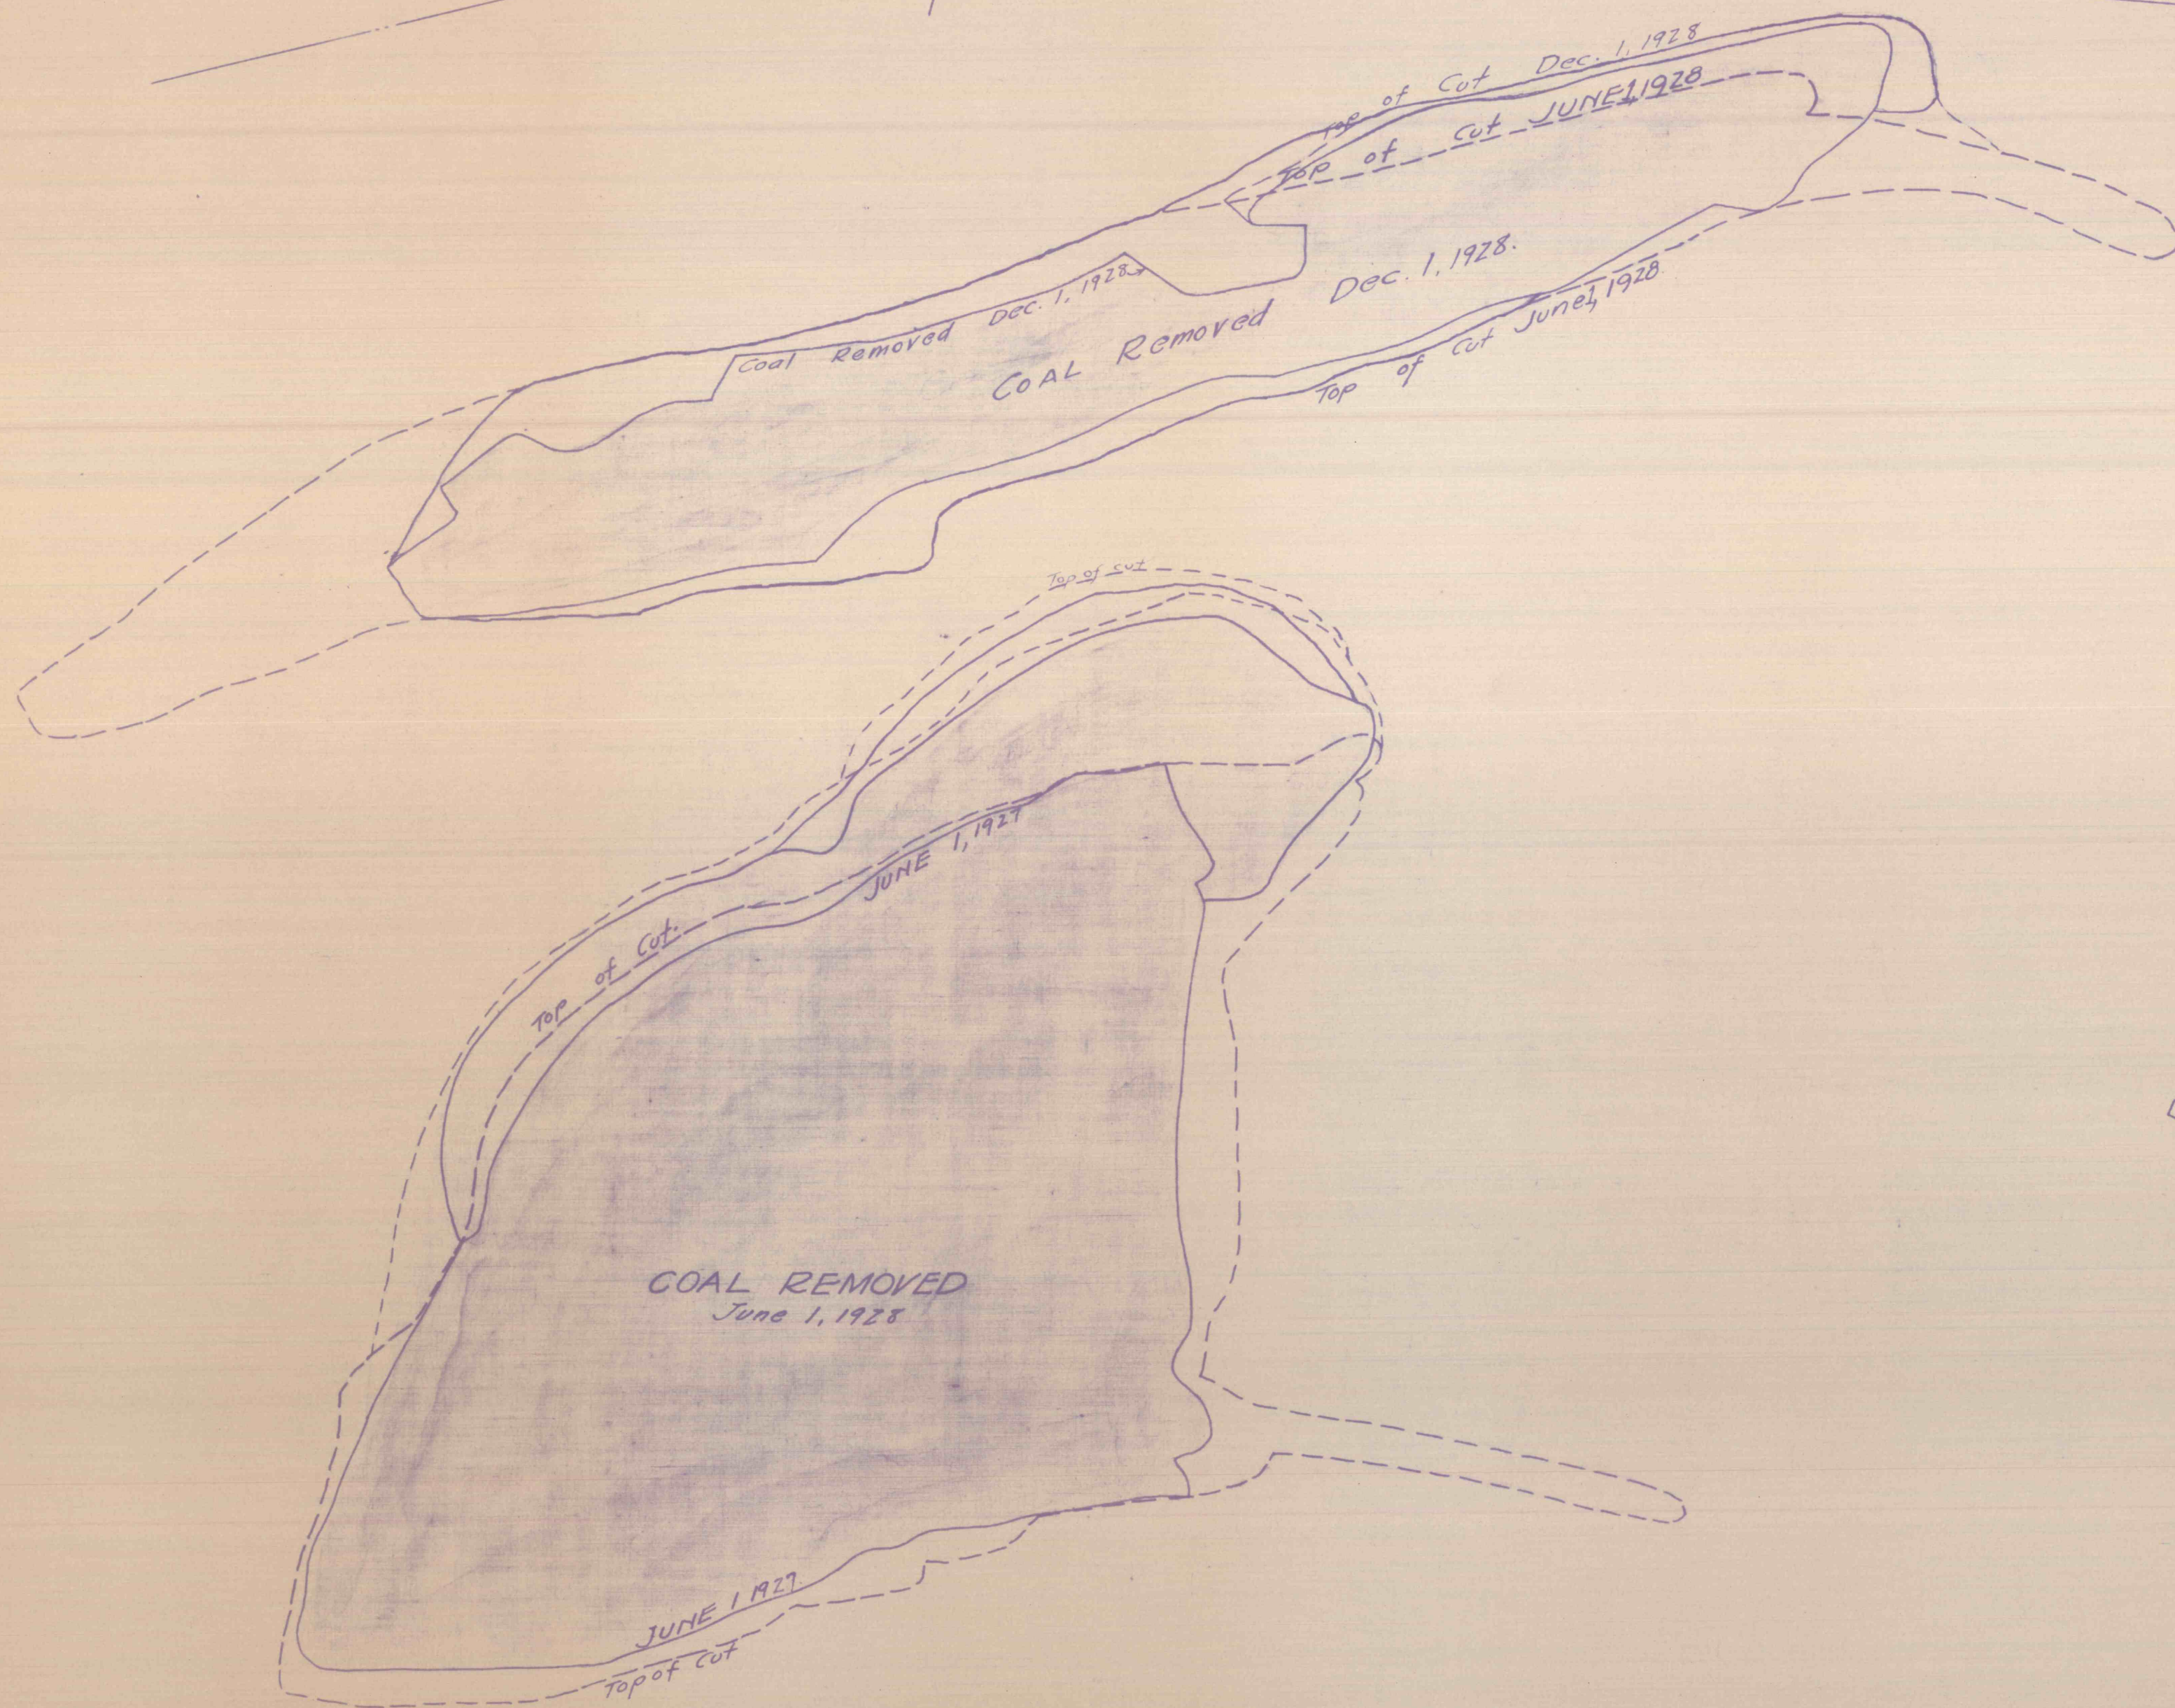

F. 3. 6

HUDSON COAL CO. OLYPHANT COLL'Y.  

F. 3. 6

MINE INSPECTOR'S TRACING  
 LACKAWANNA COUNTY, BLAKELY TWP.  
 SHOWING THE  
 NORTHERN COAL FIELD  
 NO. 2 BED STRIPPING  
 OLYPHANT COLL'Y.  
 OLYPHANT, PENNA.  
 HUDSON COAL CO.  
 Scale 1"=100'