


SEVEN FOOT VEIN
WEST BEAR RIDGE
WESTERN MIDDLE FIELD

MAR 10 1927

SPED.

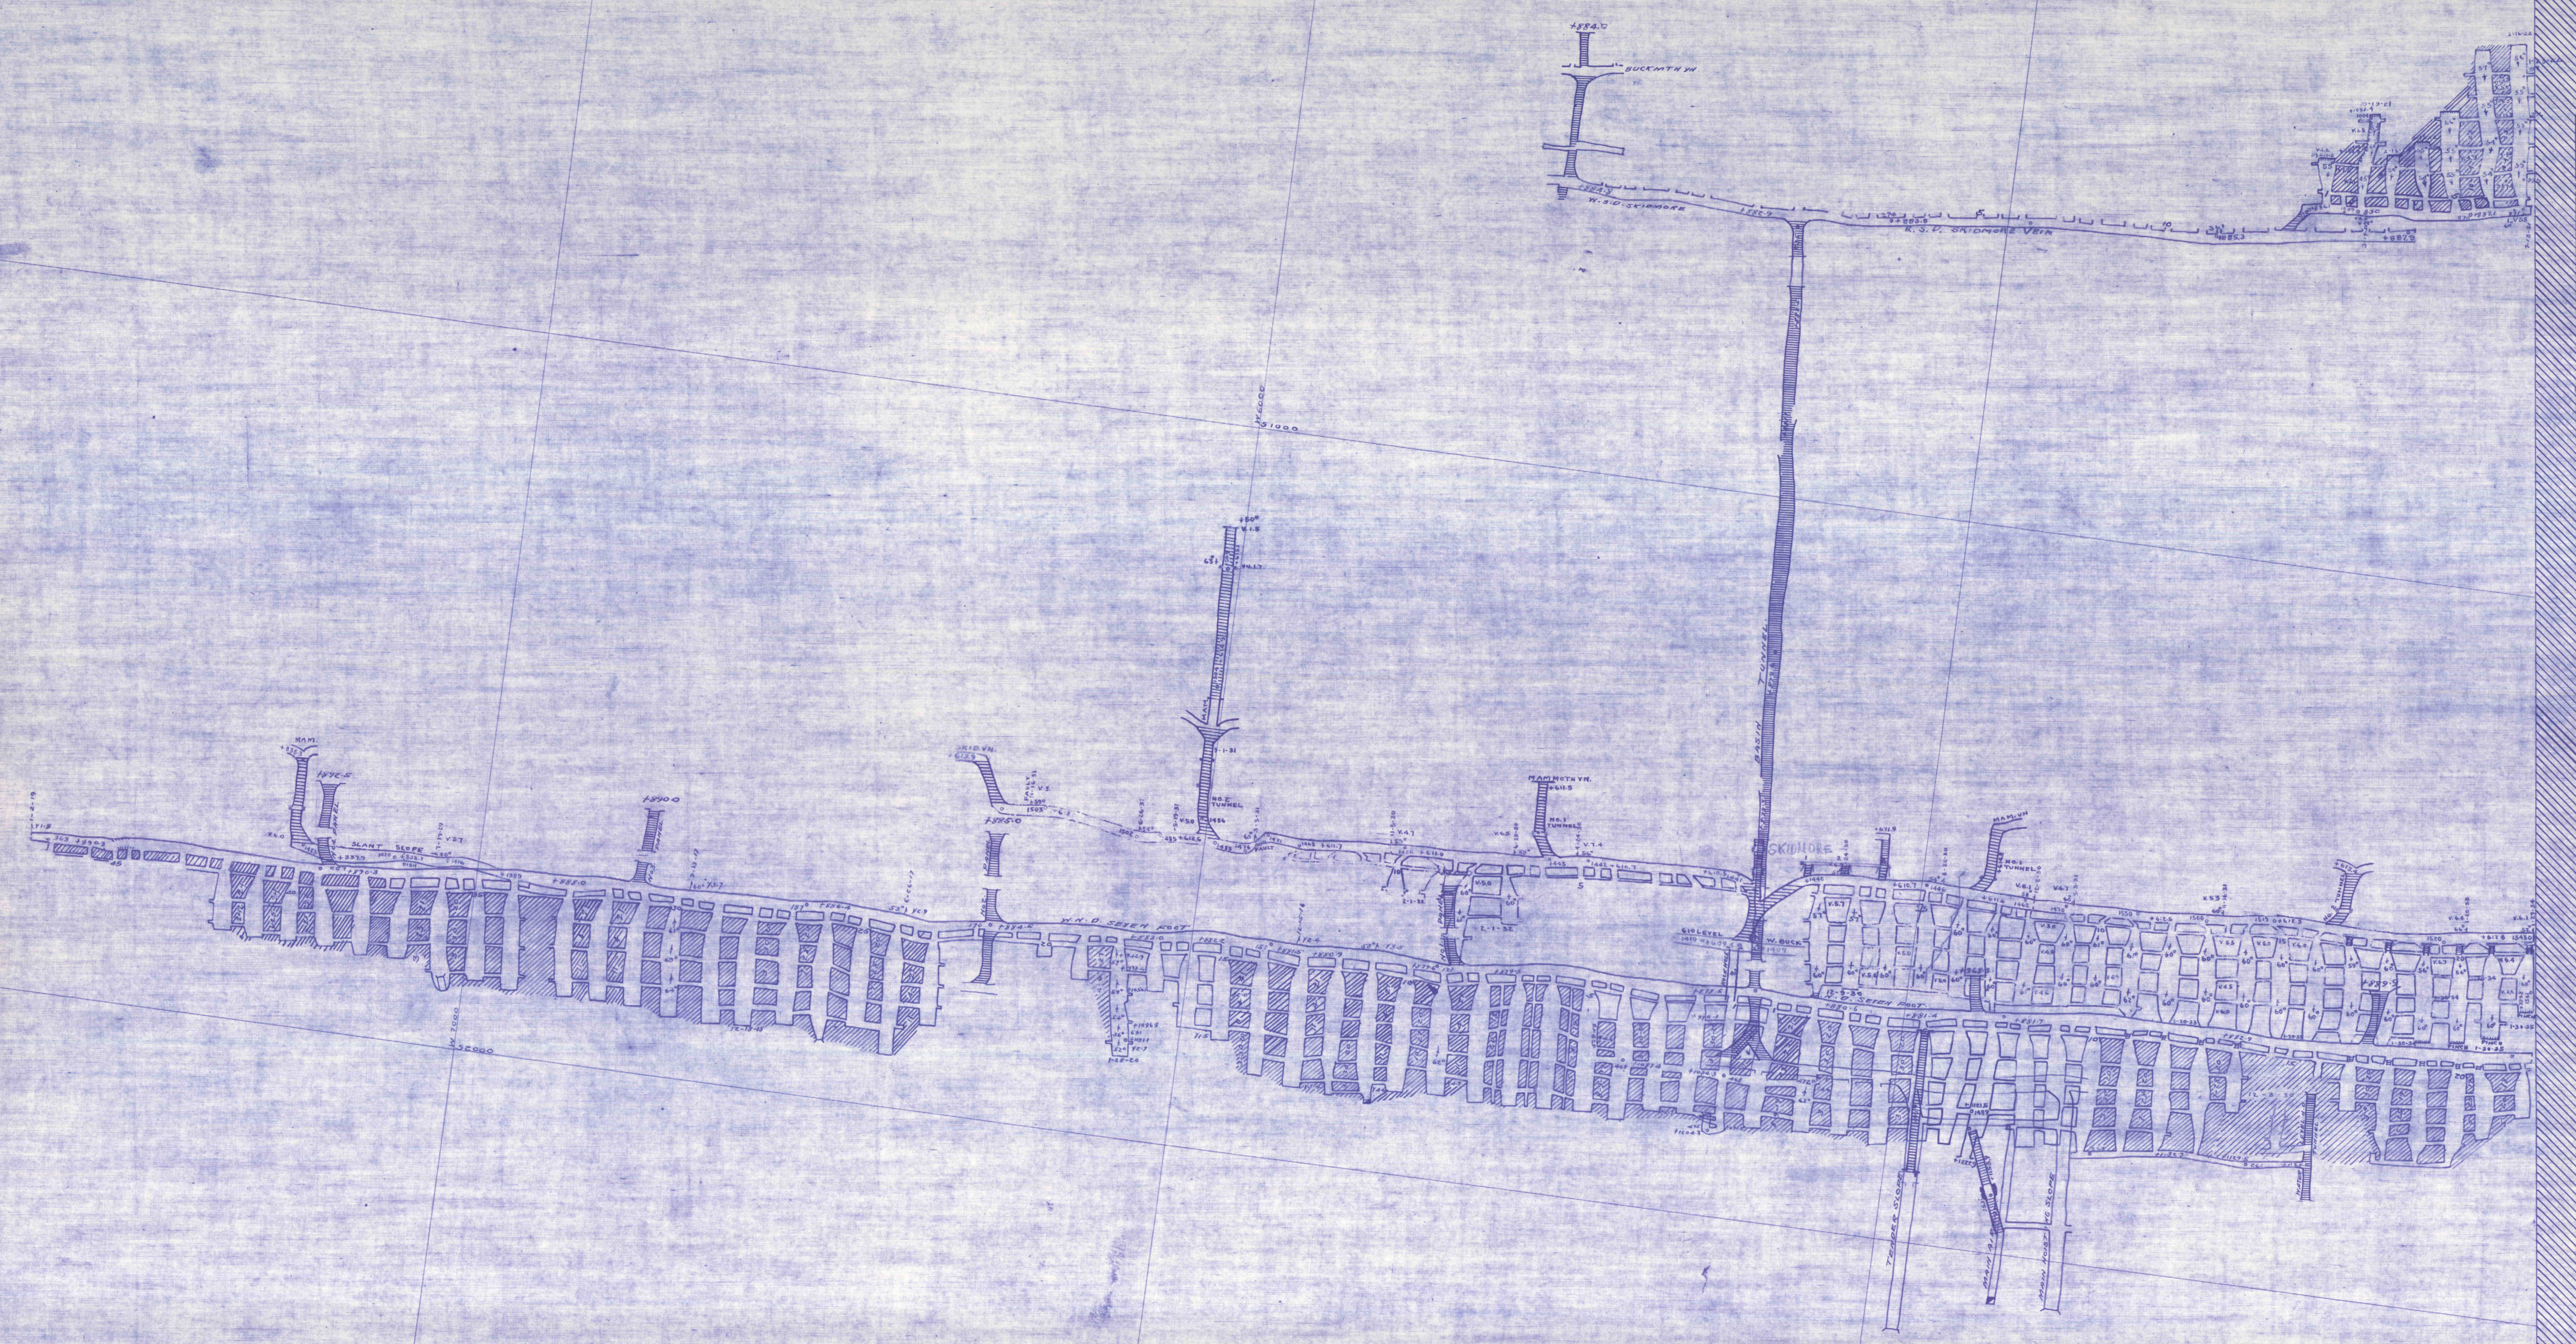

WESTERN MIDDLE FIELD
MAP OF
SEVEN FOOT VEIN
AT
WEST BEAR RIDGE
FOR
MINE INSPECTOR
BUTLER TWP,
SCHUYLKILL COUNTY, PA.
POSTED FEB 1927

MAR 10 1927