


850, EAST of ME21 LINE.  
 WEST BEAR RIDGE COLLIERIES, 1"=100'. X=SECTION FROM B22M  
 ... MESSERS MIDDLE COAL FIELD ...

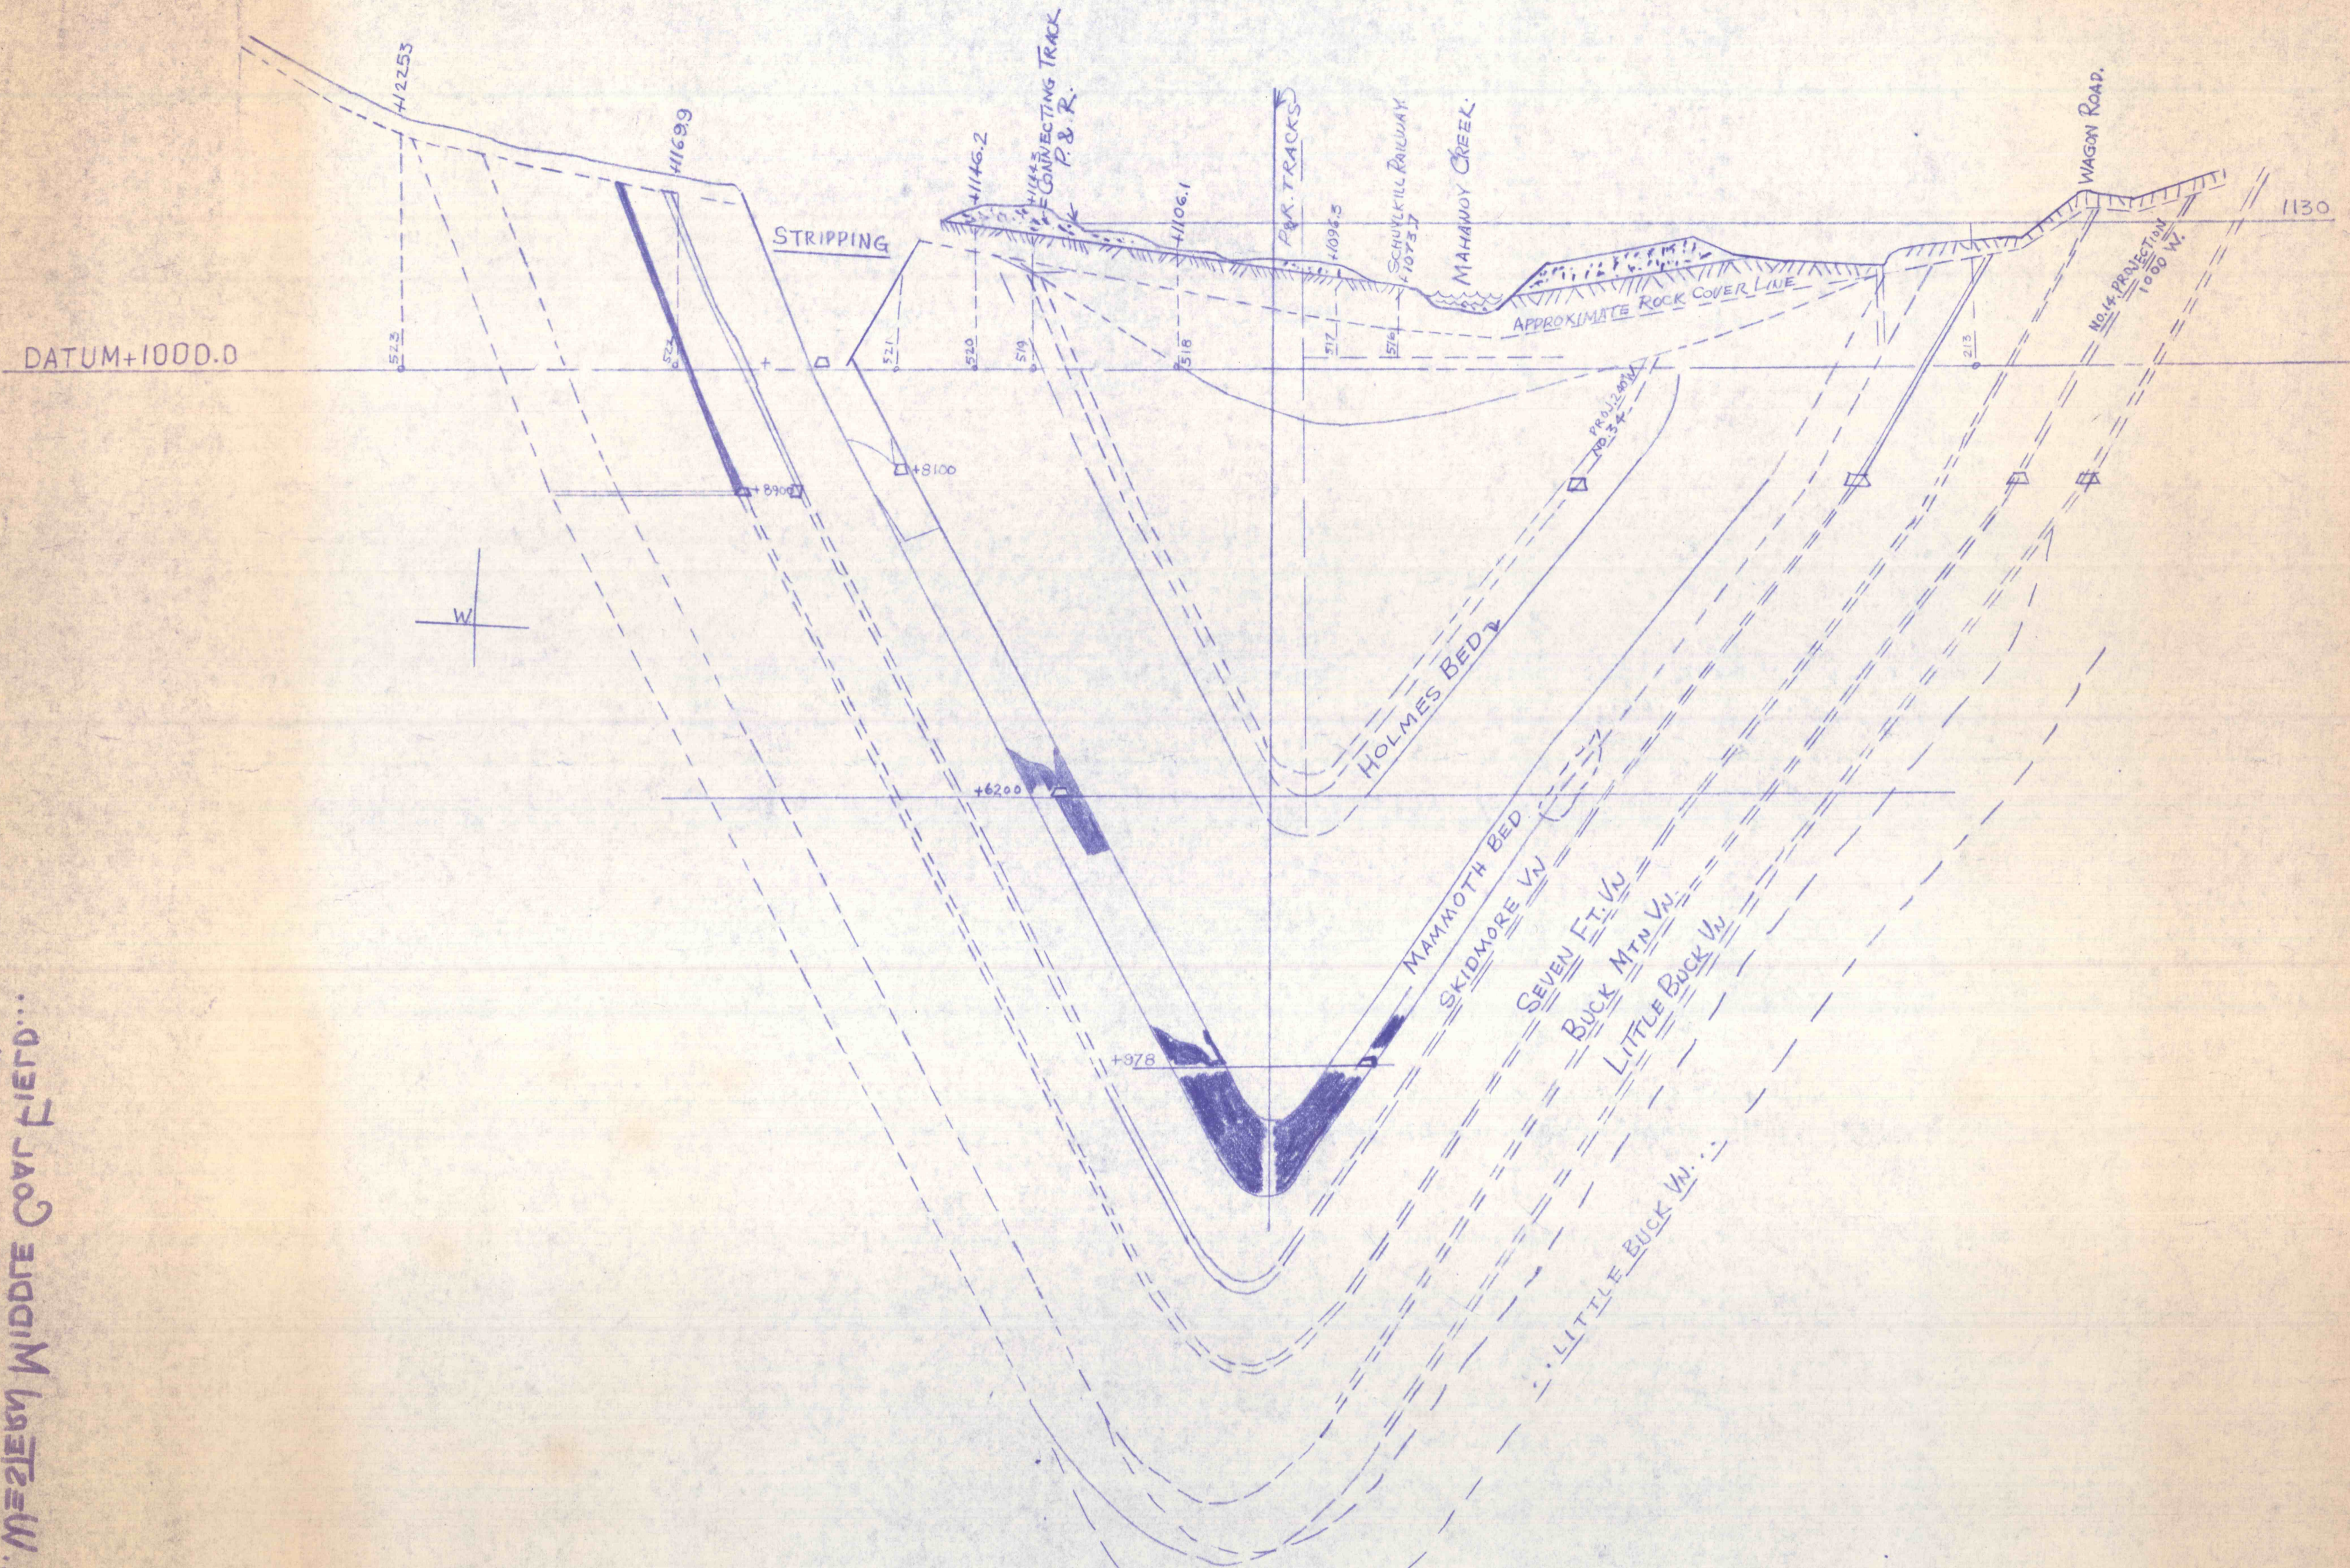

CROSS SECTION THRU BASIN AT  
 WEST BEAR RIDGE COLLIERIES, 1"=100'  
 820 FT. EAST OF WEST LINE. JULY 1918  
 HARLEIGH BROOKWOOD COAL CO., FRACKVILLE, PA.  
 TRACED BY: ALEX. DROZDA, JR. SEPT. 5, 1972

6000 ft.  
 5000 SOUTH