


WESTERN MIDDLE COAL FIELD

BEAR RIDGE COLLIERY

SECTION ACROSS BASIN ON LINE OF WEST BEAR RIDGE MAMMOTH HOISTING SLOPE
SCALE 100 FT PER INCH SCHUYLKILL COUNTY, PA AUGUST 16th 1914.

LOOKING EAST

W. MAHANOY TWP., 11 W. MAH., DISTRICT. P. R. C. & I. CO.,

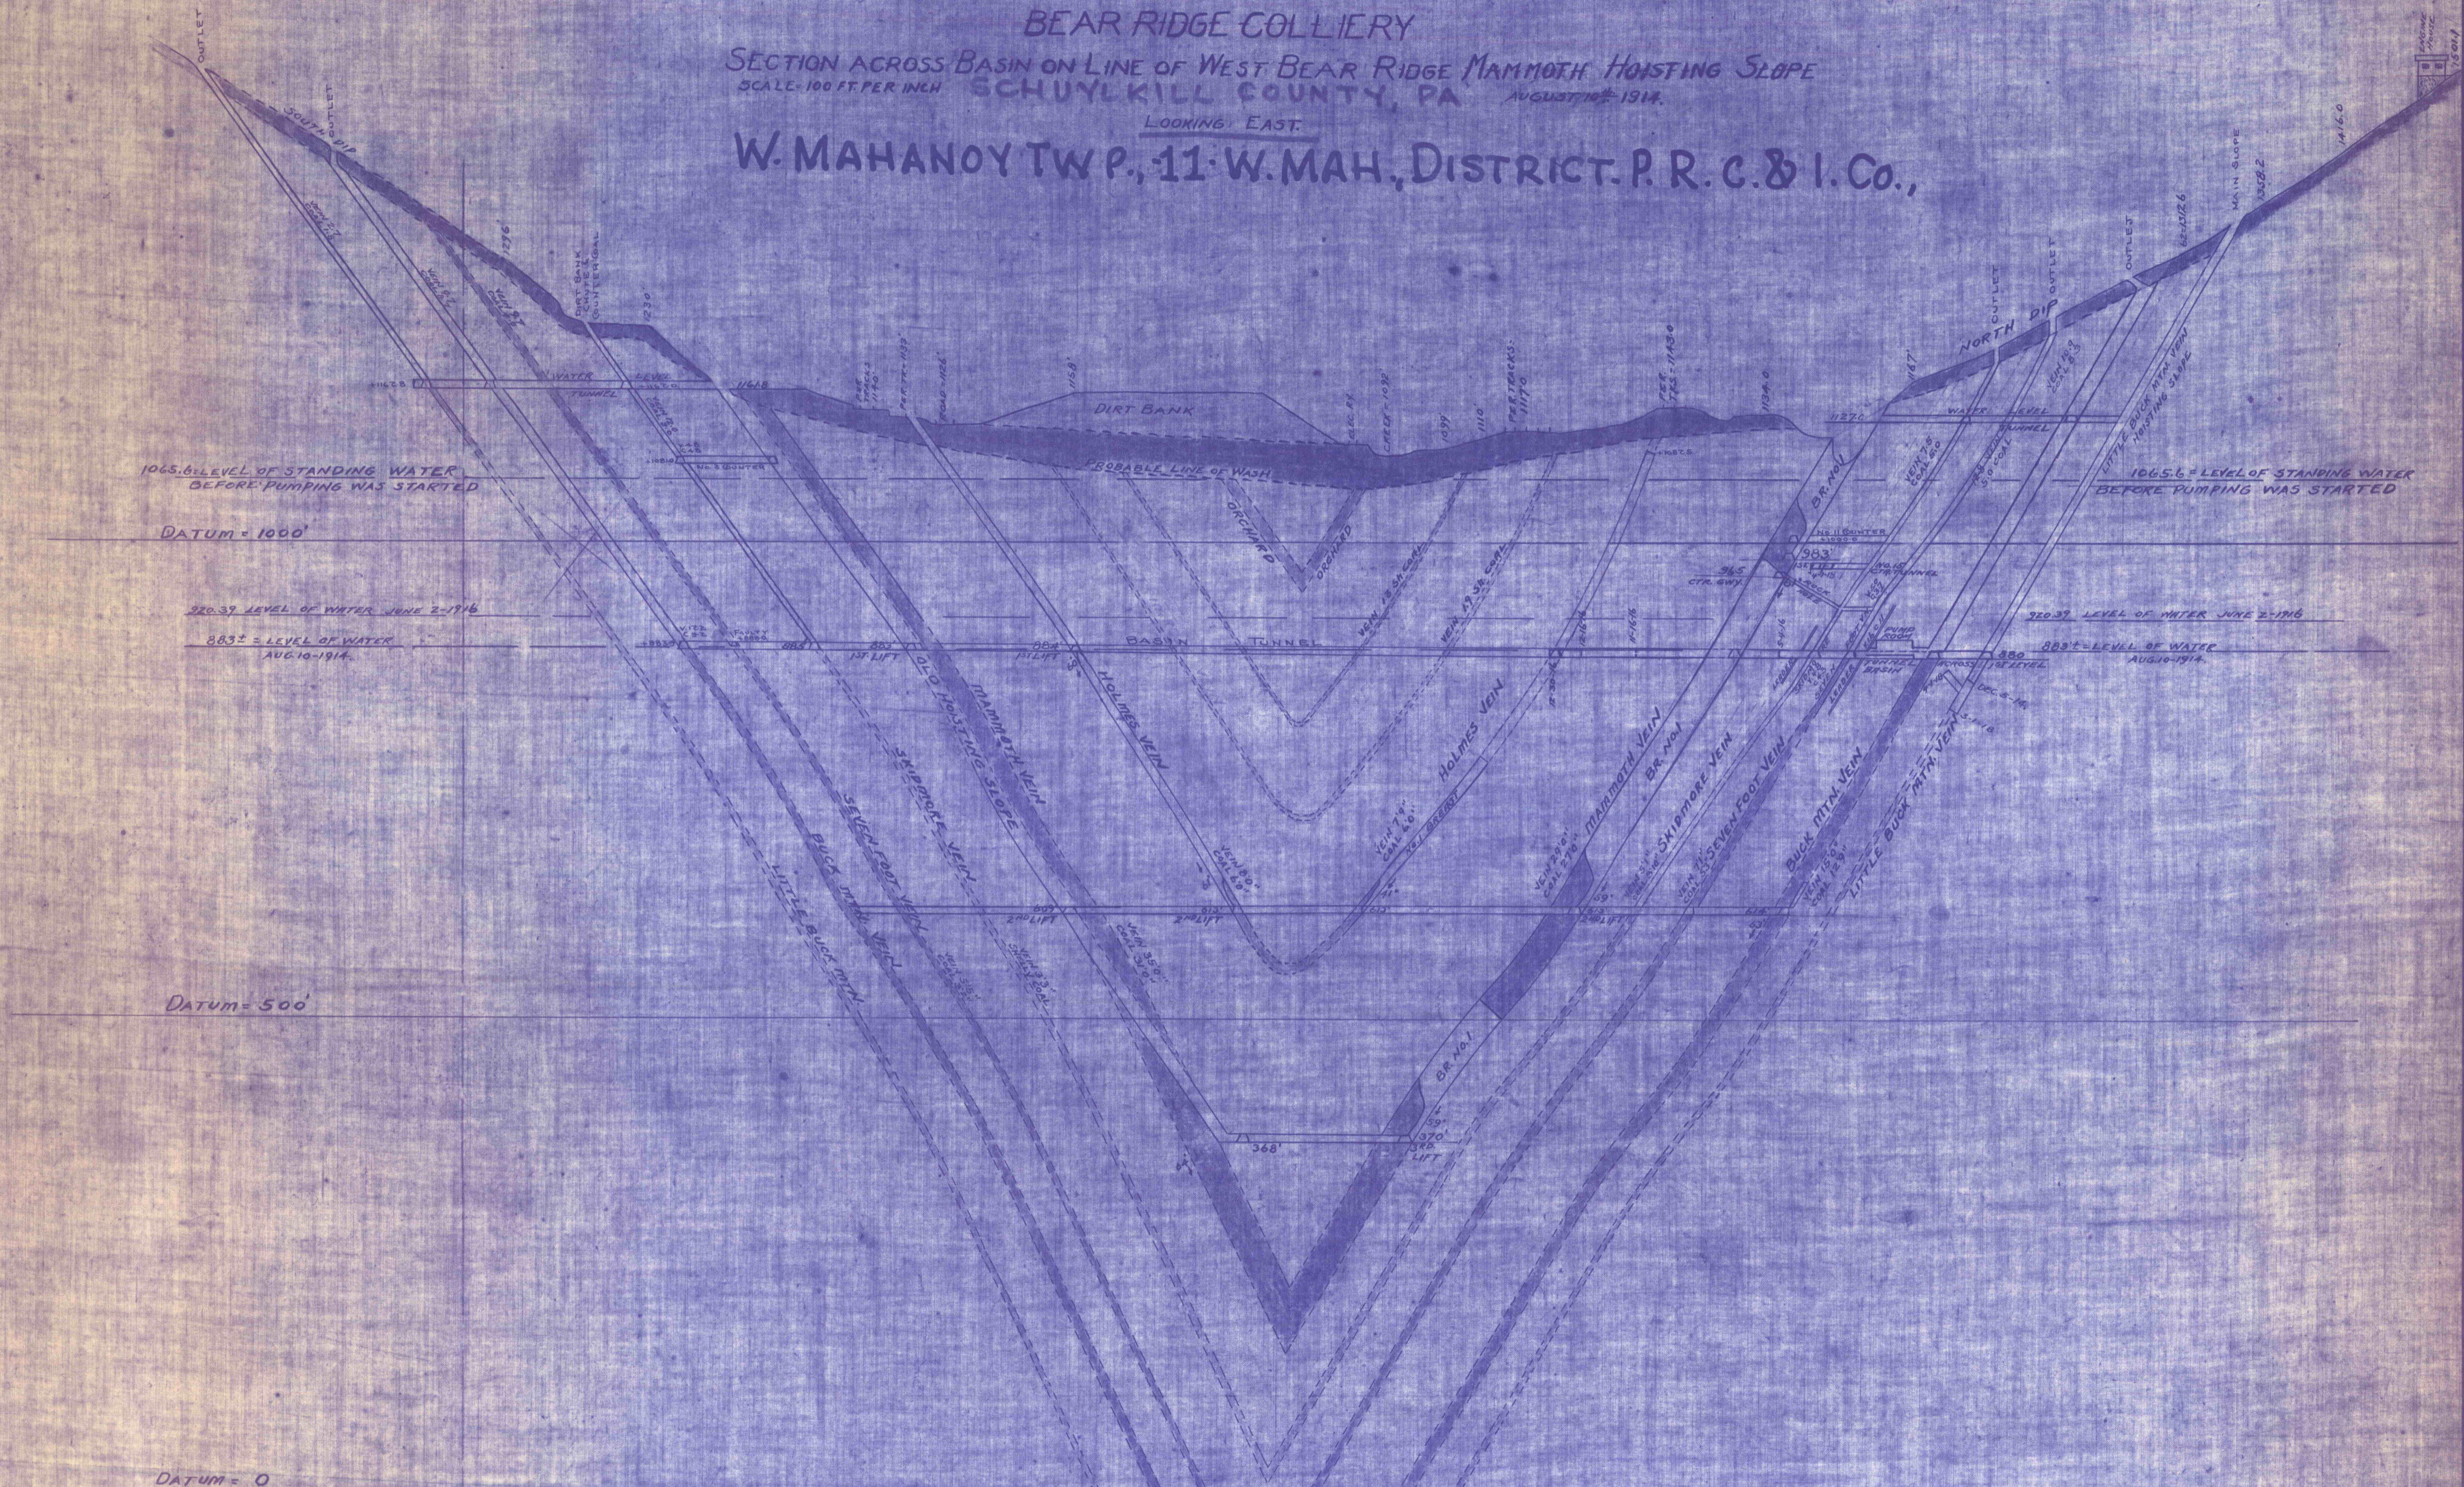

AVERAGE THICKNESS OF VEINS

NAME	COCHRAN & JONES REPORT		HARLEIGH-BROOKWOOD CO.	
	VEIN	COAL	VEIN	COAL
HOLMES	—	3.0	7.9 to 2.0	6.0
MAMMOTH	29.0 to 31.0	23.0 to 25.0	29.0 to 33.0	27.0 to 31.0
SKIDMORE	—	—	3.3 to 7.5	3.3 to 3.0
SEVEN FOOT	—	—	5.5 to 12.0	3.2 to 5.2
BUCK MOUNTAIN	—	3.0	9.5 to 15.0	8.3 to 12.9
LITTLE BUCK MT.	—	—	3.0 to 6.0	2.0

REVISED JUNE 3-1916
DEC. 29-1914

MAR 10 1972

MIF