


No 5

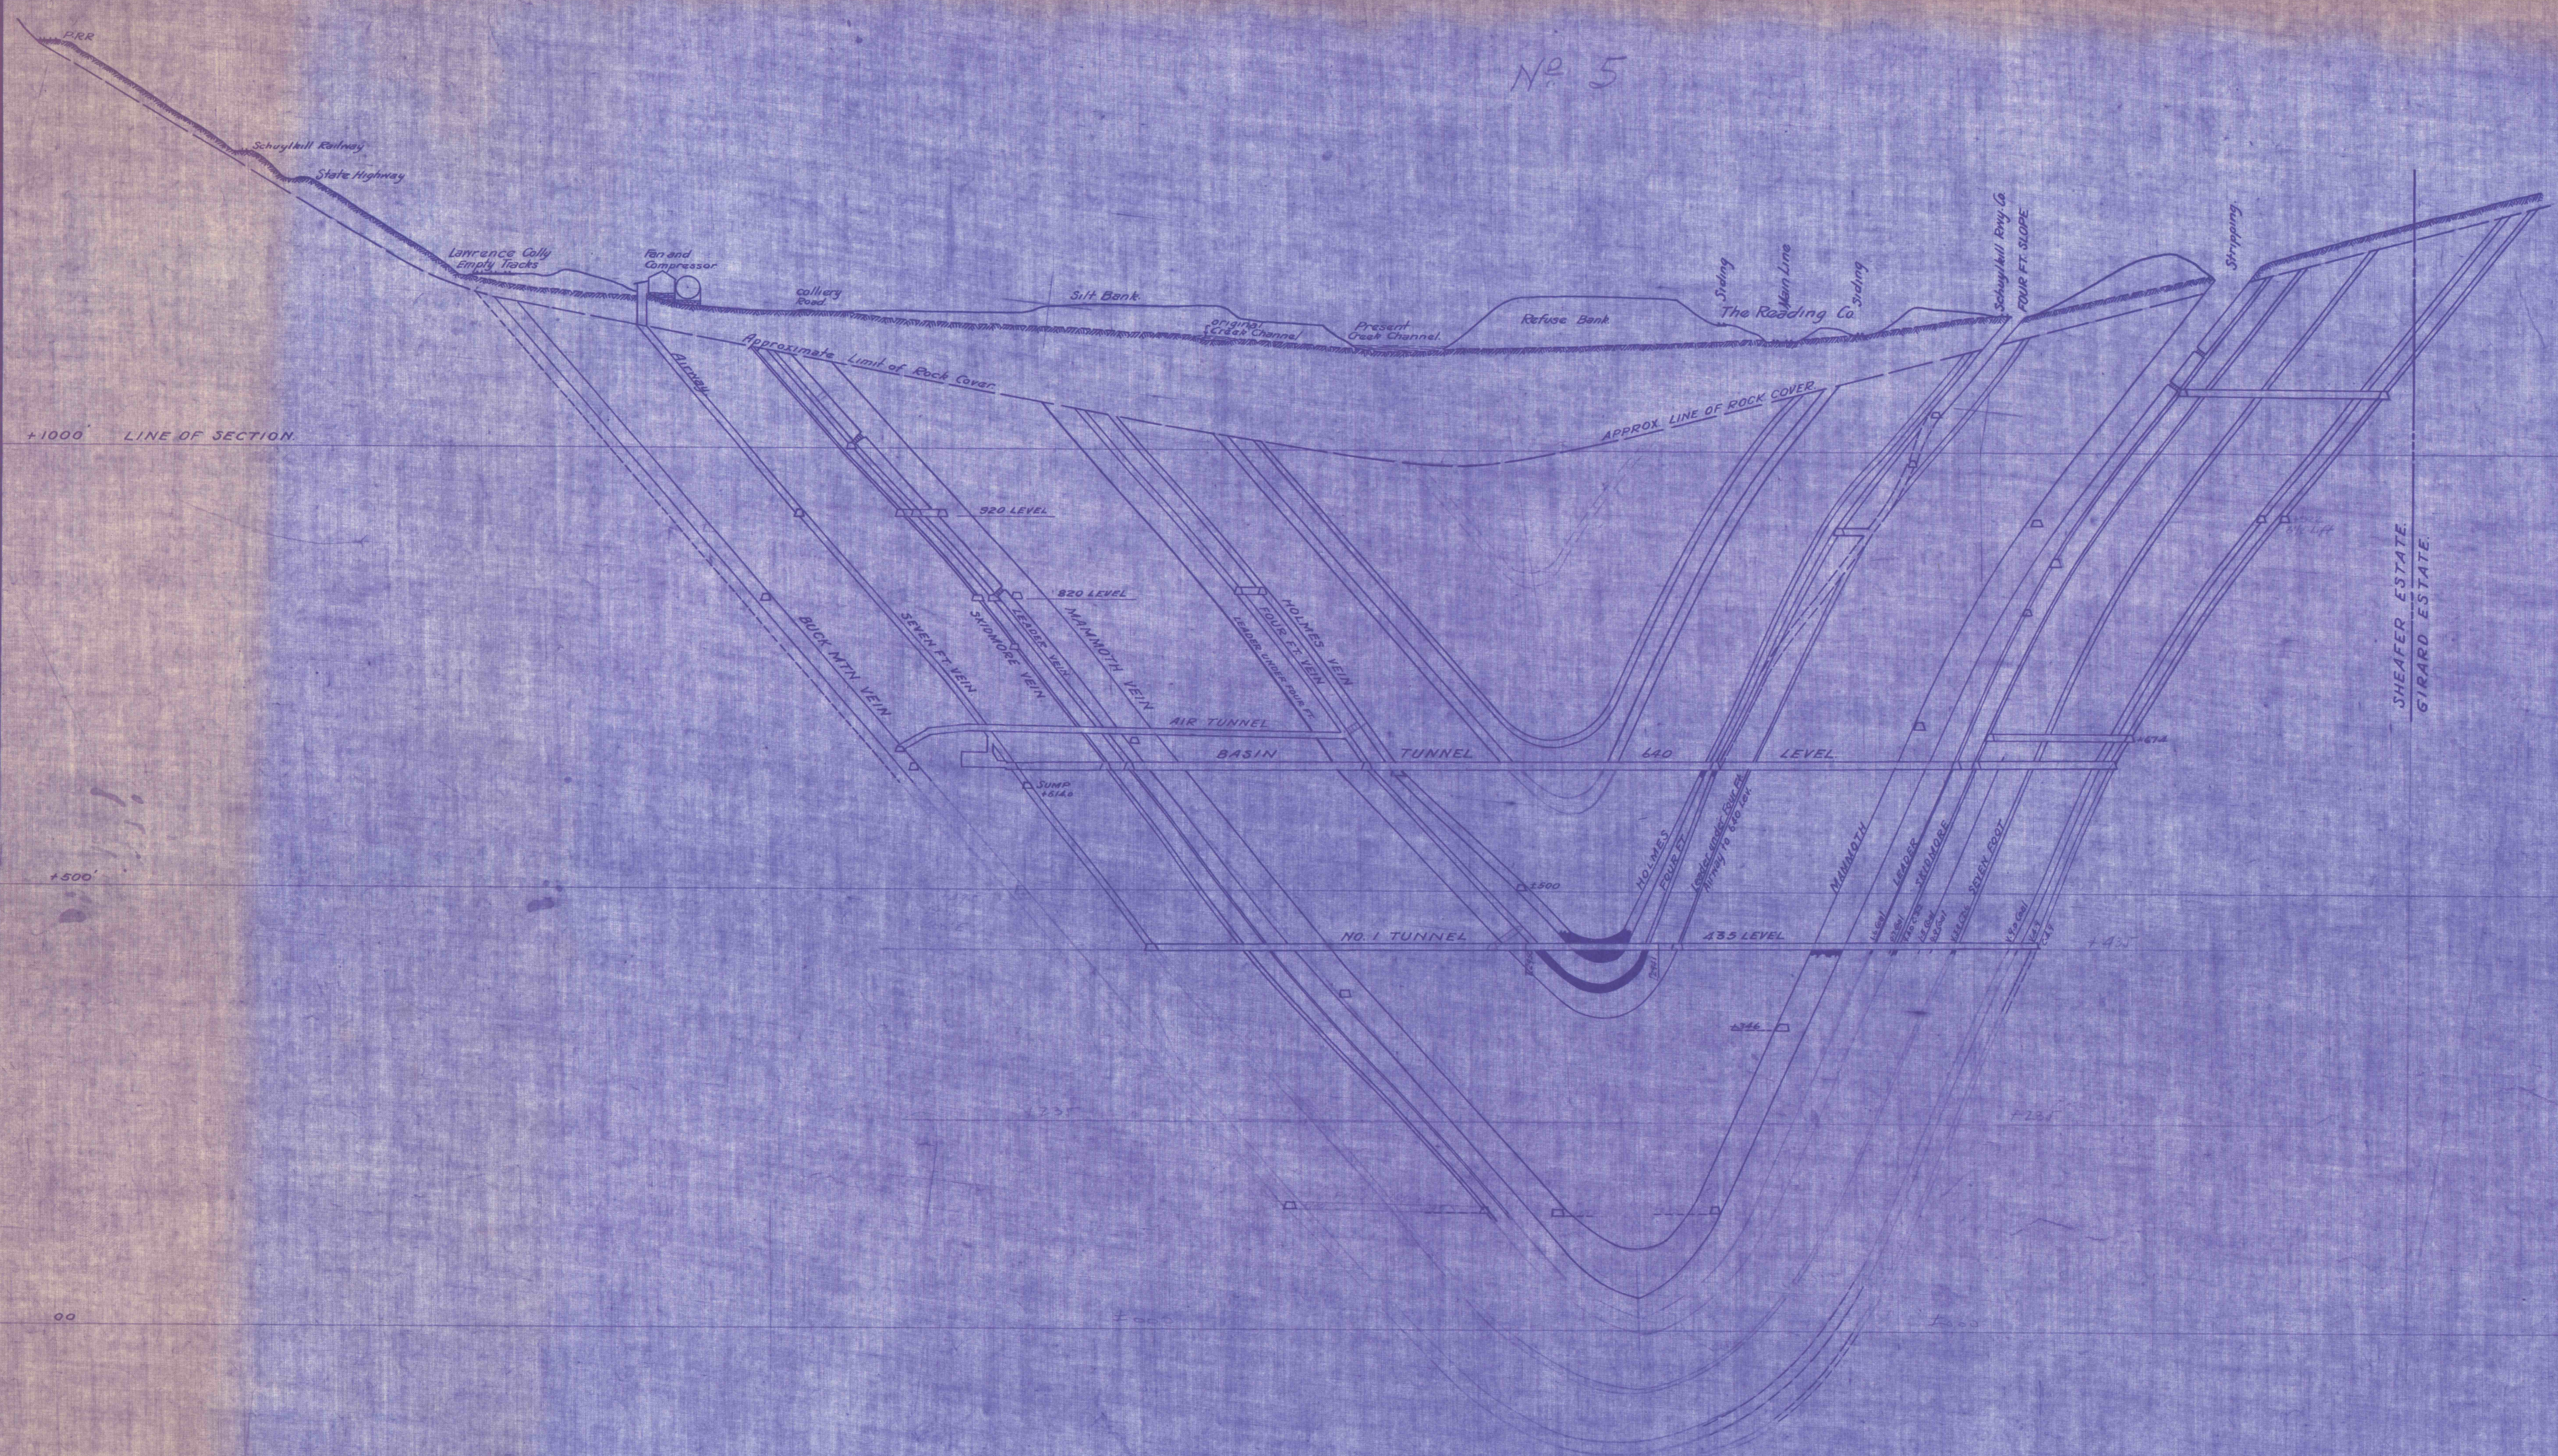

CROSS SECTION No 5
 THRU
 No 1 TUNNEL 435 LEVEL
 HARLEIGH-BROOKWOOD COAL CO.,
 MAHANOY PLANE- PA.
 SCALE 1 INCH = 100 Ft. SEPT 5-1936.