


MAP NO. 102  
1915

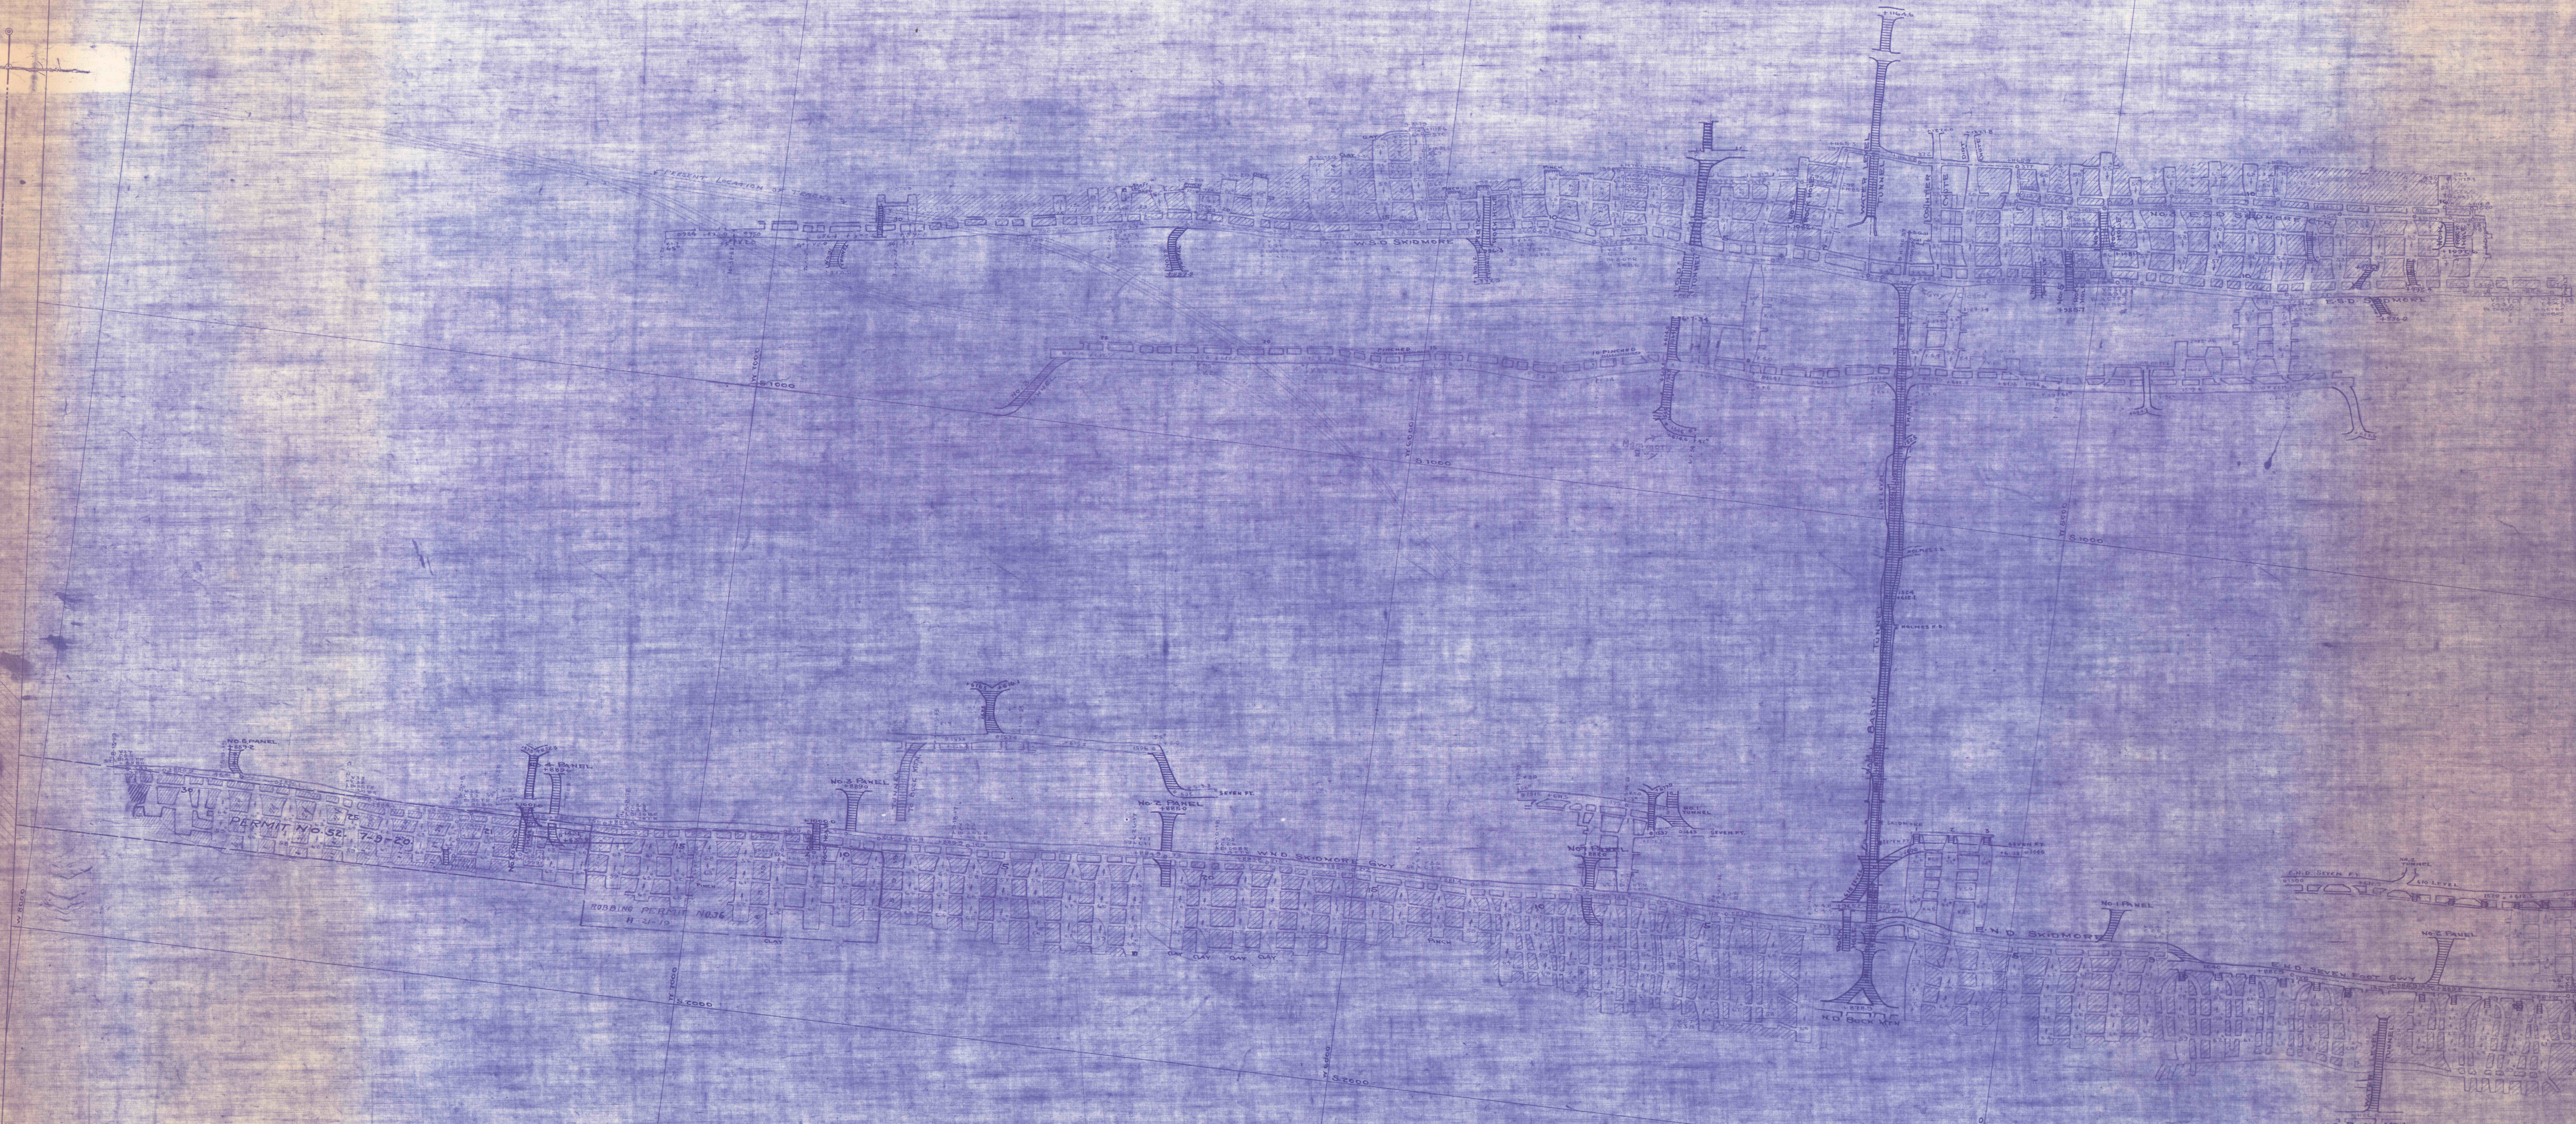

Western Middle Field.  
 MAP  
 OF  
 SKIDMORE BED  
 Butler Twp., Schuylkill Co., Pa.,  
 WEST BEAR RIDGE COLLIERY.  
 SCALE 1"=100' HARLEIGH-BROOKWOOD COAL CO. DEC. 6 1919.  
 POSTED FEBRUARY 1937 A. D.

SECTION THROUGH NO. 10 & 11





