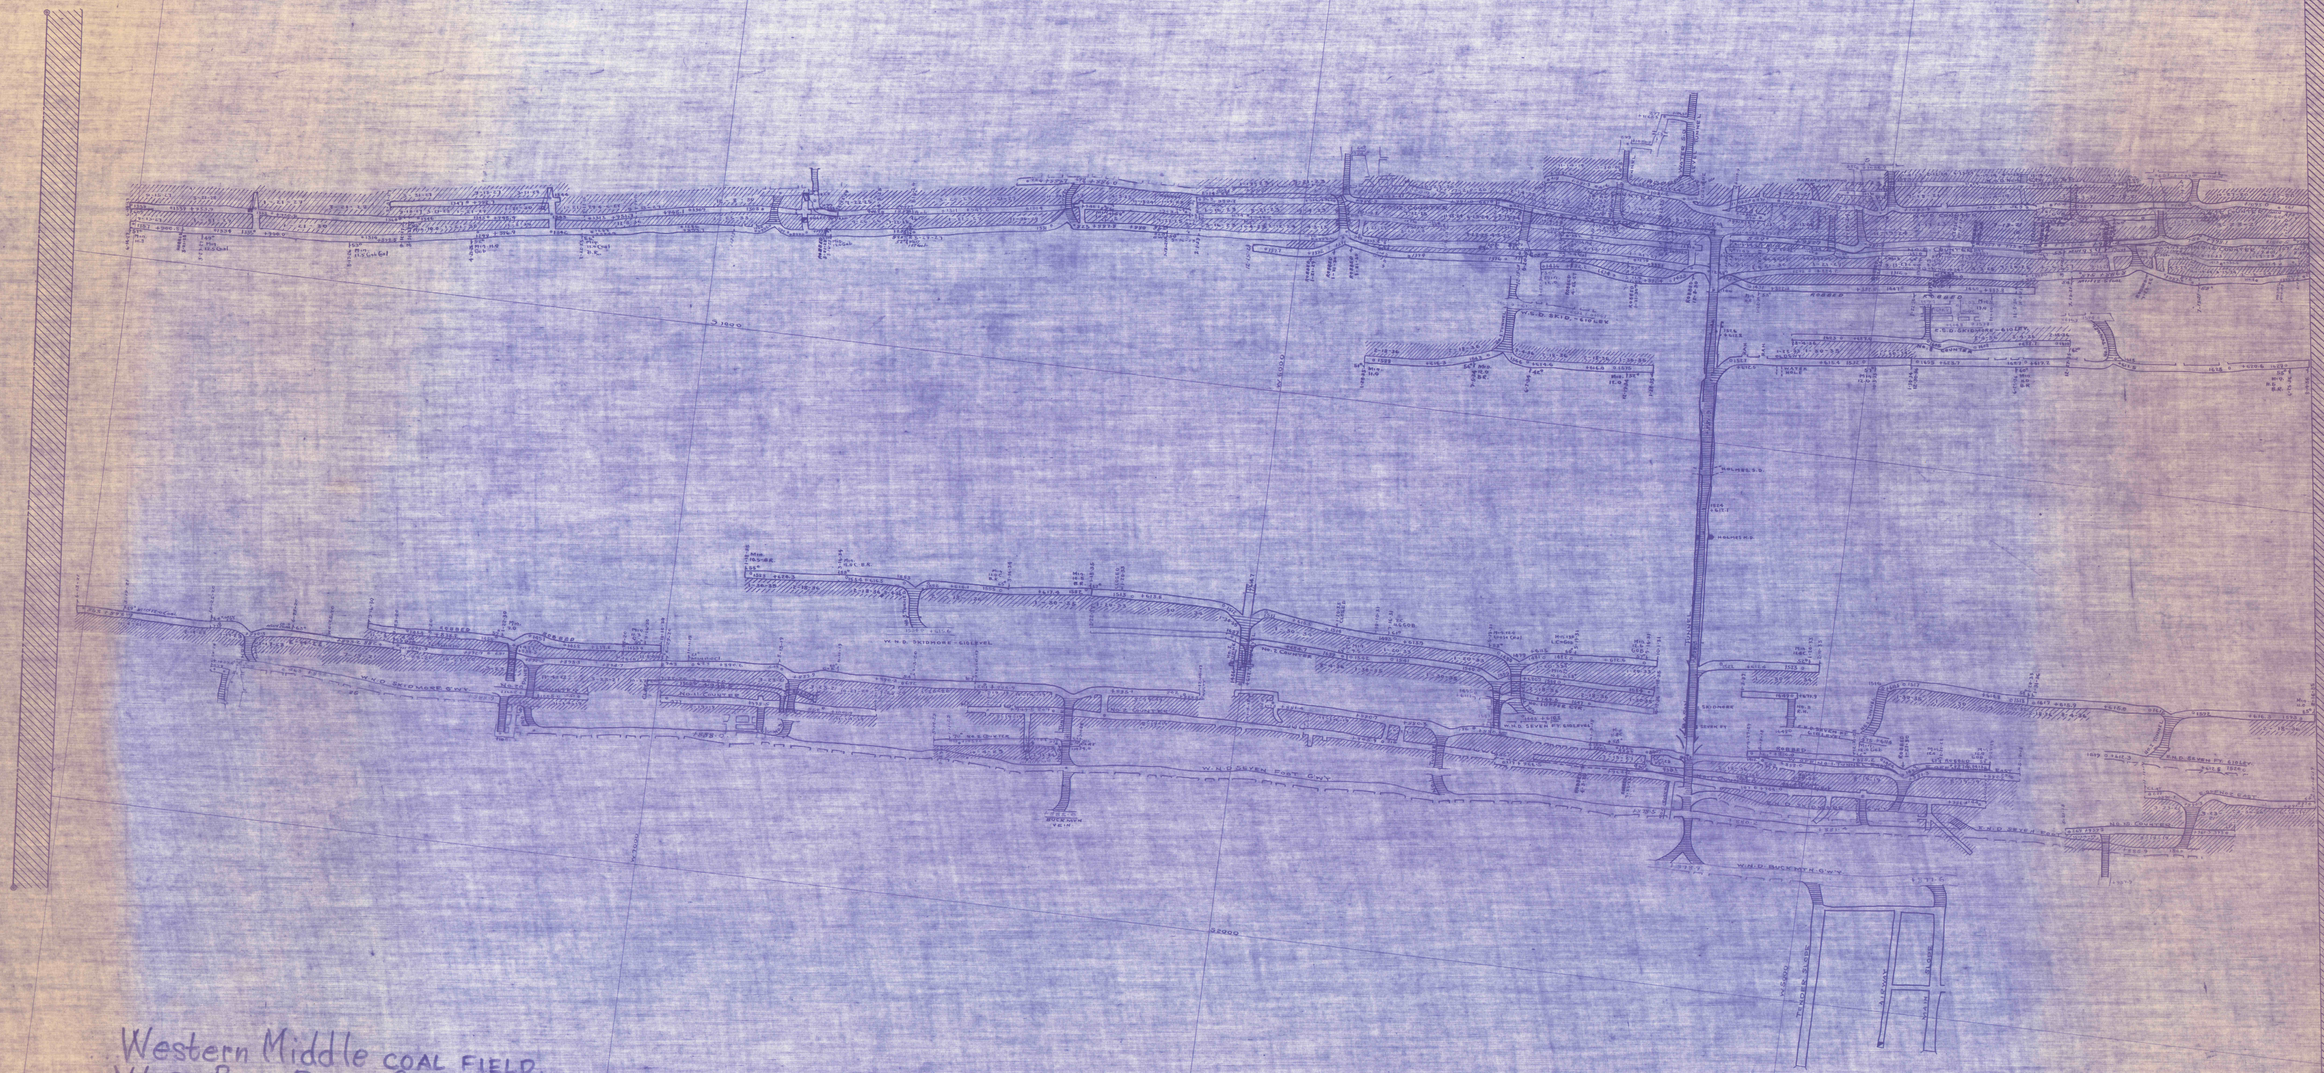

Western Middle COAL FIELD
WEST BEAR RIDGE Colliery. 1"=100'...
MAMMOTH VEIN. SCHUYLKILL COUNTY.
DATED: MARCH 11, 1921. A.D. POSTED: FEB. 1937