


HOLMES VEIN  
WEST BEAR RIDGE

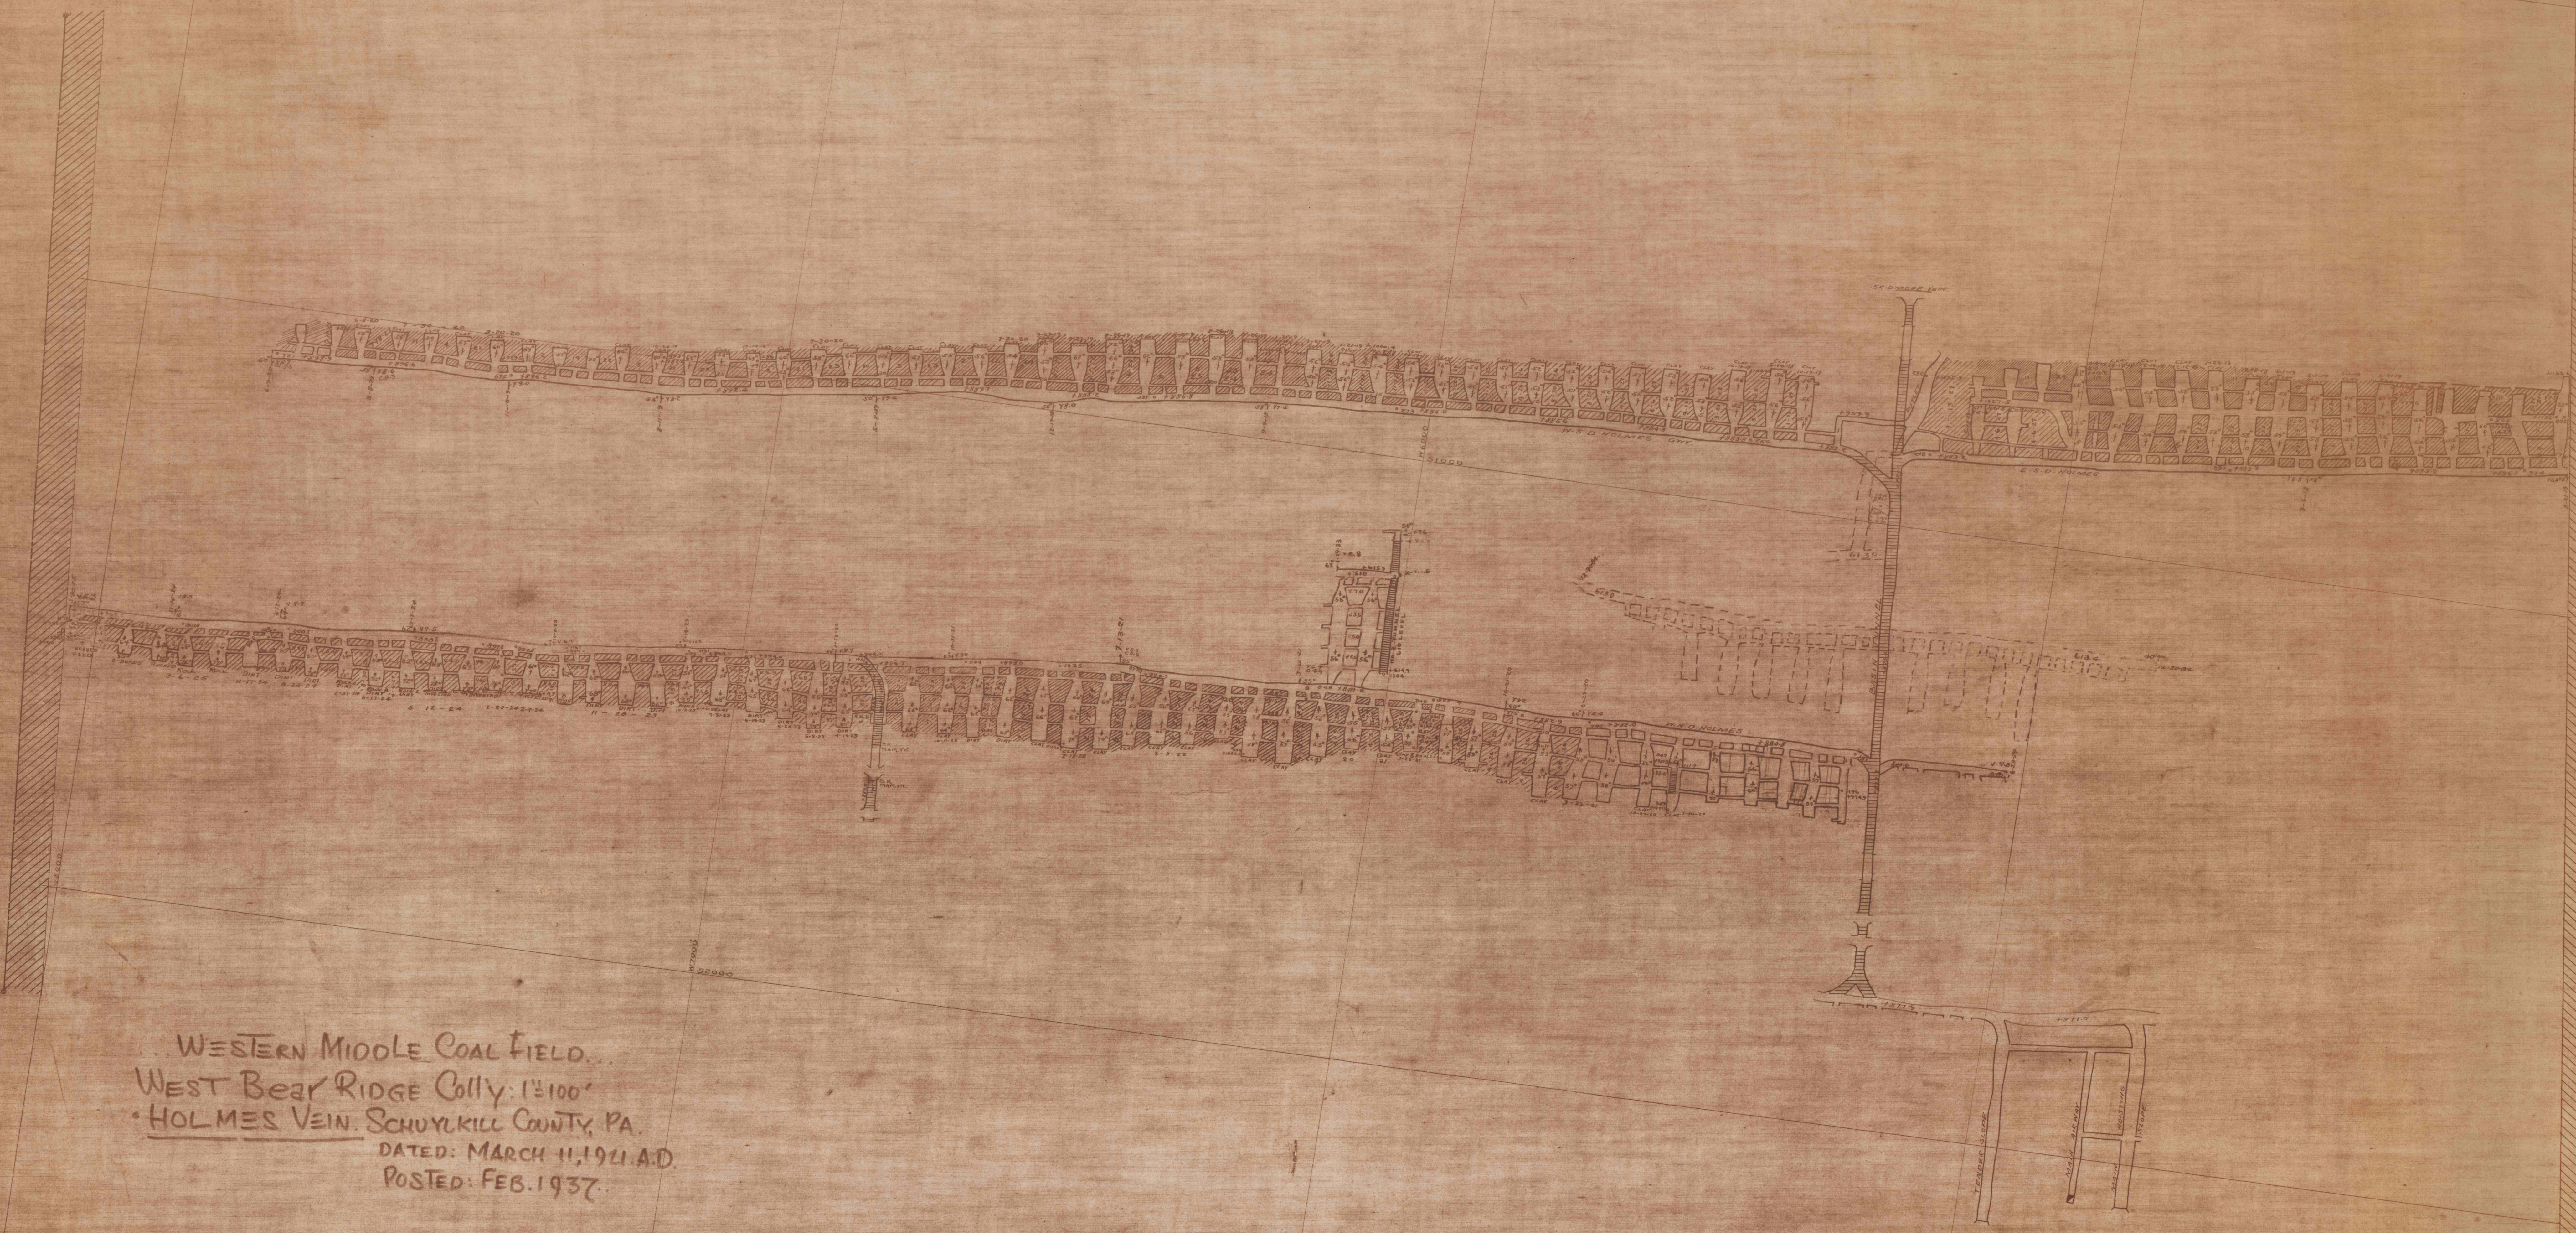

WESTERN MIDDLE COAL FIELD.  
WEST BEAR RIDGE Colly: 1:100'  
• HOLMES VEIN, SCHUYLKILL COUNTY, PA.  
DATED: MARCH 11, 1921 A.D.  
POSTED: FEB. 1937.

MAR 10 1921

