


Guinea Hill Slope

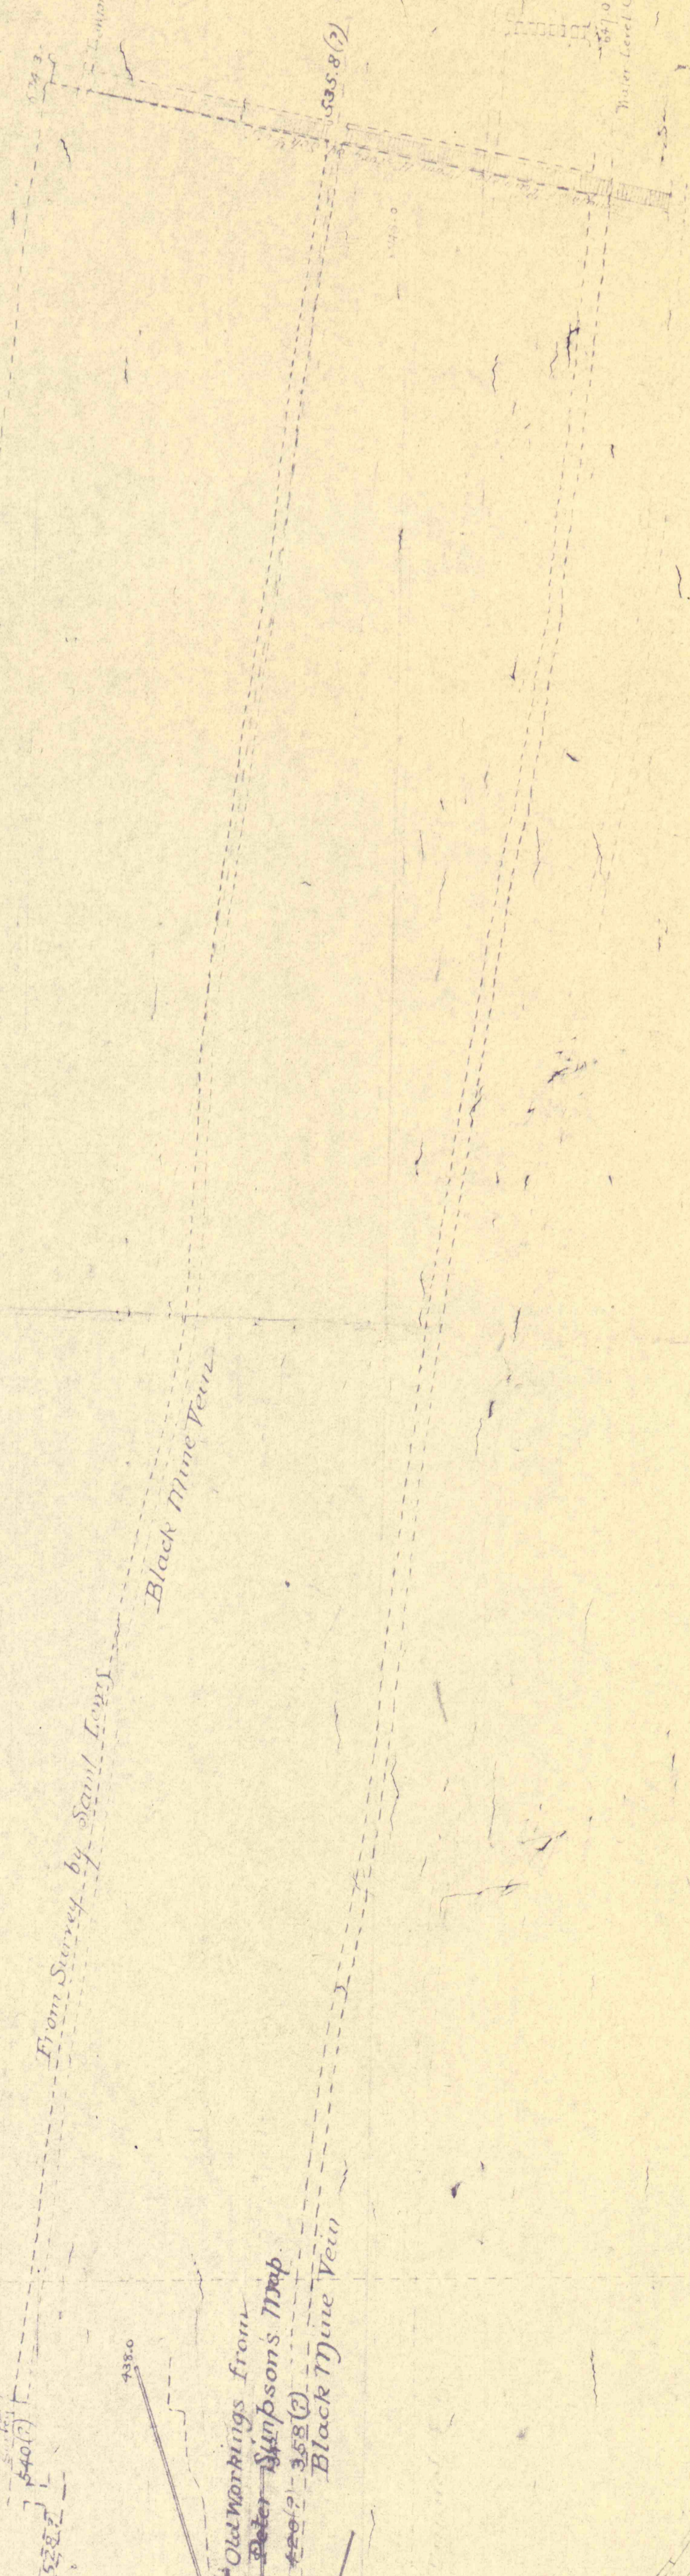

York Iron Colliery  
Scale 100' = 1" Oct. 21  
J. B. Cochran & Son,  
ENGINEERS.

MANAGER

Old workings from  
1852. 355(C)  
Black Mine Vein