LOG OF TEST HOLE BORINGS

HOLE Nº 1 — SURFACE EL. 867.5

STRATA CUT		TOTAL
18'	REFUSE FILL	18'
15'	FRACTURED SHALE & SILT	33'
1'	SMALL VOID	34'
1'	BLACK SLATE	35'
1'	SMALL VOID	36'
5'	COAL	41'
28'	FRACTURED SANDSTONE	69'
20'	GREY SAND SLATE, FRACT'D	89'
14.5'	DARK GREY SLATE, "	103.5'
2.5'	COAL, FRACTURED	106'
19'	GREY SAND SLATE, FRACT'D	125'

HOLE Nº 3 — SURFACE EL. 867.2

STRATA CUT		TOTAL
11'	FILL	11'
3.5'	BR. SANDSTONE, FRACTURED	14.5'
7.5'	GREY SANDSTONE W/BR. STAININGS FRACTURED	22.0'
15.5'	GREY SANDSLATE W/BR. STAININGS FRACTURED	37.5'
6.0'	DARK GREY SLATE FRACTURED	43.5'
7.0'	COAL, FRACTURED	50.5'
26.5'	GREY SANDSLATE W/SMALL SEAMS OF SLATE	77.0'
18'	GREY SANDSLATE, FRACTURED	95.0'

HOLE Nº 2A — SURFACE EL. 865.8

STRATA CUT		TOTAL
0.5'	BR. SILTY TOP SOIL	0.5'
1.5.	BR. SHALE W/CLAY SEAMS DECOMPOSED	2.0'
9.0'	GREY SHALE W/CLAY STAIN'G BADLY FRACTURED	11.0'
12.0'	BR. GREY SANDSTONE W/BR. STAININGS, BADLY FRACT'D	23.0'
1.0'	GREY SANDSLATE "	24.0'
7.5'	GREY SANDSTONE W/BR. STAININGS, FRACTURED	31.5'
4.5'	GREY SANDSLATE W/BR. STAININGS, FRACTURED	36.0'
0.3'	VOID	36.3'
13.7'	GREY SLATE W/BR. STAIN'G FRACTURED	53.0'
8.7'	COAL, SHELLY-FRACTURED	61.7'
26.3'	GREY SAND SLATE W/SEAMS SAND STONE, FRACTURED	88.0'

HOLE Nº 4A — SURFACE EL. 865.8

STRATA CUT		TOTAL
0.5'	BR. SILTY TOP SOIL	0.5'
1.0'	BR. SANDY SILT	1.5'
34.5'	GREY BR. SANDSTONE W/STAININGS FRACTURED	36.0'
18.5'	GREY SLATE W/STAININGS FRACT'D	54.5'
3.5'	COAL	58.0'
24.0	GREY SANDY SLATE, FRACTURED	82.0'

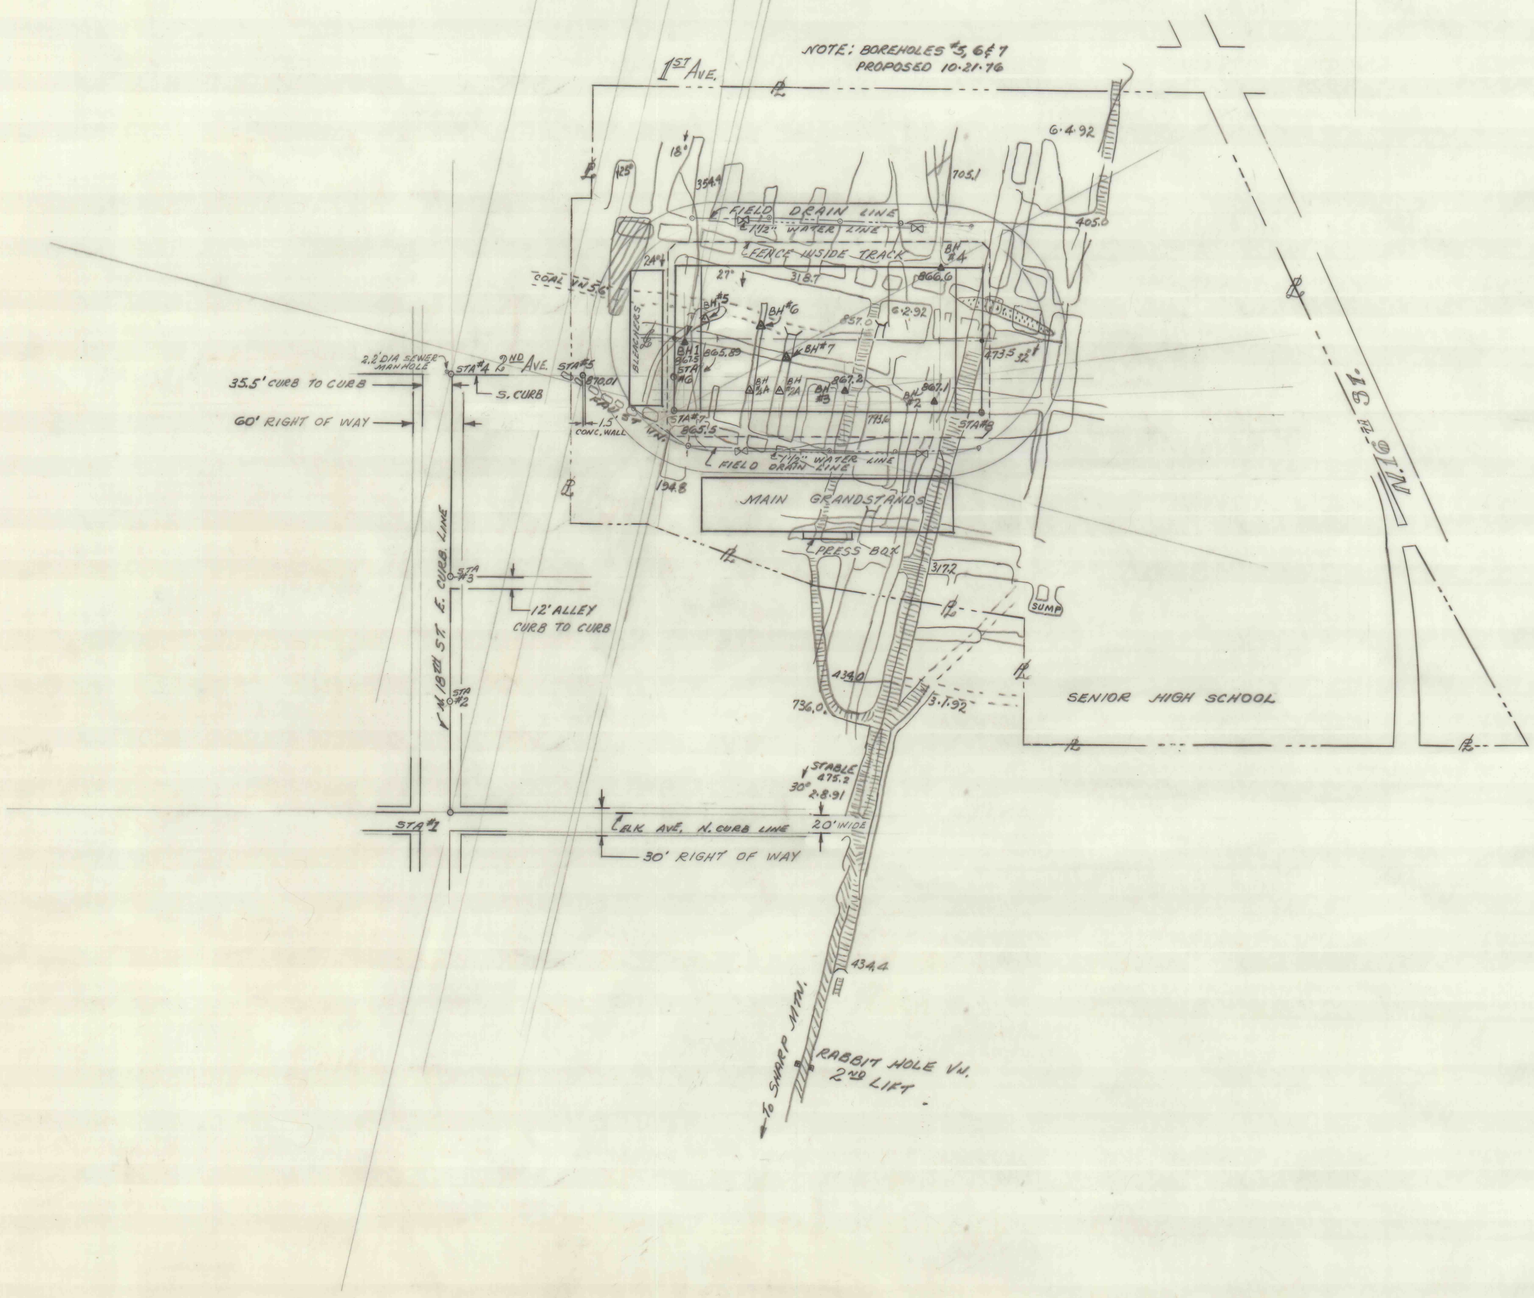

POTTSVILLE AND YORK FARM
SURFACE & MINE WORKINGS IN
VICINITY OF POTTSVILLE HI-SCHOOL
VETERANS MEMORIAL STADIUM
SCALE 1" = 100' 9-21-76, 9-27-76 & 10-12-76
DEPT. OF ENVIR. RESOURCES

PROJECT Nº SL-458

SURVEY SEPT. 28, 1976