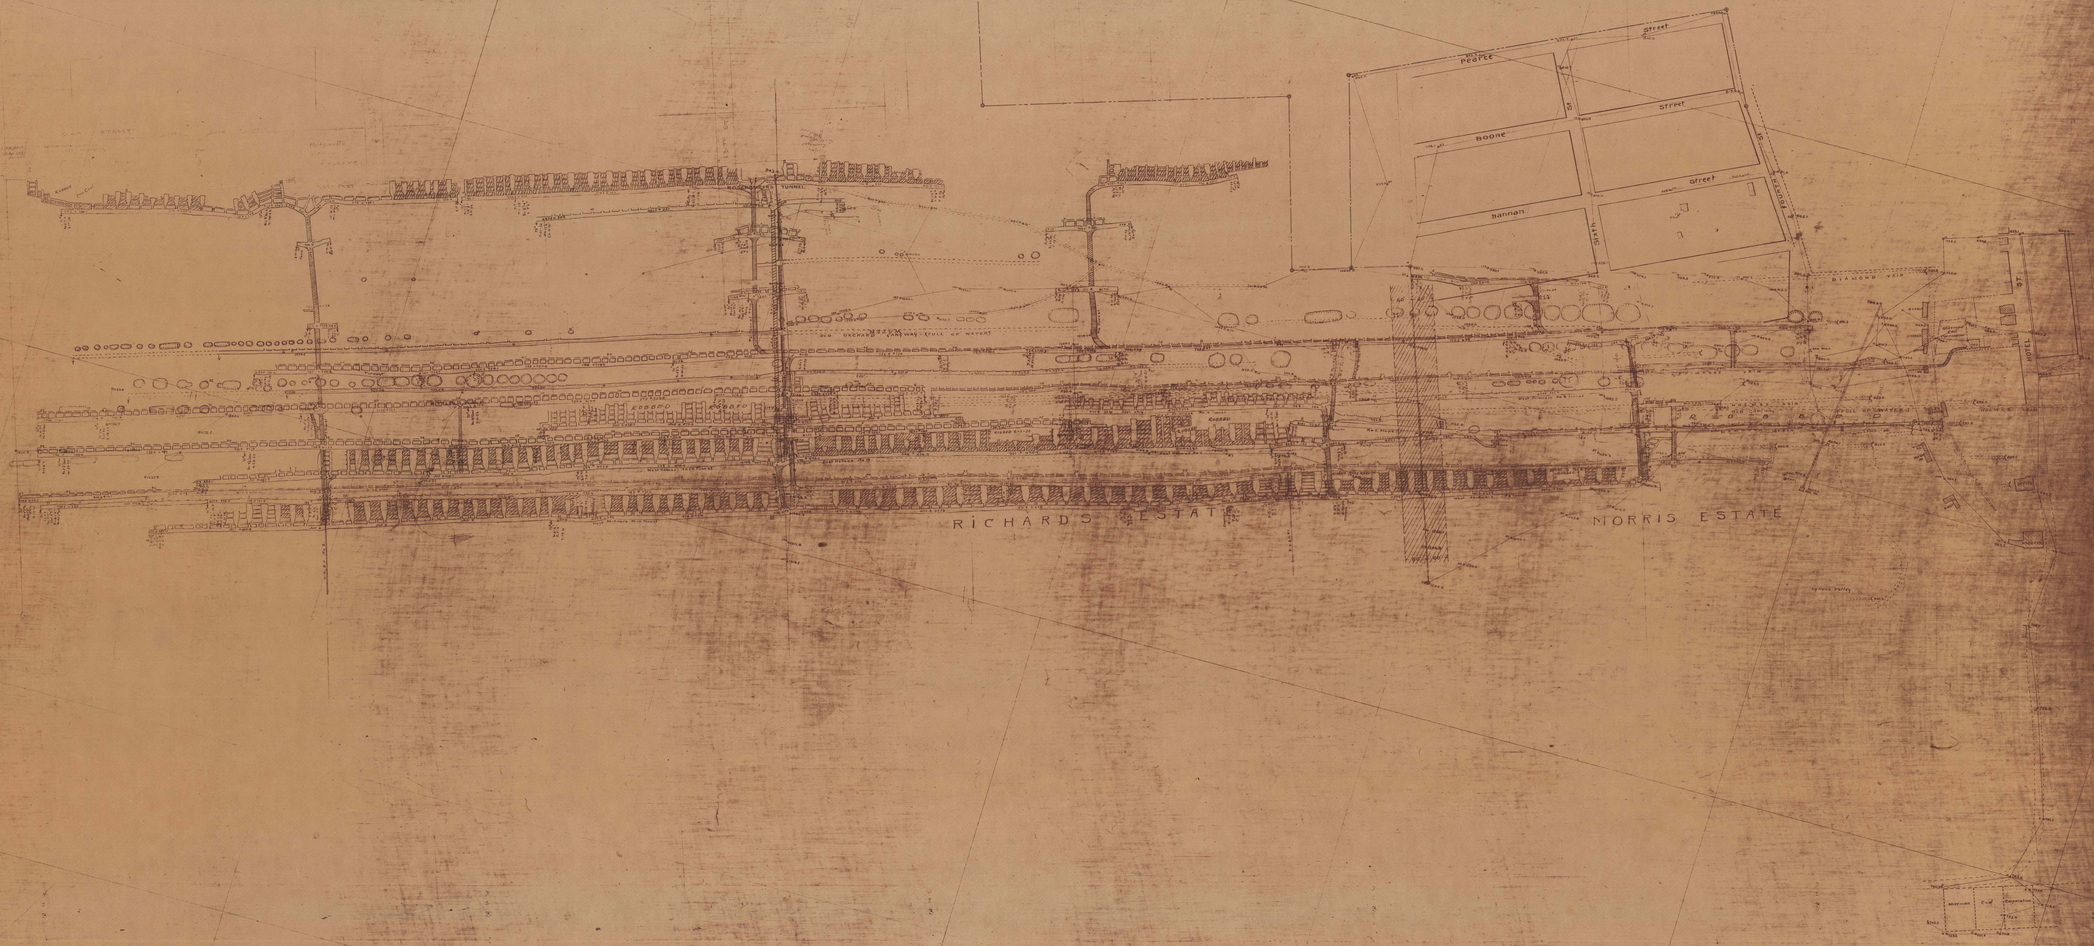

STATE MINE INSPECTORS
MAP
SHERMAN COAL CORPORATION
MINE WORKINGS