## LOG OF TEST HOLE BORINGS

**HOLE Nº 1** SURFACE EL. 867.5

| STRATA CUT | | TOTAL |
|---|---|---|
| 18' | REFUSE FILL | 18' |
| 15' | FRACTURED SHALE & SILT | 33' |
| 1' | SMALL VOID | 34' |
| 1' | BLACK SLATE | 35' |
| 1' | SMALL VOID | 36' |
| 5' | COAL | 41' |
| 28' | FRACTURED SANDSTONE | 69' |

**HOLE Nº 3** SURFACE EL. 867.2

| STRATA CUT | | TOTAL |
|---|---|---|
| 10' | FILL | 10' |
| 21' | SANDSTONE & CLAY | 31' |

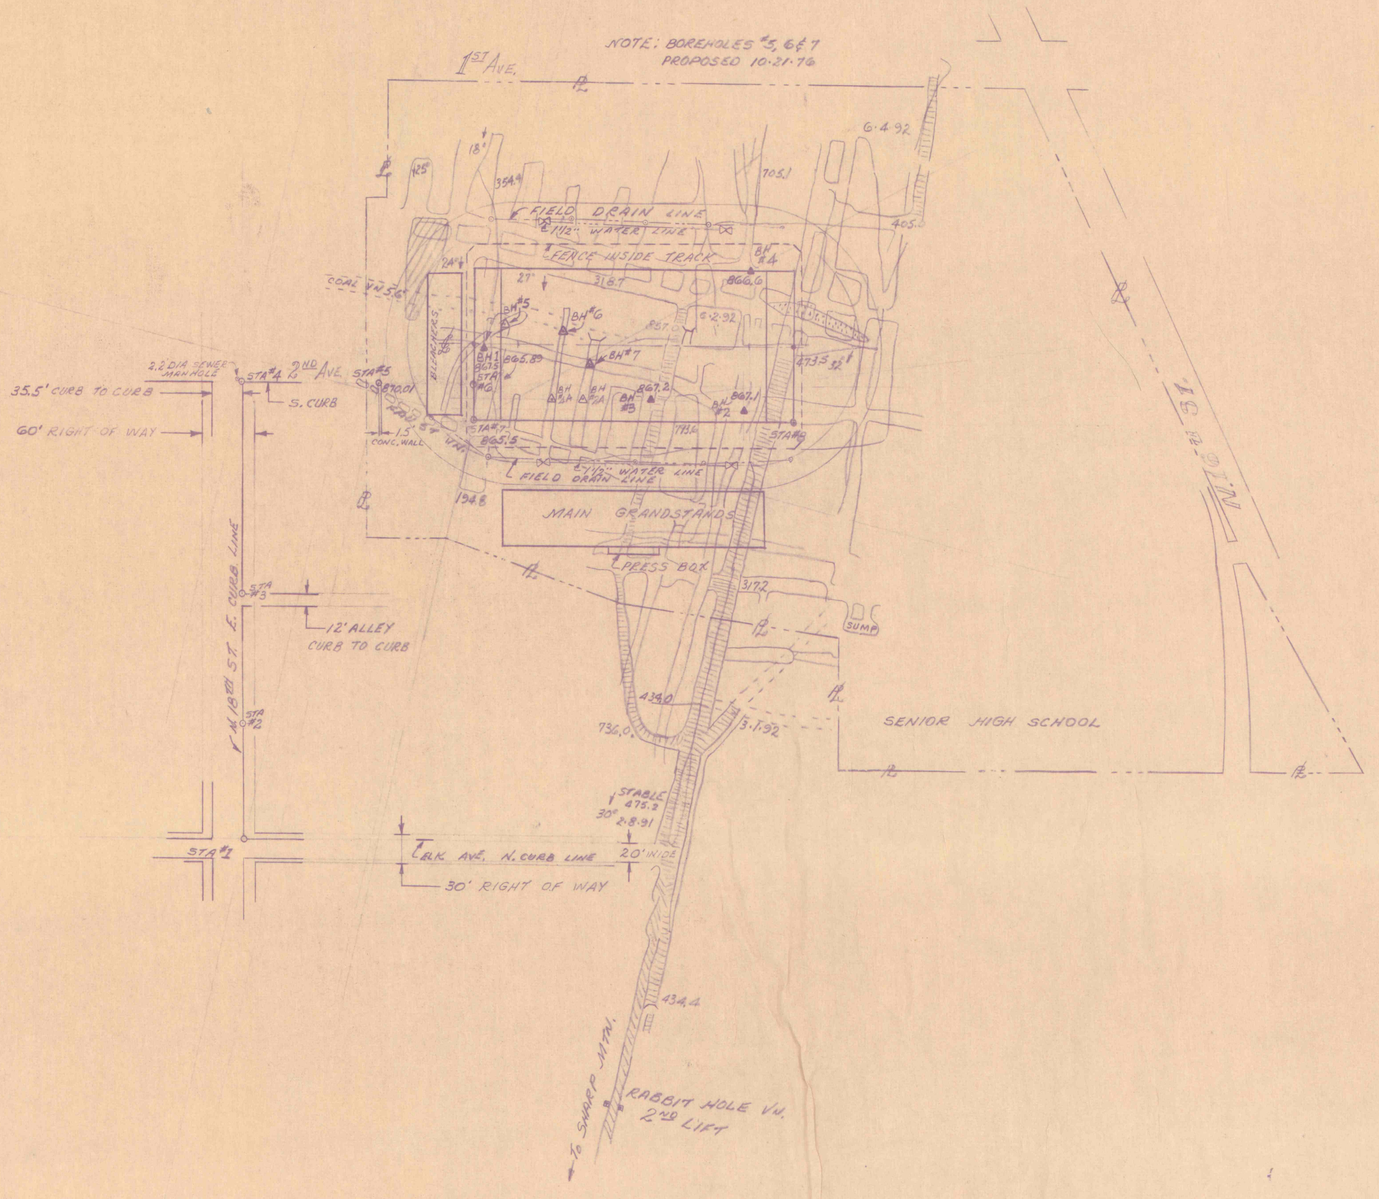


POTTSVILLE AND YORK FARM
SURFACE & MINE WORKINGS IN
VICINITY OF POTTSVILLE HI-SCHOOL
VETERANS MEMORIAL STADIUM
SCALE 1" = 100' 9-21-76, 9-27-76 & 10-12-76
DEPT. OF ENVIR. RESOURCES

PROJECT Nº SL-458

SURVEY SEPT. 28, 1976