


Project 46-D
B.H. No. 9 Main Vein
West Bear Ridge Coll'y.
(June '70)

RTR
5
PJR

COLLIERY

FPWEISER A.E.

N.W.C.P. 46-D
B.H. No. 9 Main Vein
WEST BEAR RIDGE COLLIERY
June '70

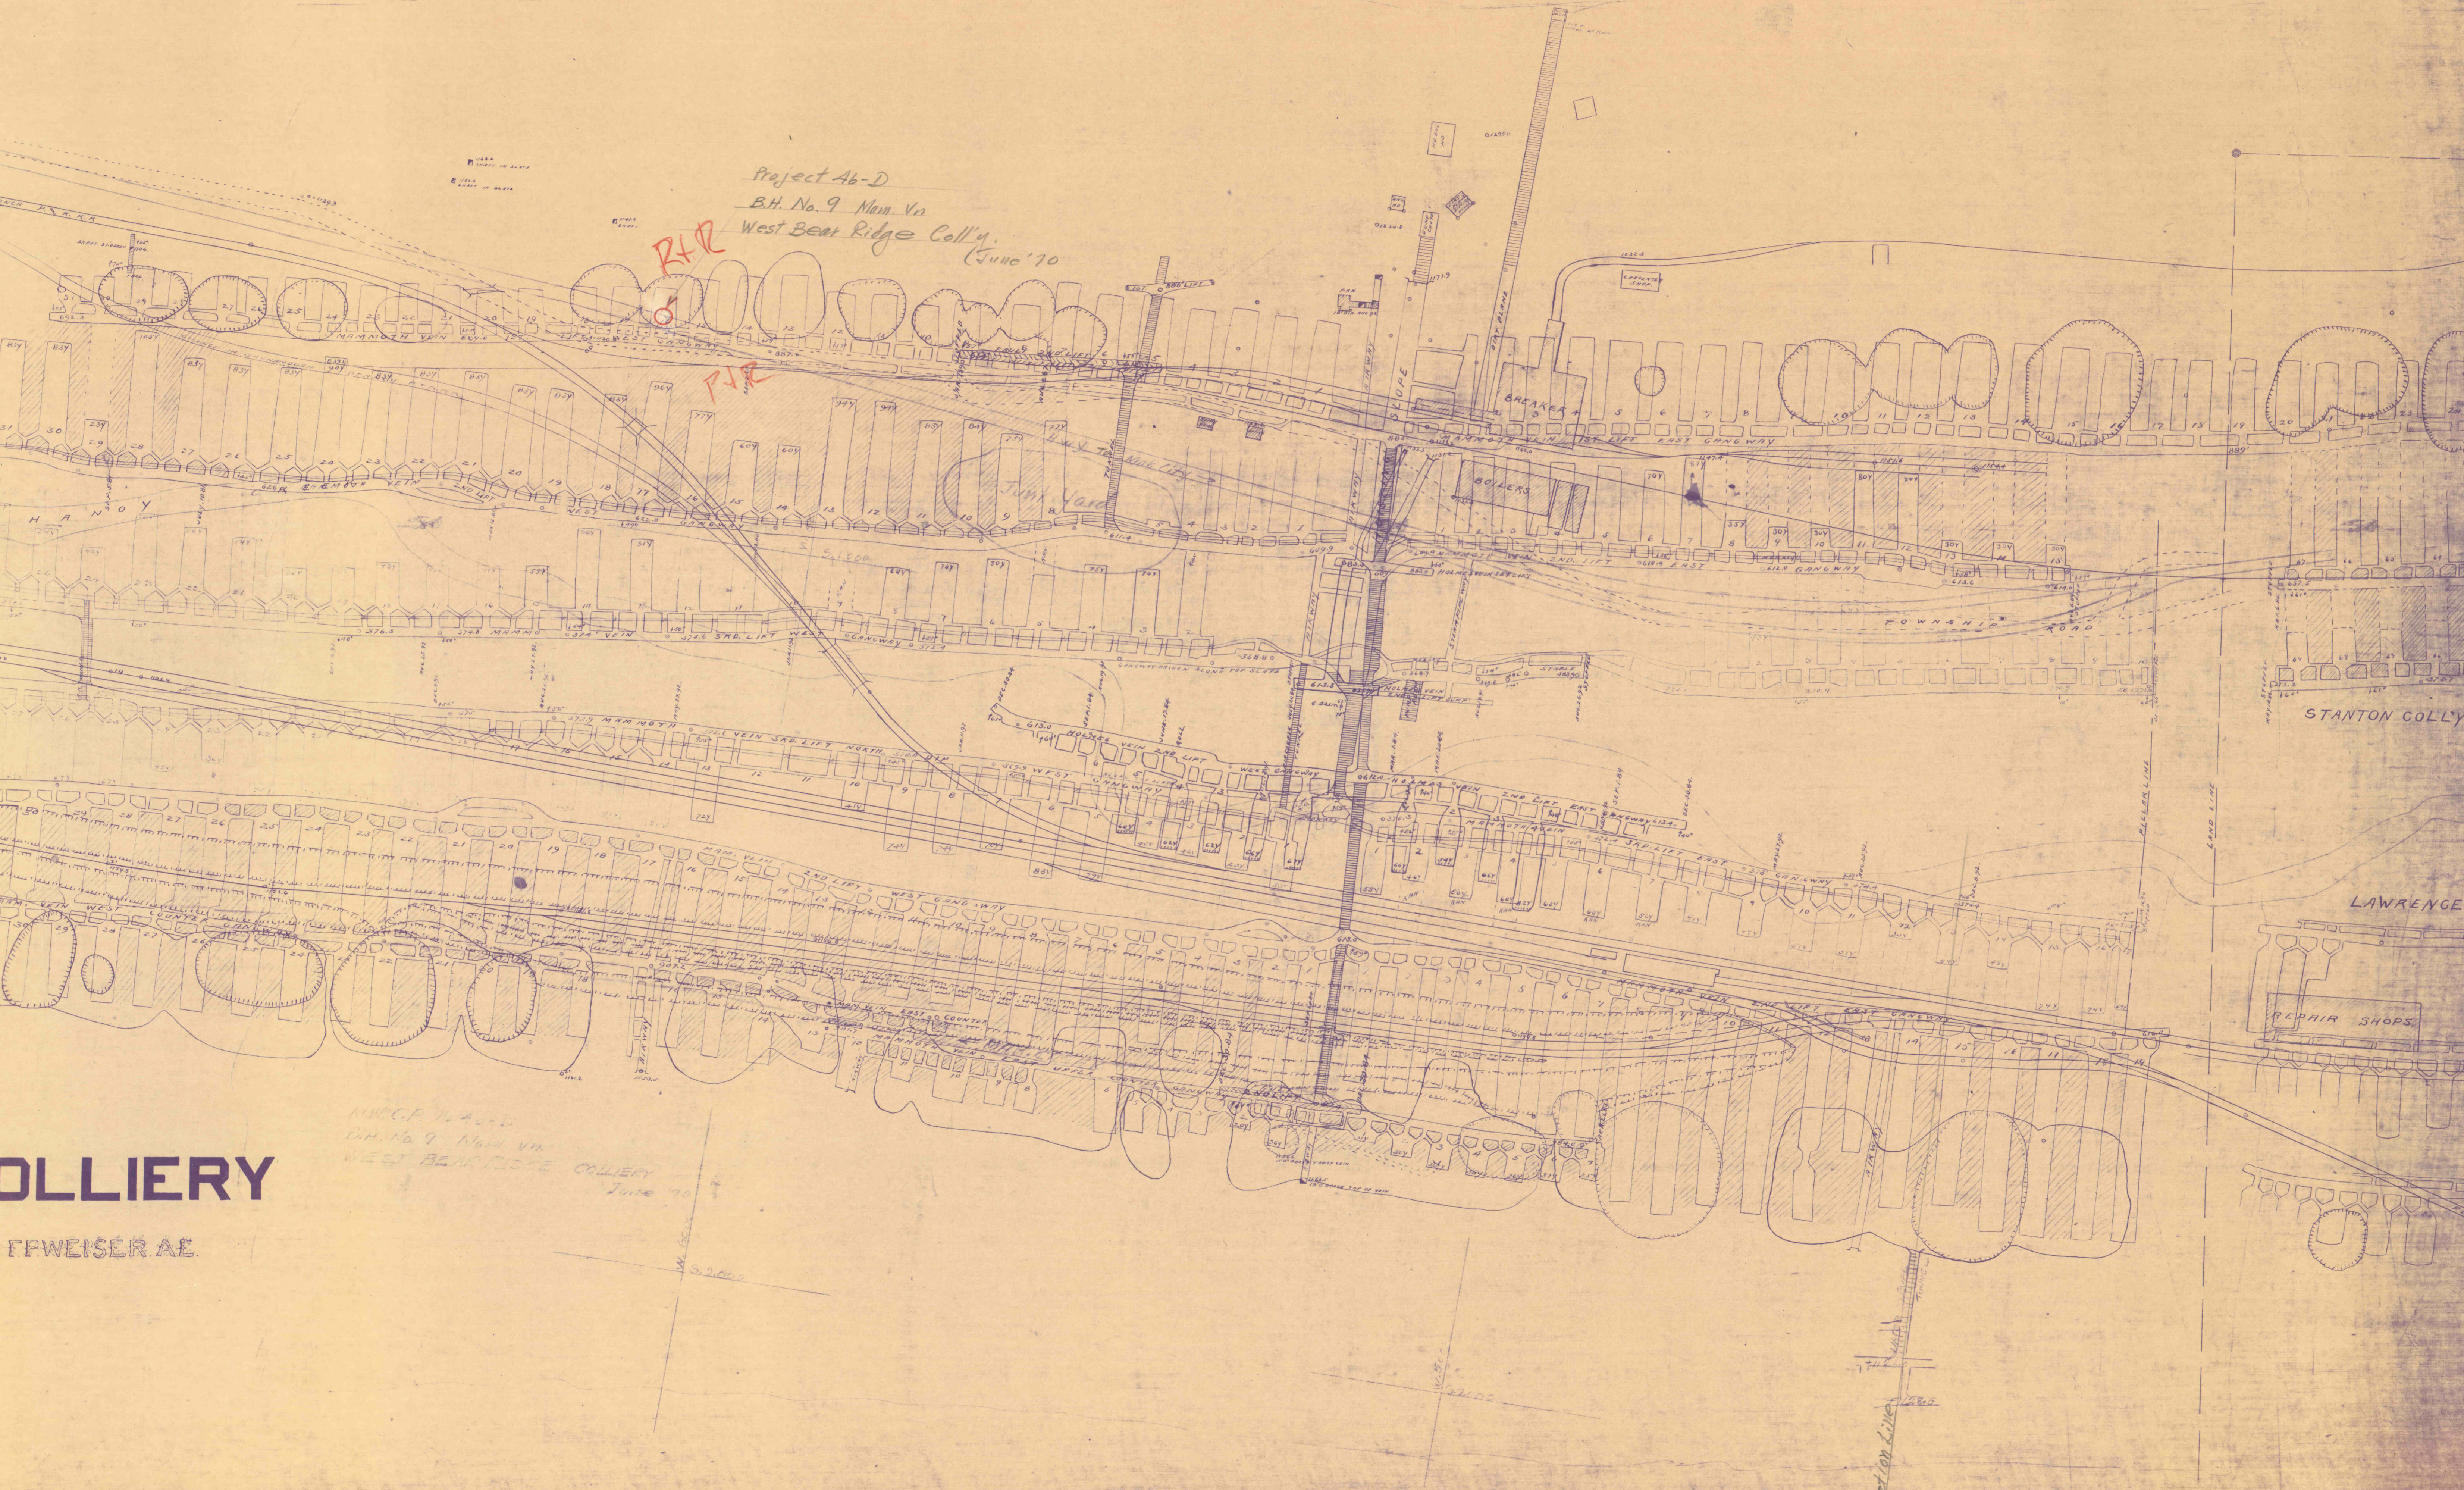

STANTON COLLY

LAWRENCE

REPAIR SHOPS

Section Line