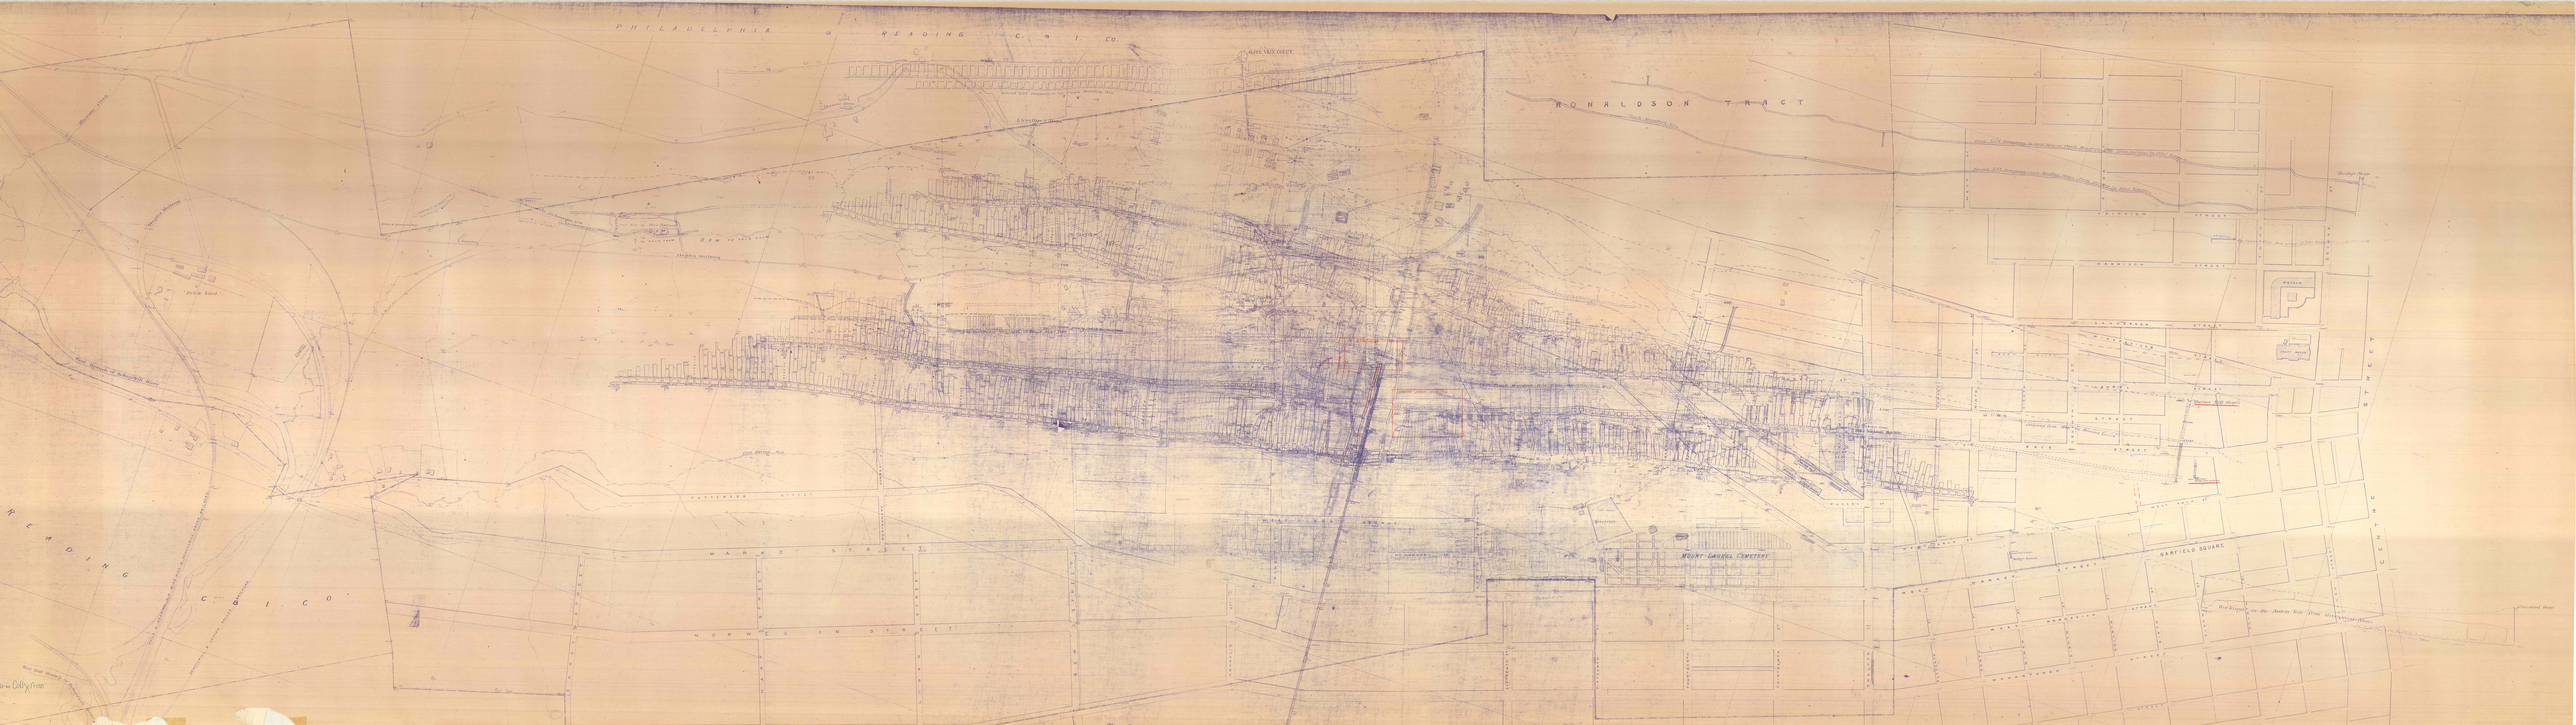
PHILADELPHIA & READING C & I Co
GIRARD VEIN COLLY
RONALDSON TRACT
READING C & I CO.
MARKET STREET
NORWEGIAN STREET
MOUNT LAUREL CEMETERY
GARFIELD SQUARE
BROADWAY