



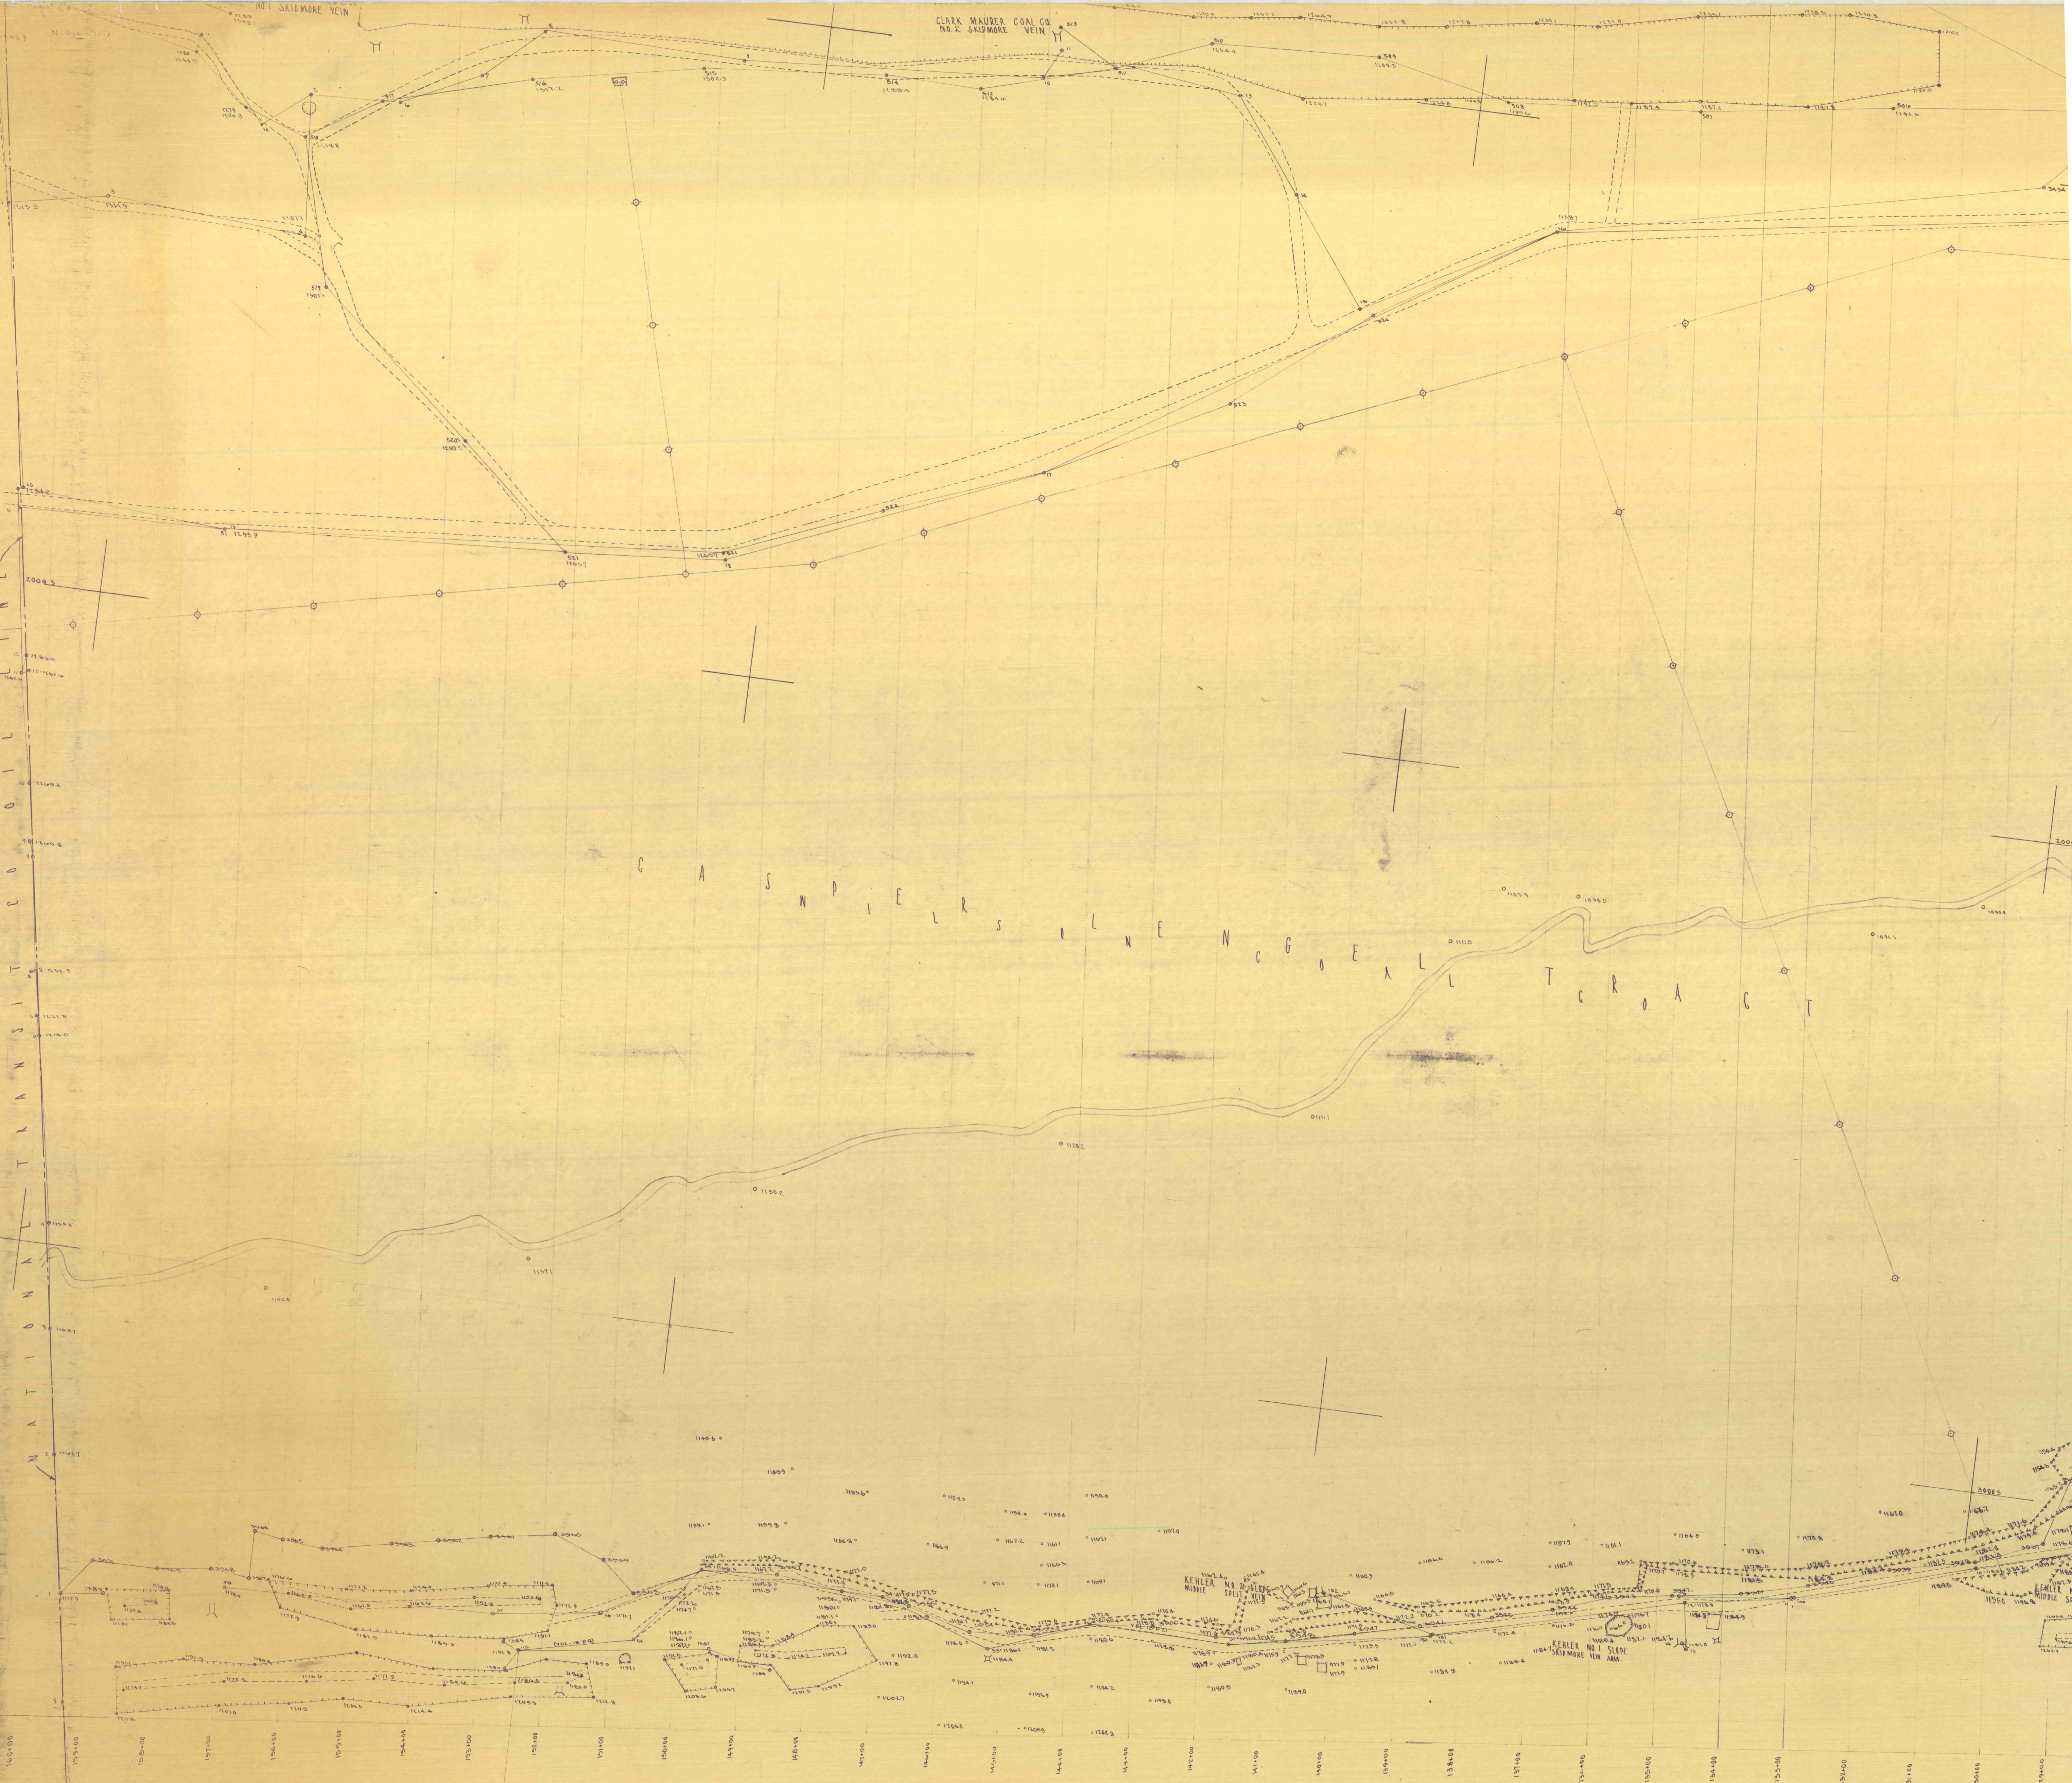

N A T I O N A L T R A N S I T C O I L I N E



KEHLER NO. 1 SKIDMORE VEIN

KEHLER NO. 2 SKIDMORE VEIN

