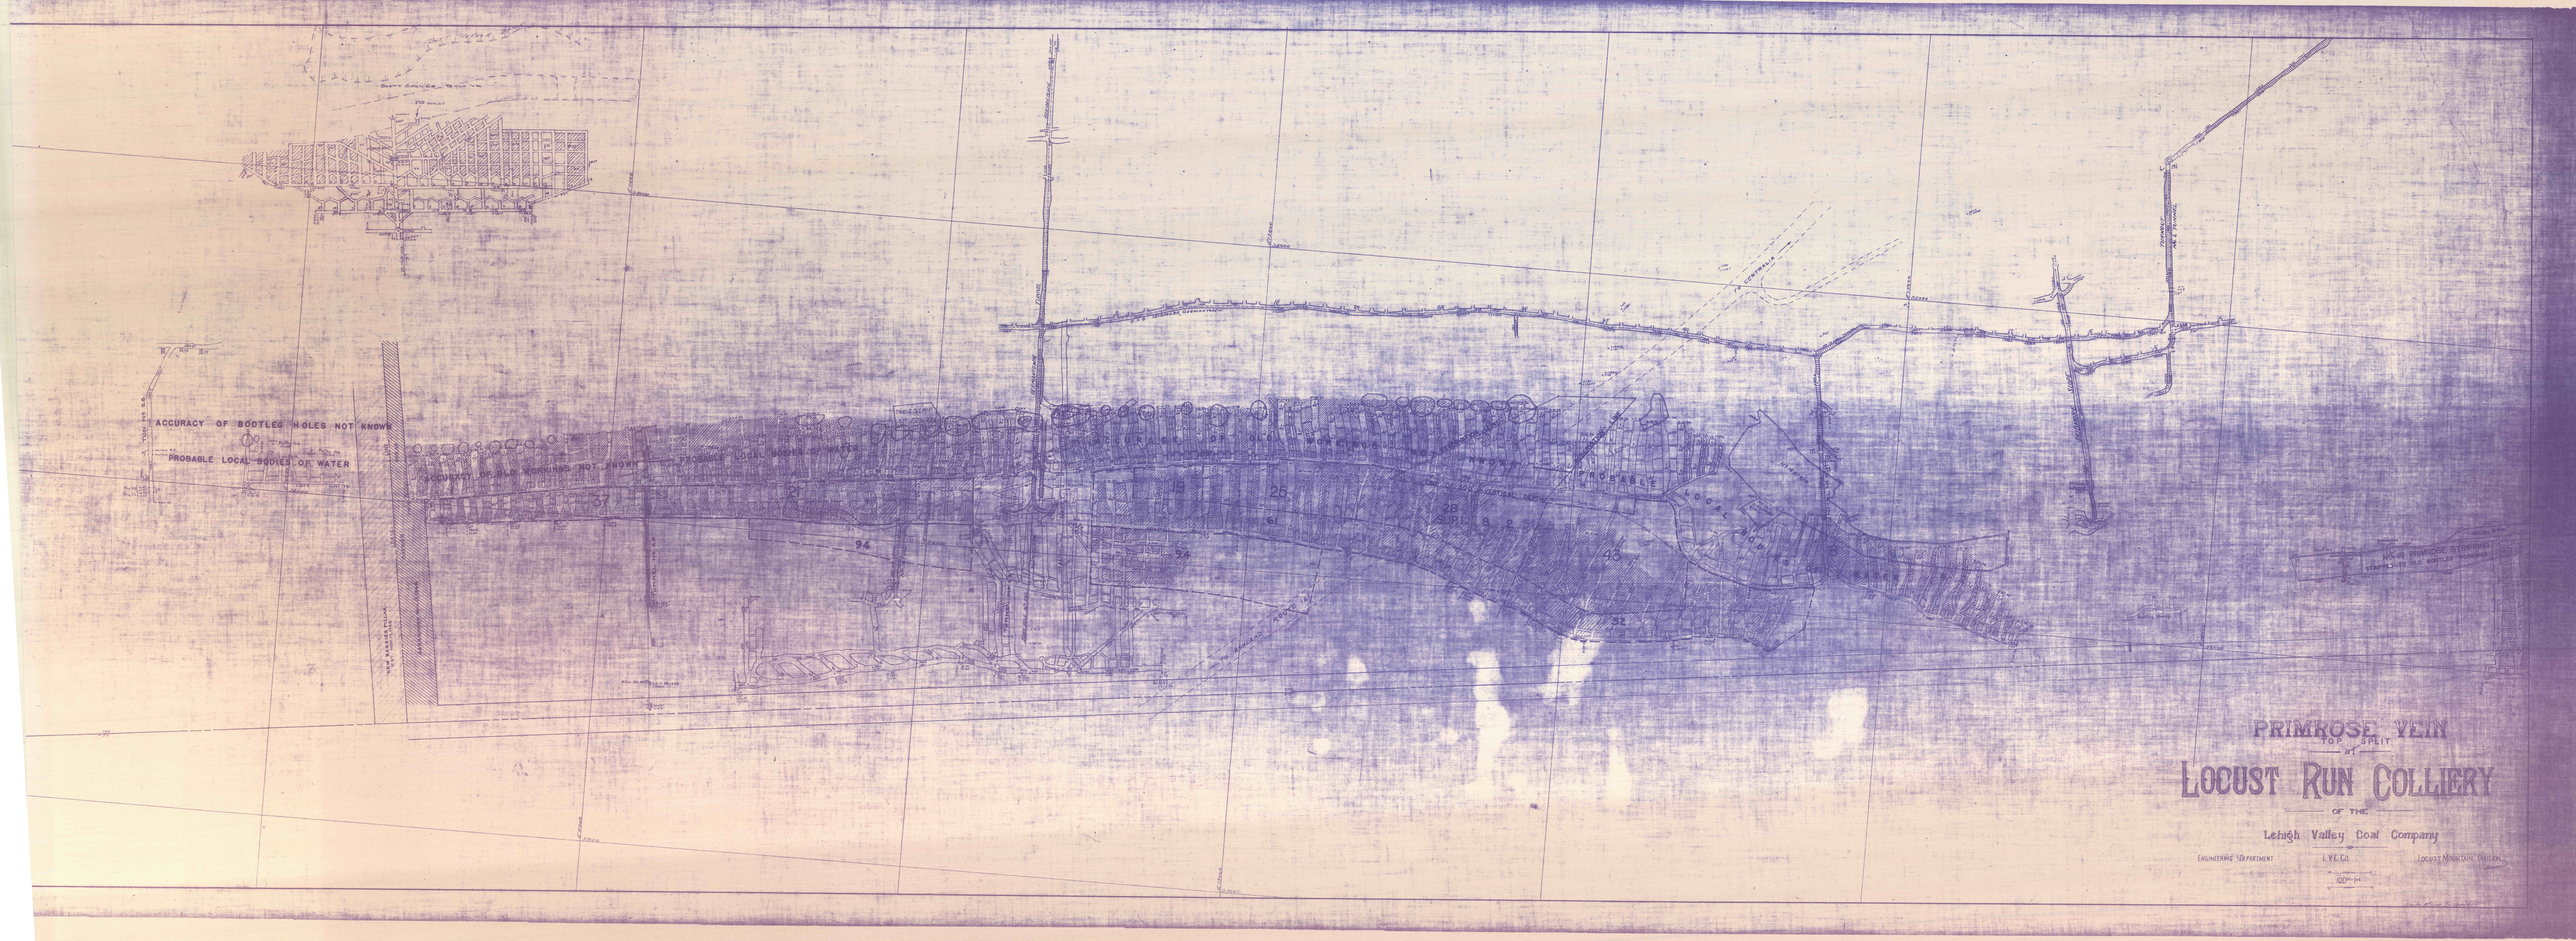
ACCURACY OF BOOTLEG HOLES NOT KNOWN
PROBABLE LOCAL BODIES OF WATER
ACCURACY OF OLD WORKINGS NOT KNOWN
PROBABLE LOCAL BODIES OF WATER
PROBABLE LOCAL BODIES OF WATER
PRIMROSE VEIN
TOP SPLIT
LOCUST RUN COLLIERY
OF THE
Lehigh Valley Coal Company
ENGINEERING DEPARTMENT
L.V.C.CO.
LOCUST MOUNTAIN DIVISION