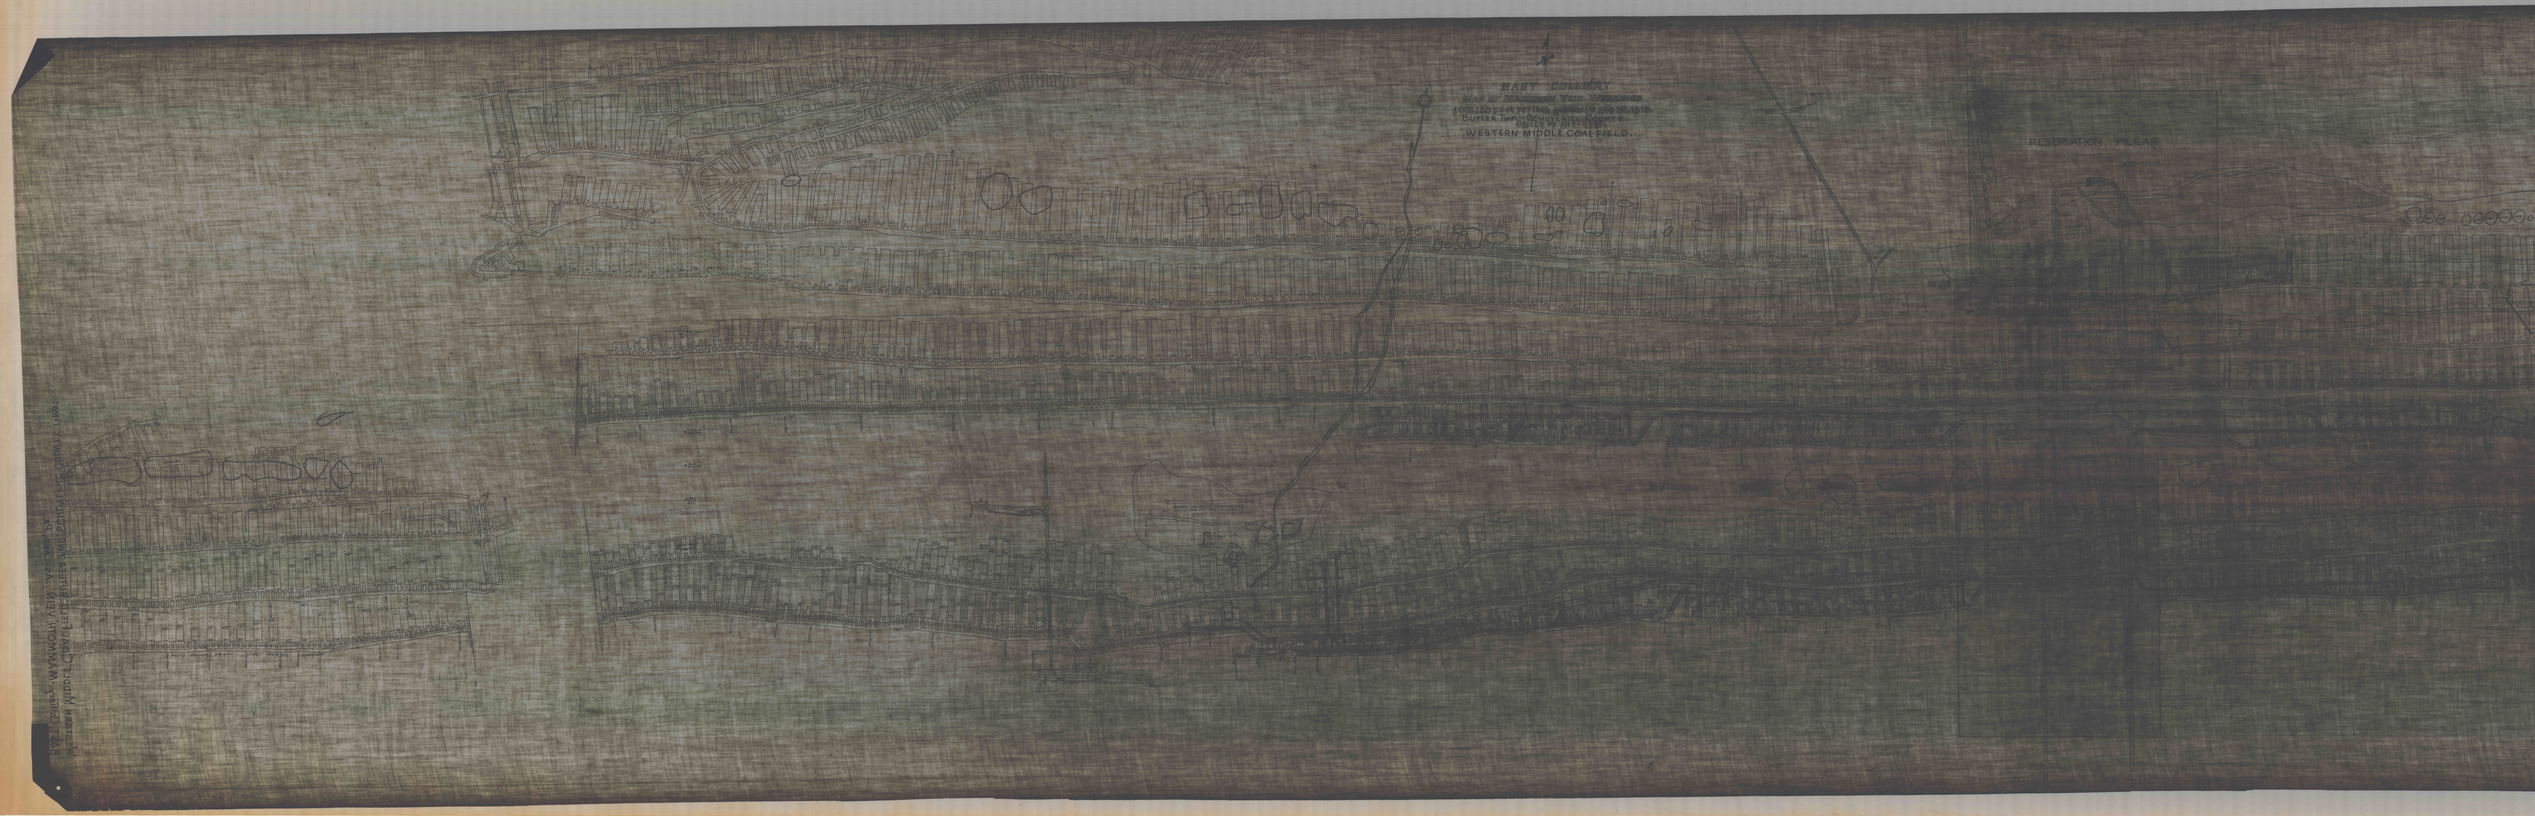
EAST COLLIERY
MAP OF MAXWELL VEIN WORKINGS
SCALE 100 FEET PER INCH, PRESENTED AUG 25, 1918.
BUTLER TWP., SCHUYLKILL COUNTY.
WESTERN MIDDLE COAL FIELD.
RESERVATION PILLAR