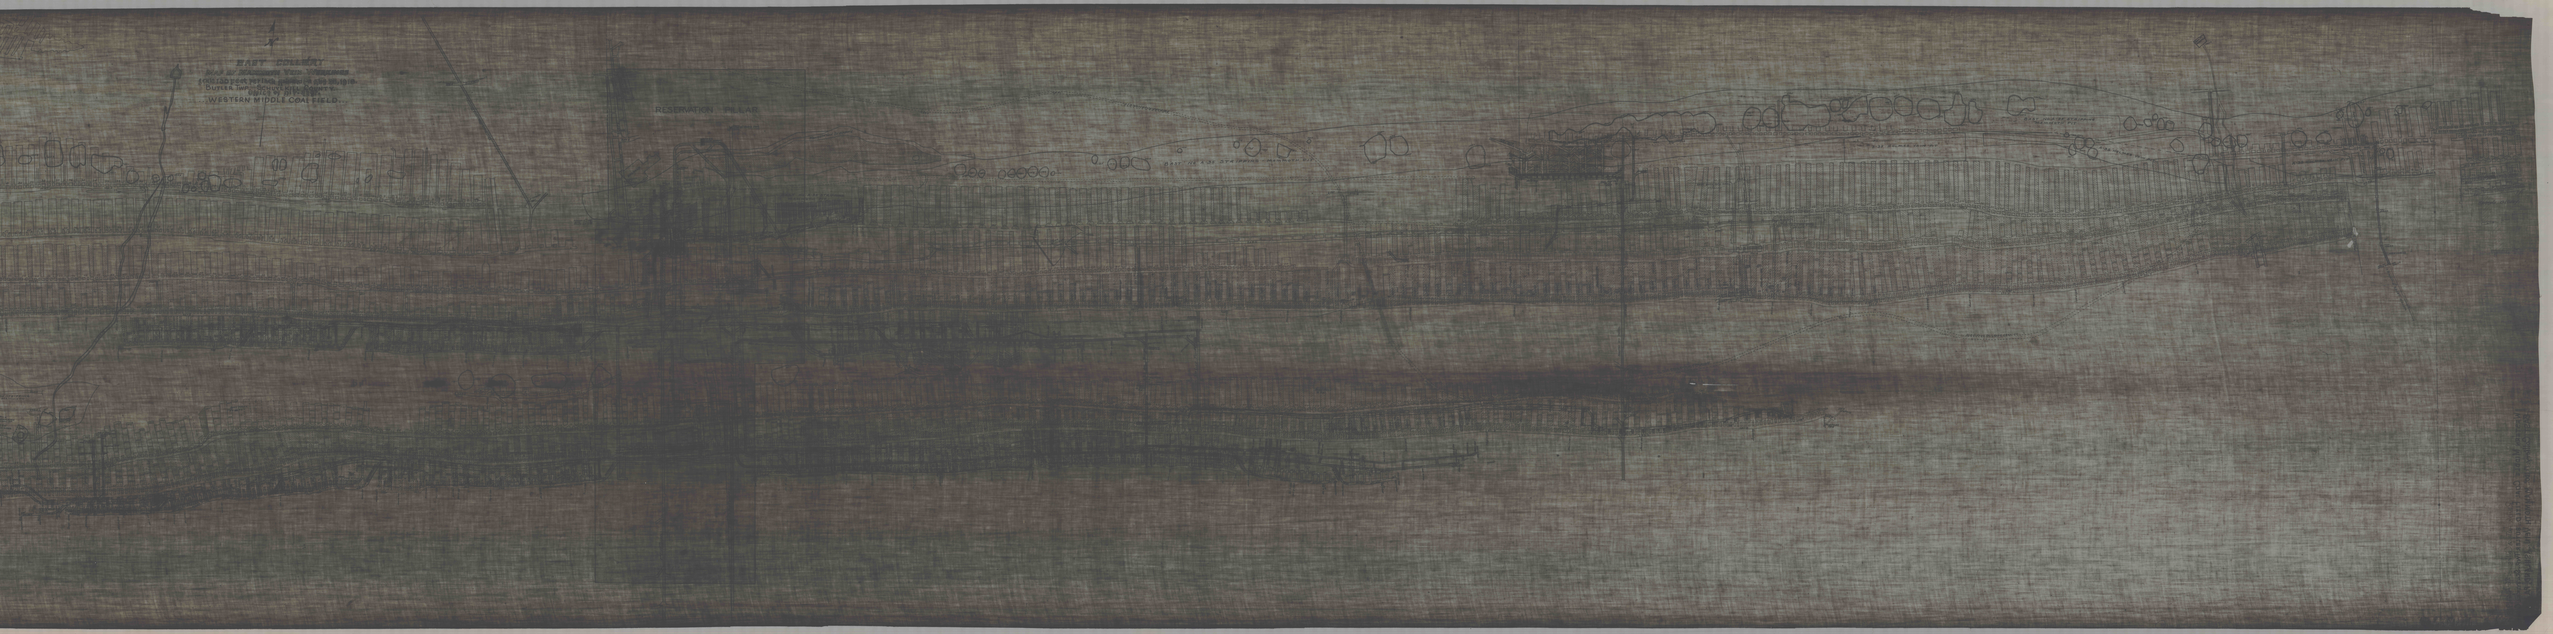
EAST COLLIERY
WESTERN MIDDLE COAL FIELD
RESERVATION PILLAR