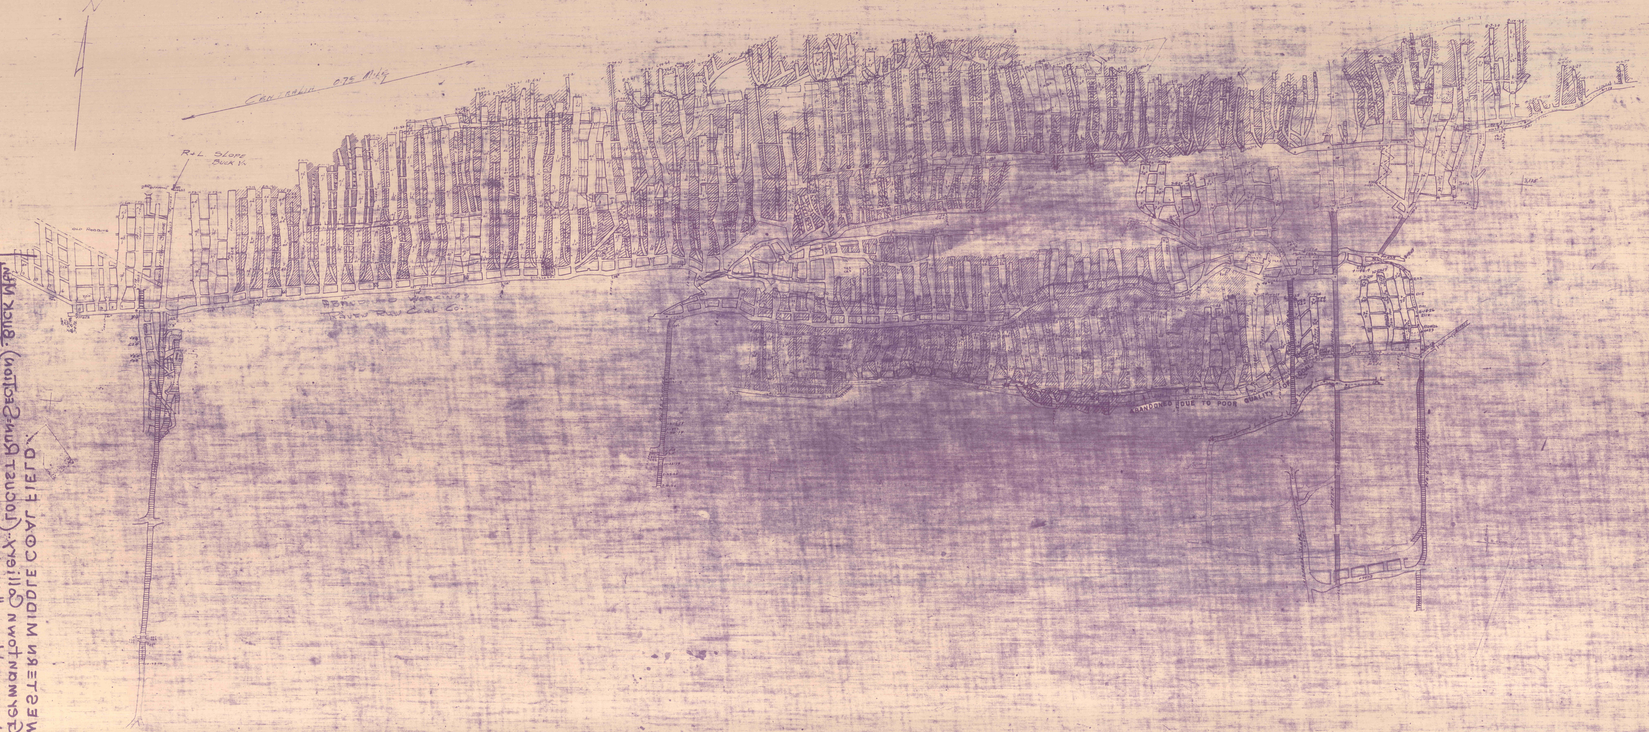

..WESTERN MIDDLE FIELD..

BUCK MT. LEADER VEIN

at

LOCUST RUN COLLIERY

OF THE

NORTH CONYNGHAM TWP. COLUMBIA CO.,

Lehigh Valley Coal Company

ENGINEERING DEPARTMENT L.V.C.CO. MAHANOY AND SHAMOKIN DIVISION

1909-14

Posted 28 [illegible]

Posted 2 [illegible]

Posted 2 [illegible]

Posted 2 [illegible]

Posted 2 [illegible]

Posted 2 [illegible]

STATE MINE INSPECTOR

County, Pa. Lehigh Valley Coal Corporation's Anthracite Coal Lands

Leader Vein, 1" = 100'. North Conyngham Twp. Columbia Co.

Fernwarton Colliery (Locust Run Section) Buck Mtn.

Western Middle Coal Field

GREEN TAG

G-18