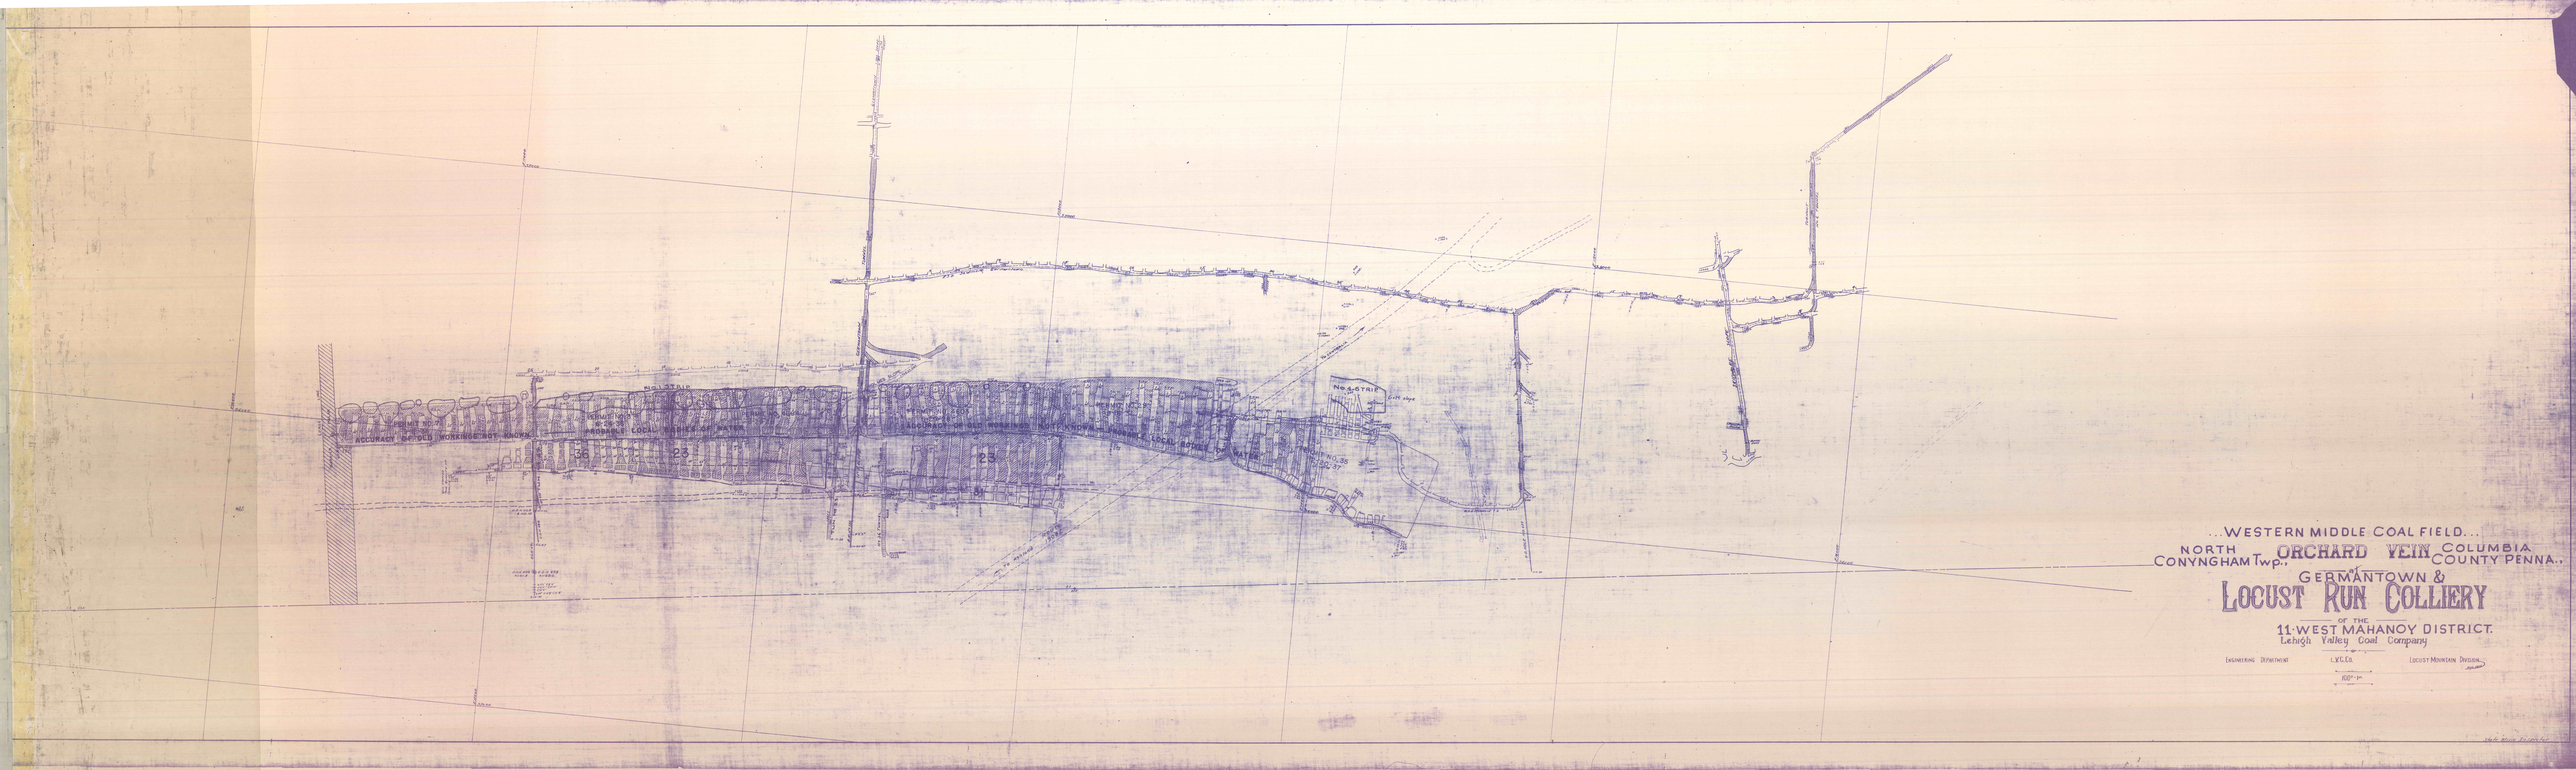
...WESTERN MIDDLE COAL FIELD...
NORTH ORCHARD VEIN COLUMBIA
CONYNGHAM Twp., COUNTY PENNA..
GERMANTOWN &
LOCUST RUN COLLIERY
OF THE
11 WEST MAHANOY DISTRICT.
Lehigh Valley Coal Company
ENGINEERING DEPARTMENT
L.V.C.Co.
LOCUST MOUNTAIN DIVISION.
160th Pm
No. 6 STRIP
Lift ships
PROBABLE LOCAL DEPTH OF WATER
36
23
23
8