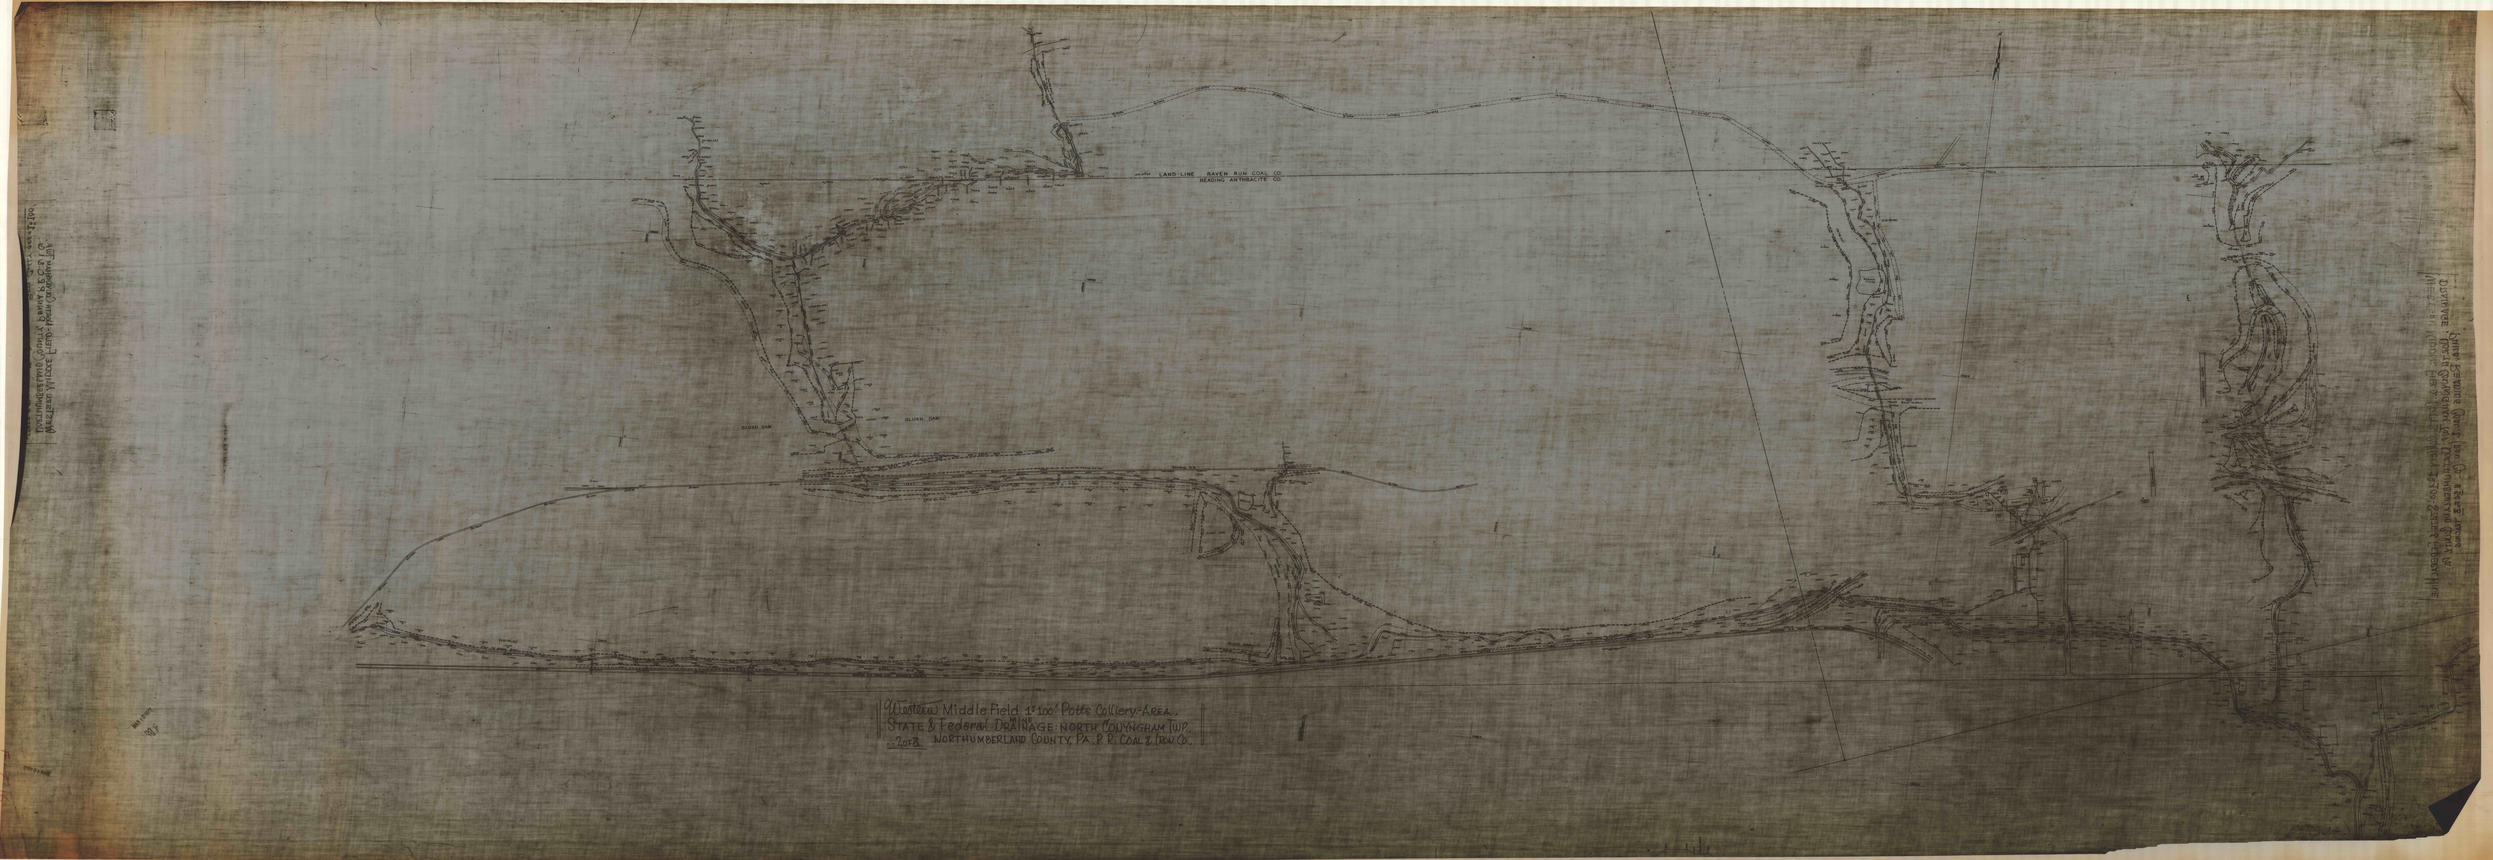


Western Middle Field 1"=100' Potts Colliery Area.
State & Federal Drainage: North Conyngham Twp.
Sheet 1 of 3 Northumberland County, Pa. P. R. Coal & Iron Co.

F-7-16