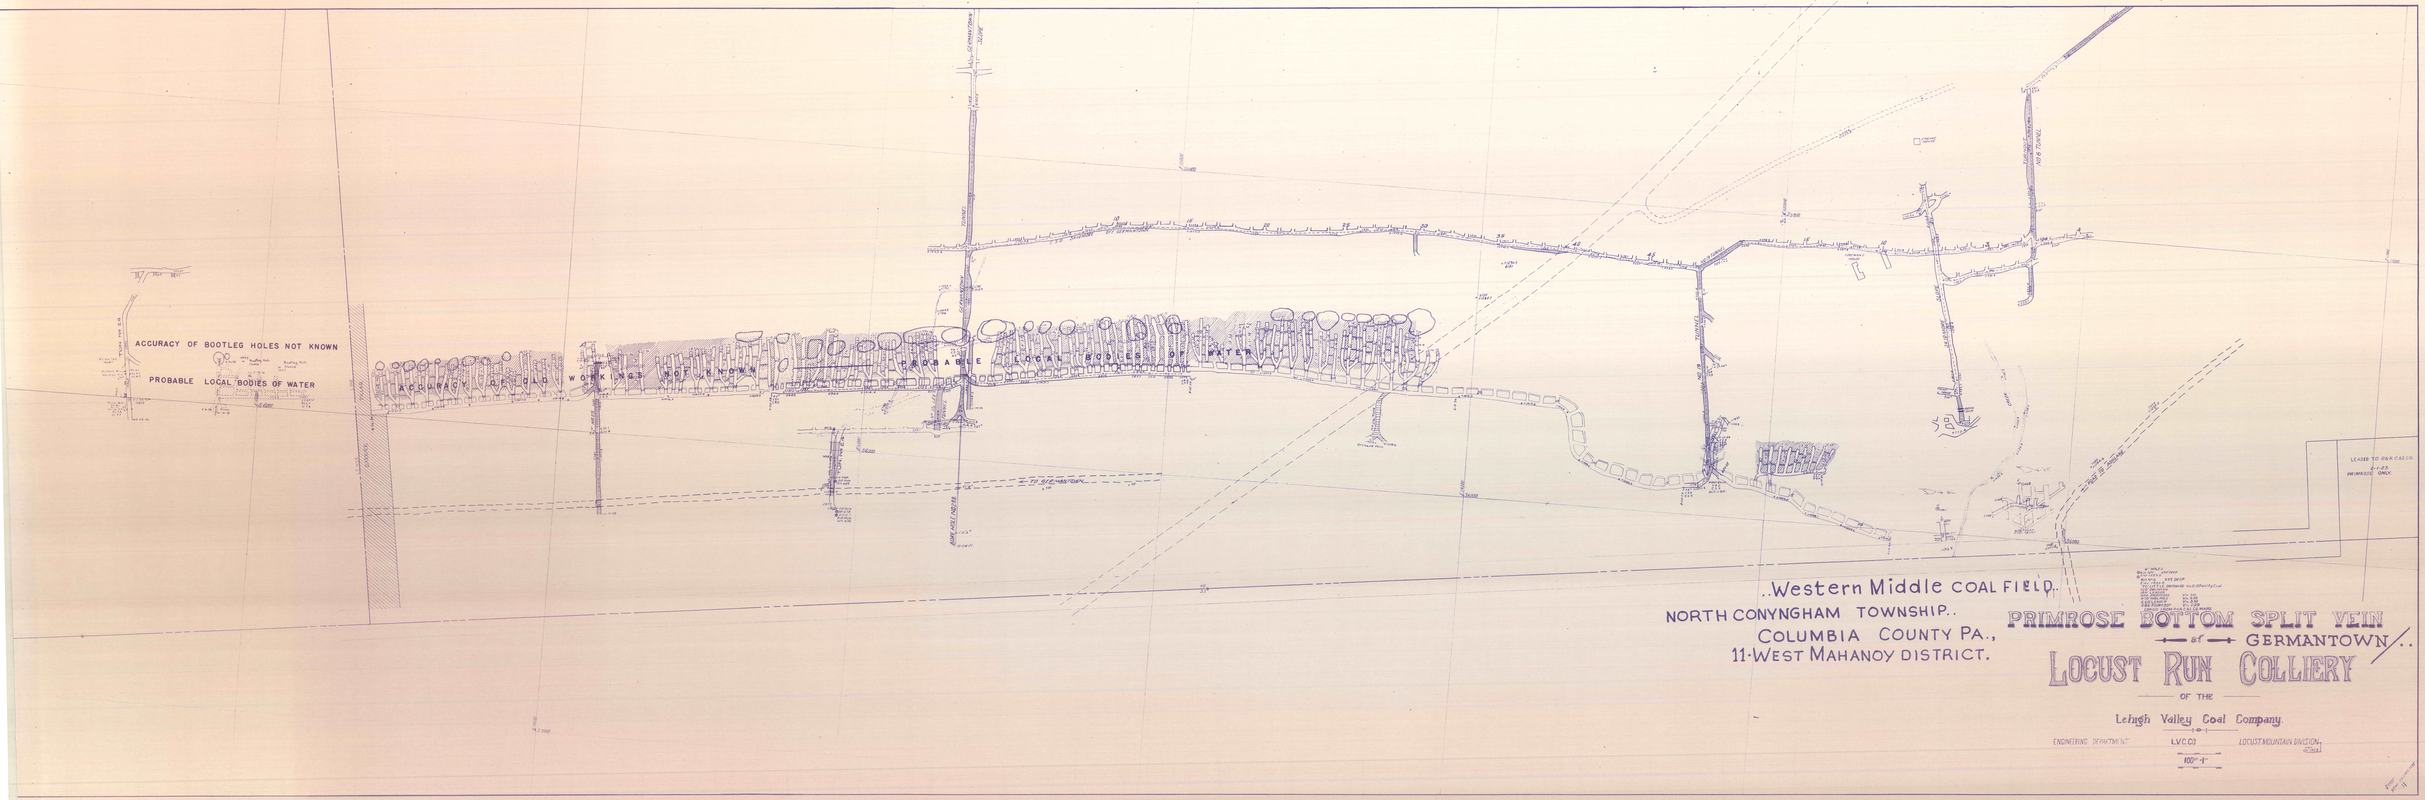
ACCURACY OF BOOTLEG HOLES NOT KNOWN
PROBABLE LOCAL BODIES OF WATER
ACCURACY OF OLD WORK NOT KNOWN
PROBABLE LOCAL BODIES OF WATER
..Western Middle COAL FIELD..
NORTH CONYNGHAM TOWNSHIP..
COLUMBIA COUNTY PA.,
11-WEST MAHANOY DISTRICT.
PRIMROSE BOTTOM SPLIT VEIN
of GERMANTOWN..
LOCUST RUN COLLIERY
OF THE
Lehigh Valley Coal Company.
ENGINEERING DEPARTMENT
L.V.C.CO
LOCUST MOUNTAIN DIVISION.
100 ft = 1"