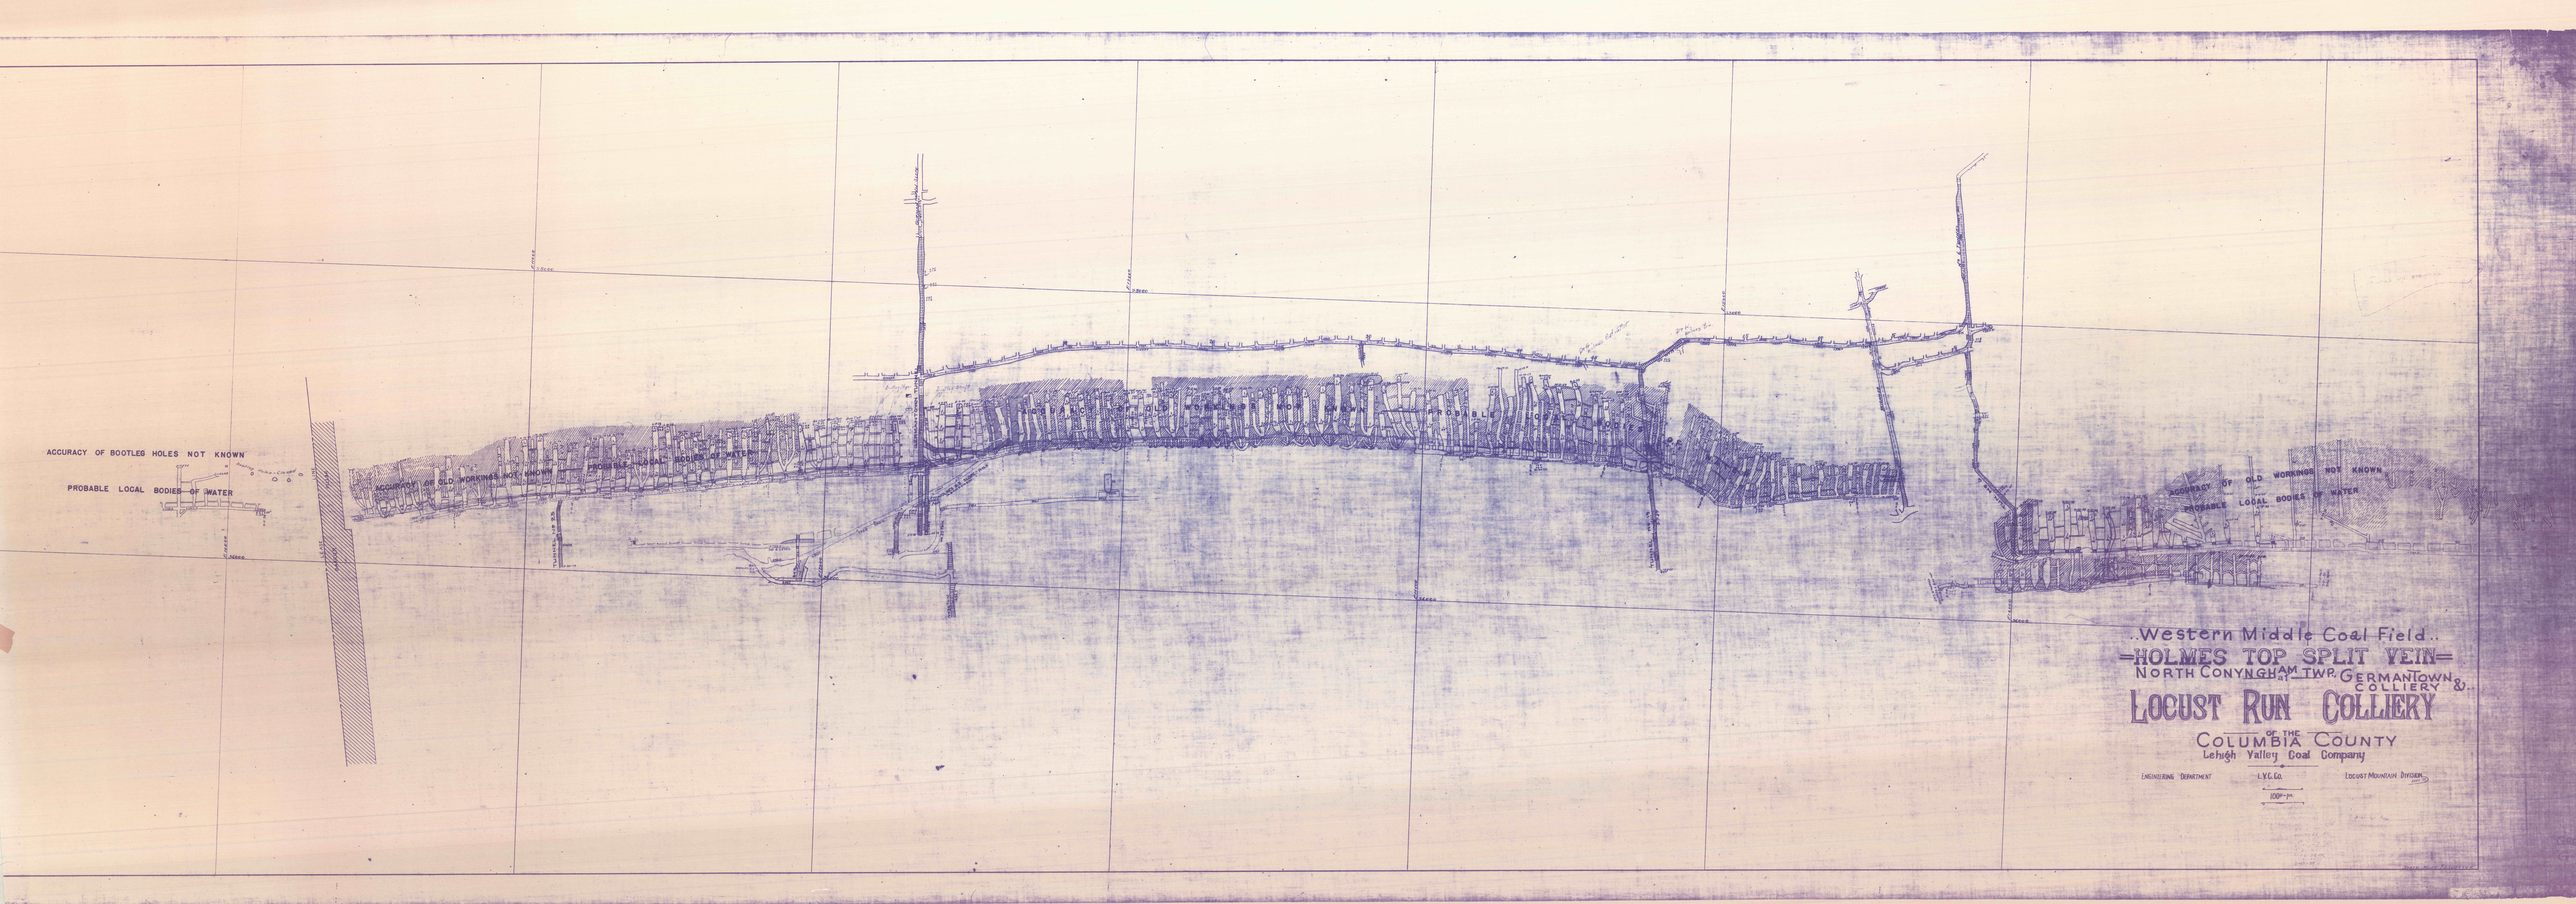
ACCURACY OF BOOTLEG HOLES NOT KNOWN
PROBABLE LOCAL BODIES OF WATER
ACCURACY OF OLD WORKINGS NOT KNOWN
PROBABLE LOCAL BODIES OF WATER
ACCURACY OF OLD WORKINGS NOT KNOWN
PROBABLE LOCAL BODIES OF WATER
..Western Middle Coal Field..
=HOLMES TOP SPLIT VEIN=
NORTH CONYNGHAM TWP. GERMANTOWN & COLLIERY
LOCUST RUN COLLIERY
OF THE
COLUMBIA COUNTY
Lehigh Valley Coal Company
ENGINEERING DEPARTMENT
L.V.C.Co.
LOCUST MOUNTAIN DIVISION
100'-0"