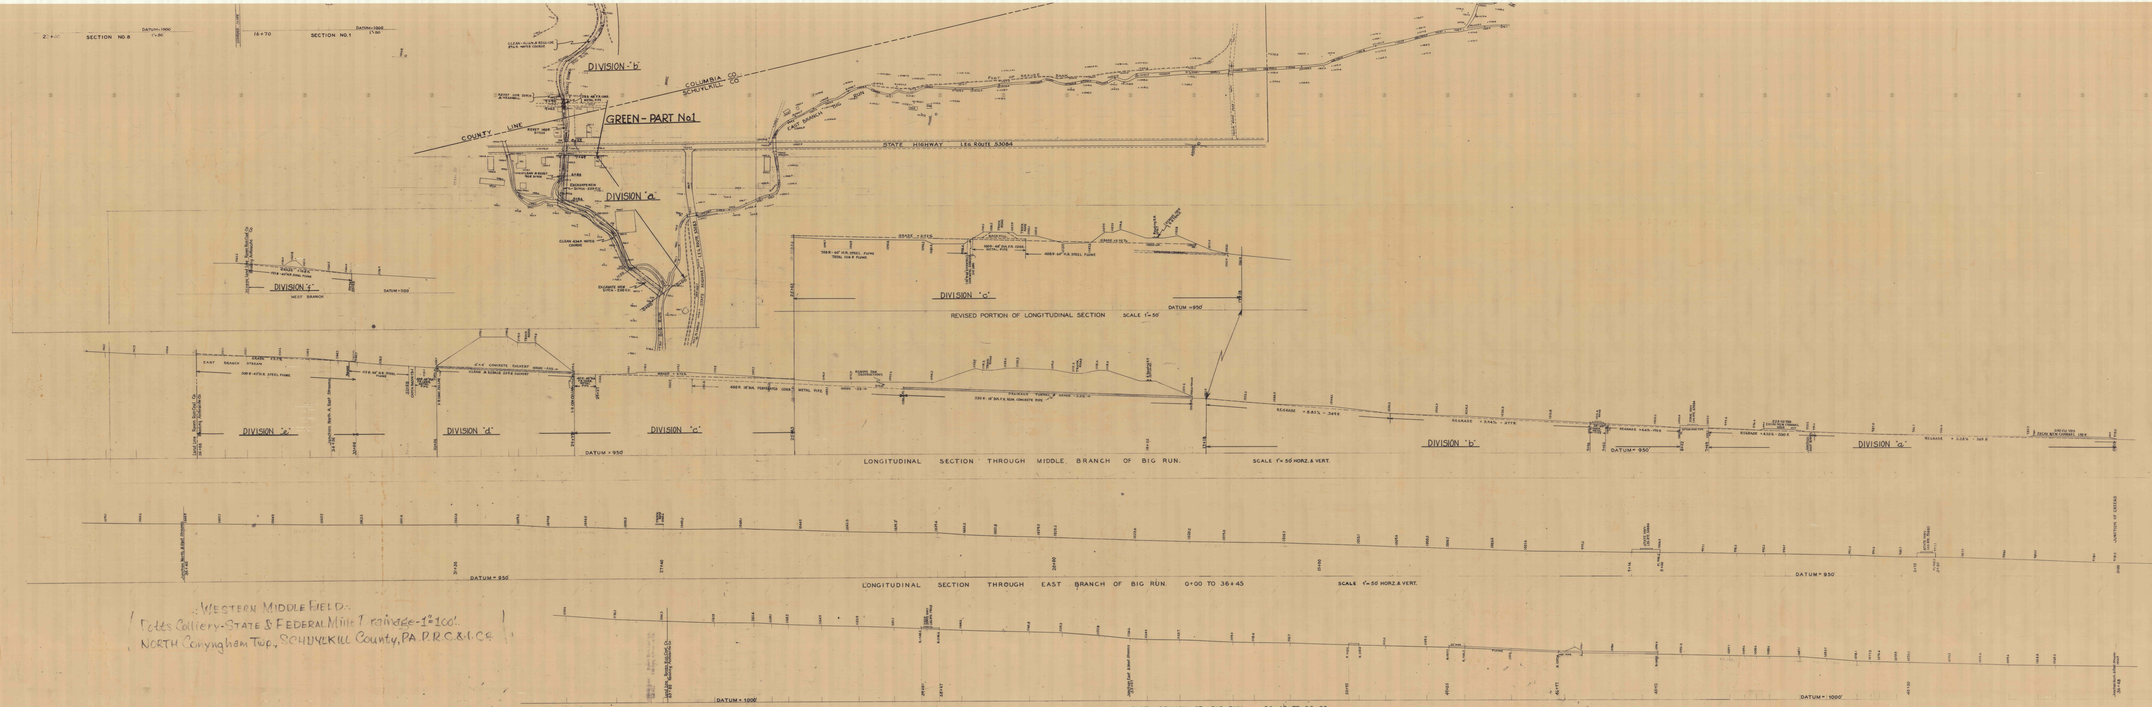

WESTERN MIDDLE FIELD
Potts Colliery - State & Federal Mine Drainage - 1" = 100'
NORTH Cerrynham Twp., SCHUYLKILL County, PA P.R.C.&I.Co