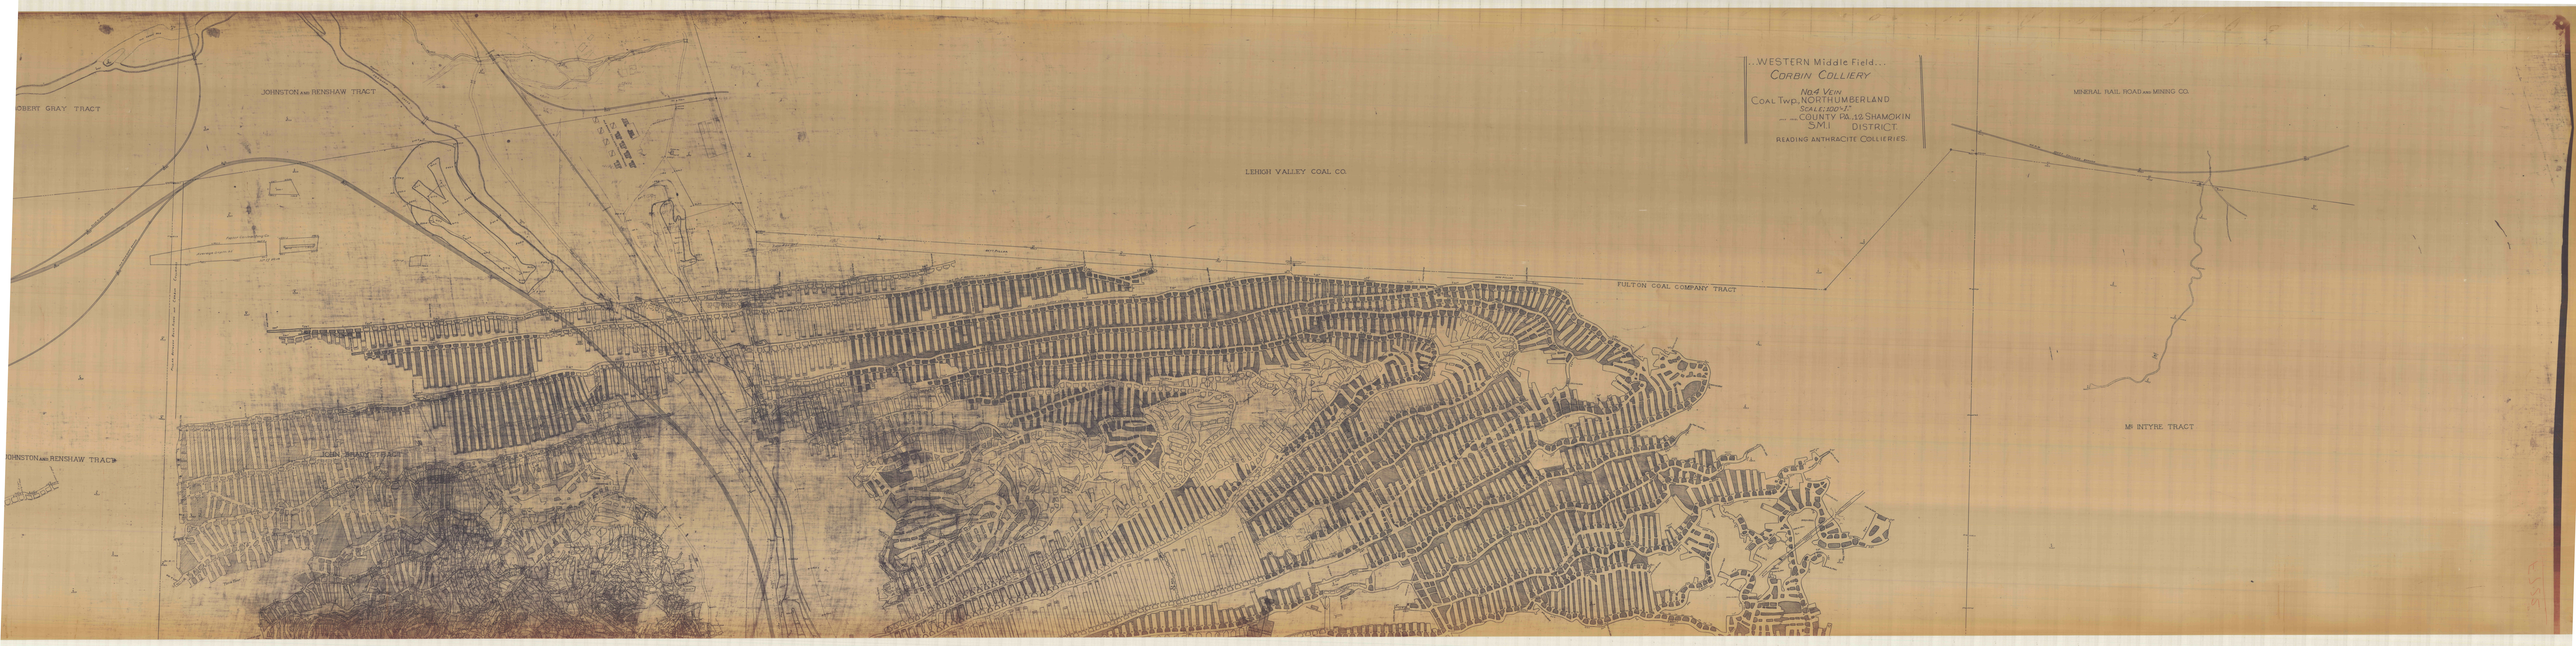
WESTERN Middle Field...
CORBIN COLLIERY
Nod VEIN
COAL Twp. NORTHUMBERLAND
SCALE: 100'=1"
COUNTY PA. 12 SHAMOKIN
SM1
DISTRICT
READING ANTHRACITE COLLIERIES
OBERT GRAY TRACT
JOHNSTON AND RENSHAW TRACT
LEHIGH VALLEY COAL CO.
FULTON COAL COMPANY TRACT
MINERAL RAIL ROAD AND MINING CO.
Mc INTYRE TRACT
JOHNSTON AND RENSHAW TRACT