

55-17

JOHNST

ROBERT GRAY TRACT

OLD CREEK BED

2467

2728

28168

16 87.6

26.15

21005

2728

226.1

280.2

17 87.7

Fidler Contracting Co.

Average Depth 35'

No. 1 Vein

282.3

287.3

282.3

280.2

282.3

280.2

PILLAR BETWEEN BUCK RIDGE AND CORBIN COLLIERIES



THOM FAULT

JOHNSTON AND RENSHAW TRACT

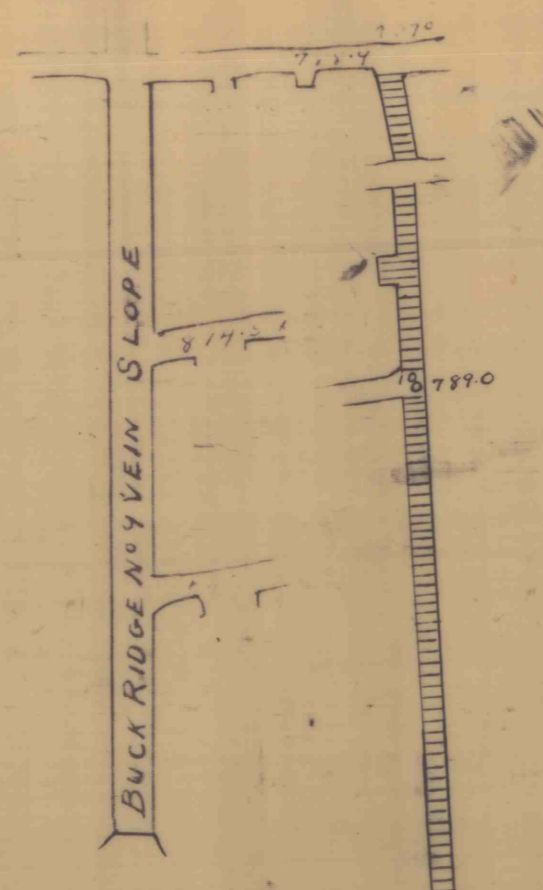

Buck Ridge No. 1 Vein Workings  
No. 1 Vein Water Level.

Anticipate  
business