


F.7.22

M<sup>c</sup>INTYRE TRACT

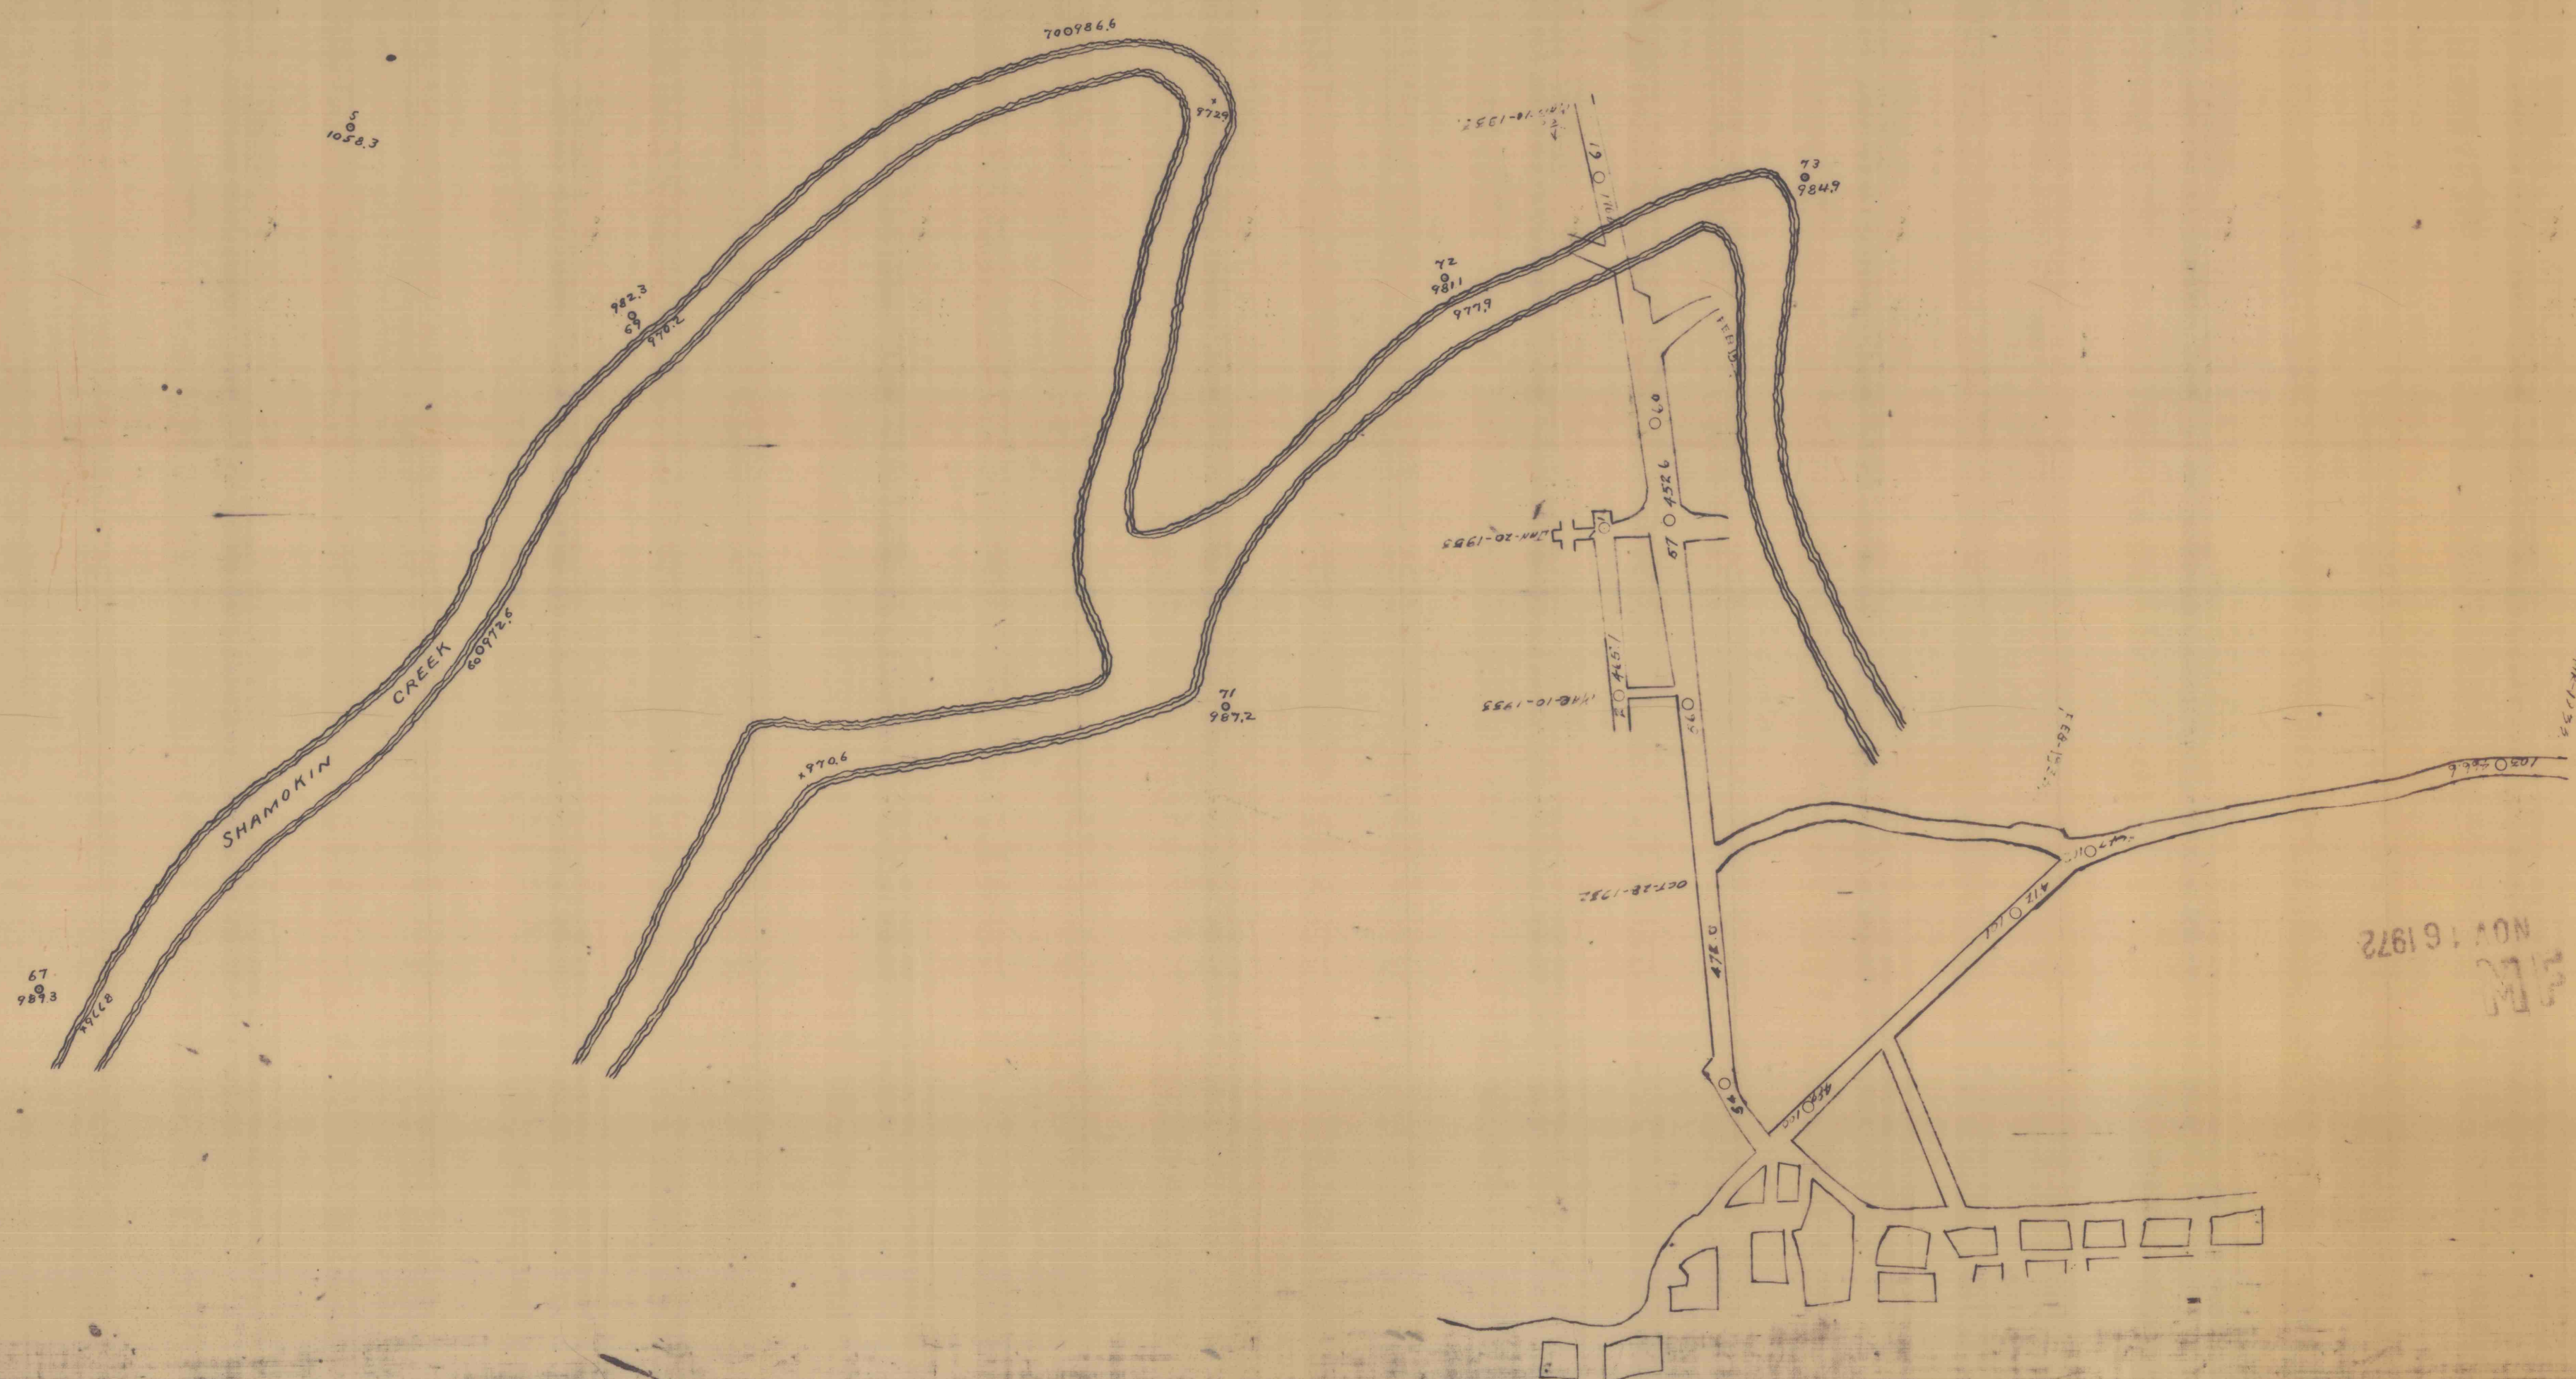

NOV 16 1972