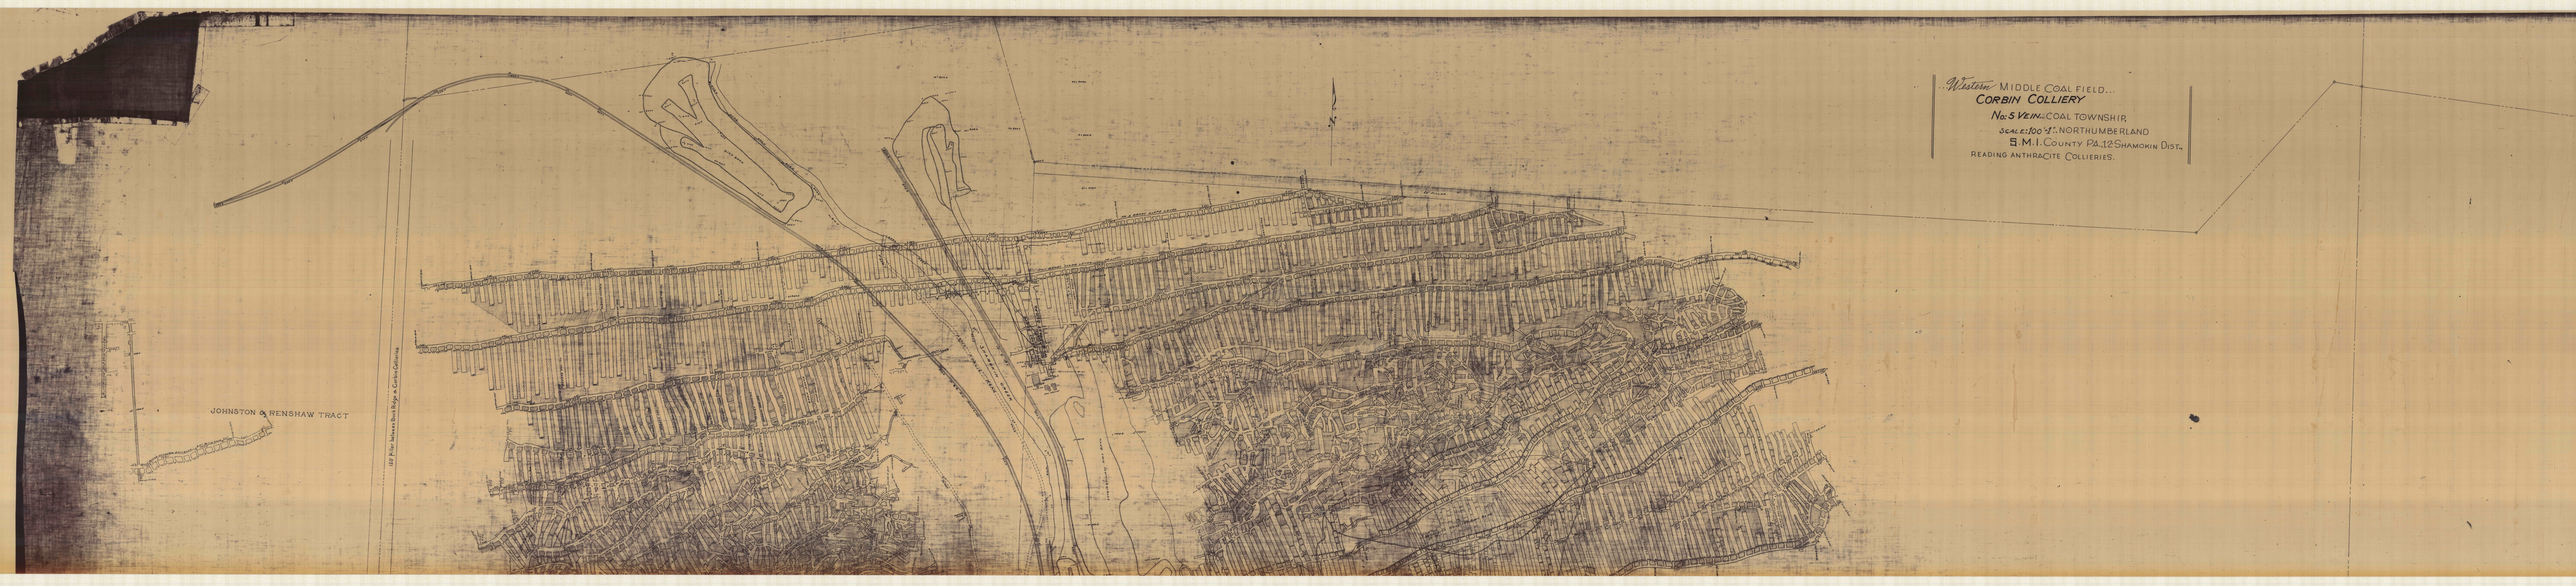
Western MIDDLE COAL FIELD...
CORBIN COLLIERY
No. 5 VEIN. COAL TOWNSHIP
SCALE: 100 FT. NORTHUMBERLAND
S. M. I. COUNTY PA. 12 SHAMOKIN DIST.
READING ANTHRACITE COLLIERIES.
JOHNSTON & RENSHAW TRACT