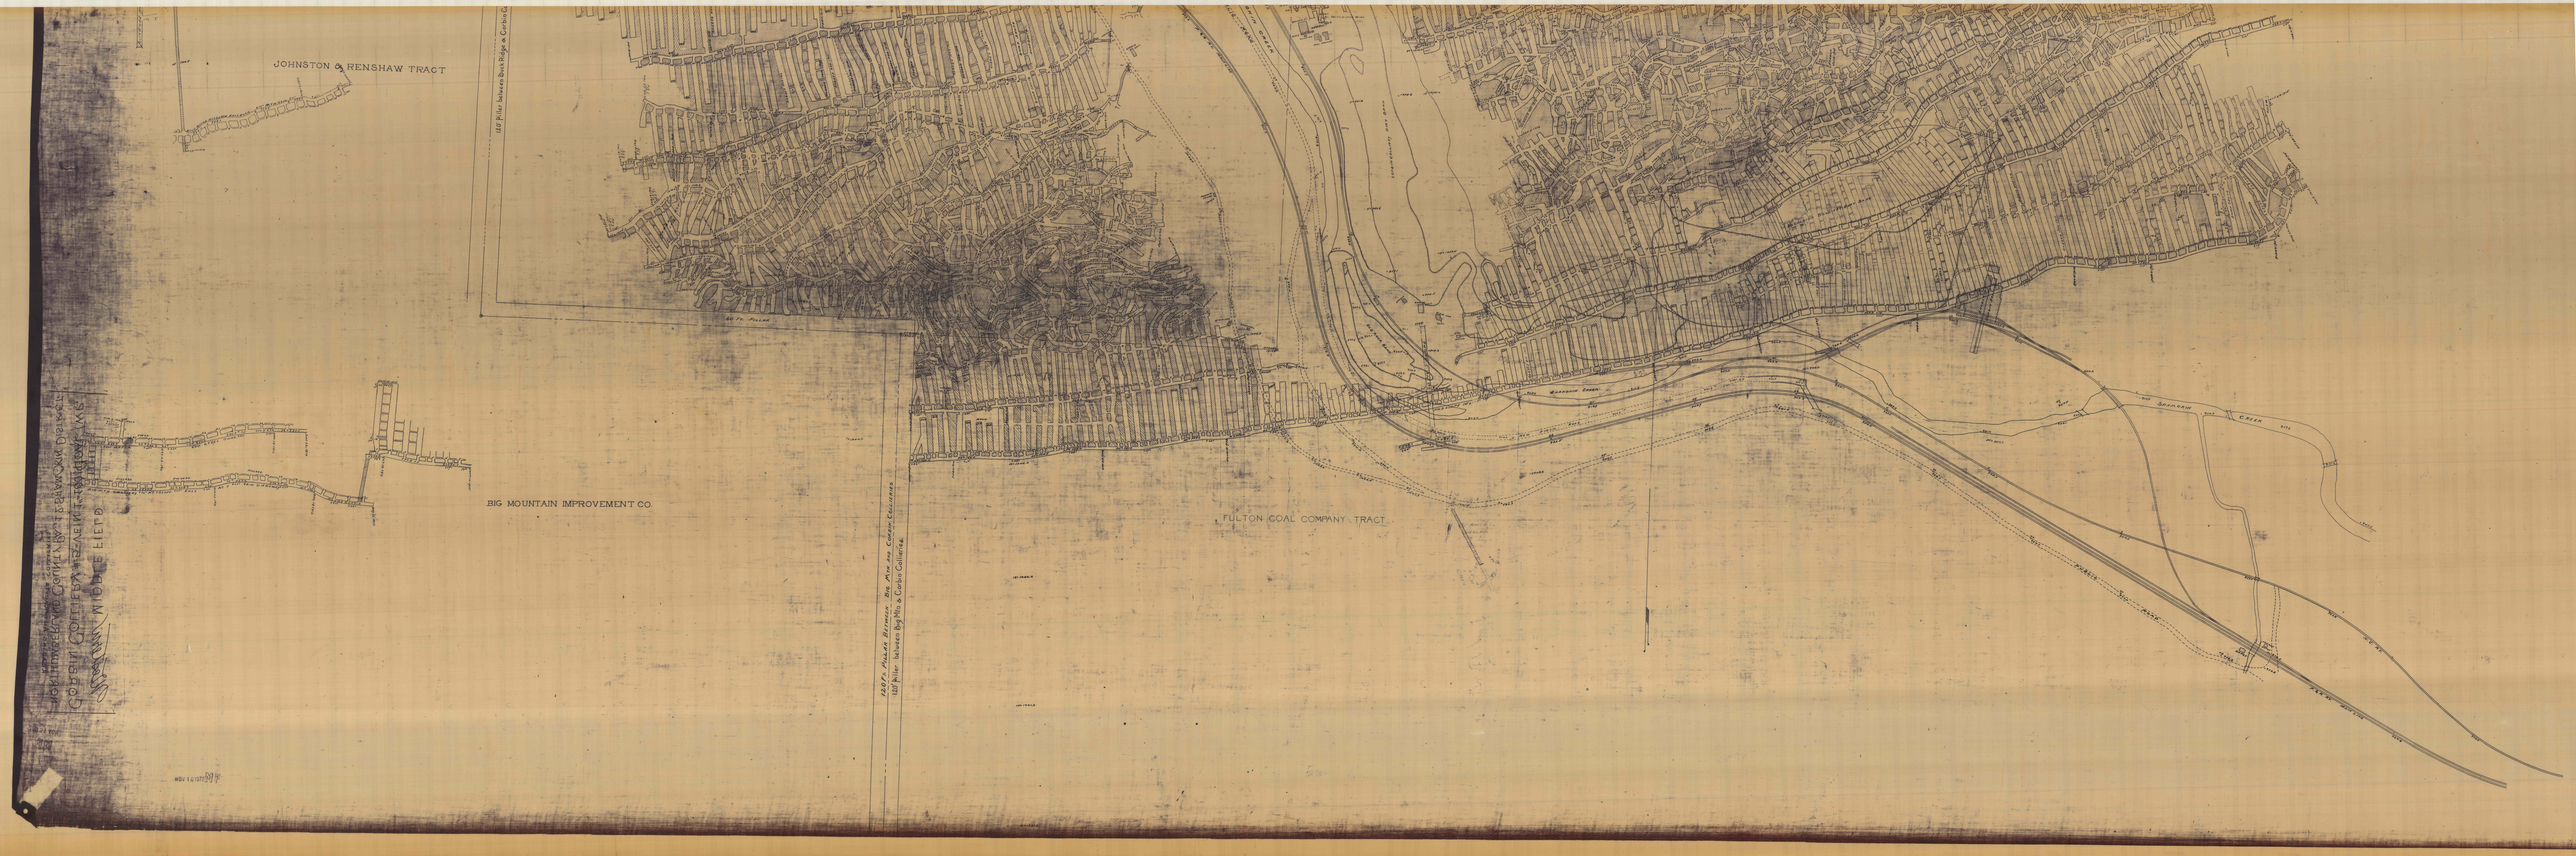
JOHNSTON & RENSHAW TRACT
BIG MOUNTAIN IMPROVEMENT CO.
FULTON COAL COMPANY TRACT
Mountain Creek
Renshaw Creek
Eagle