


F-1-82

LOCUST MTN. COAL & IRON CO

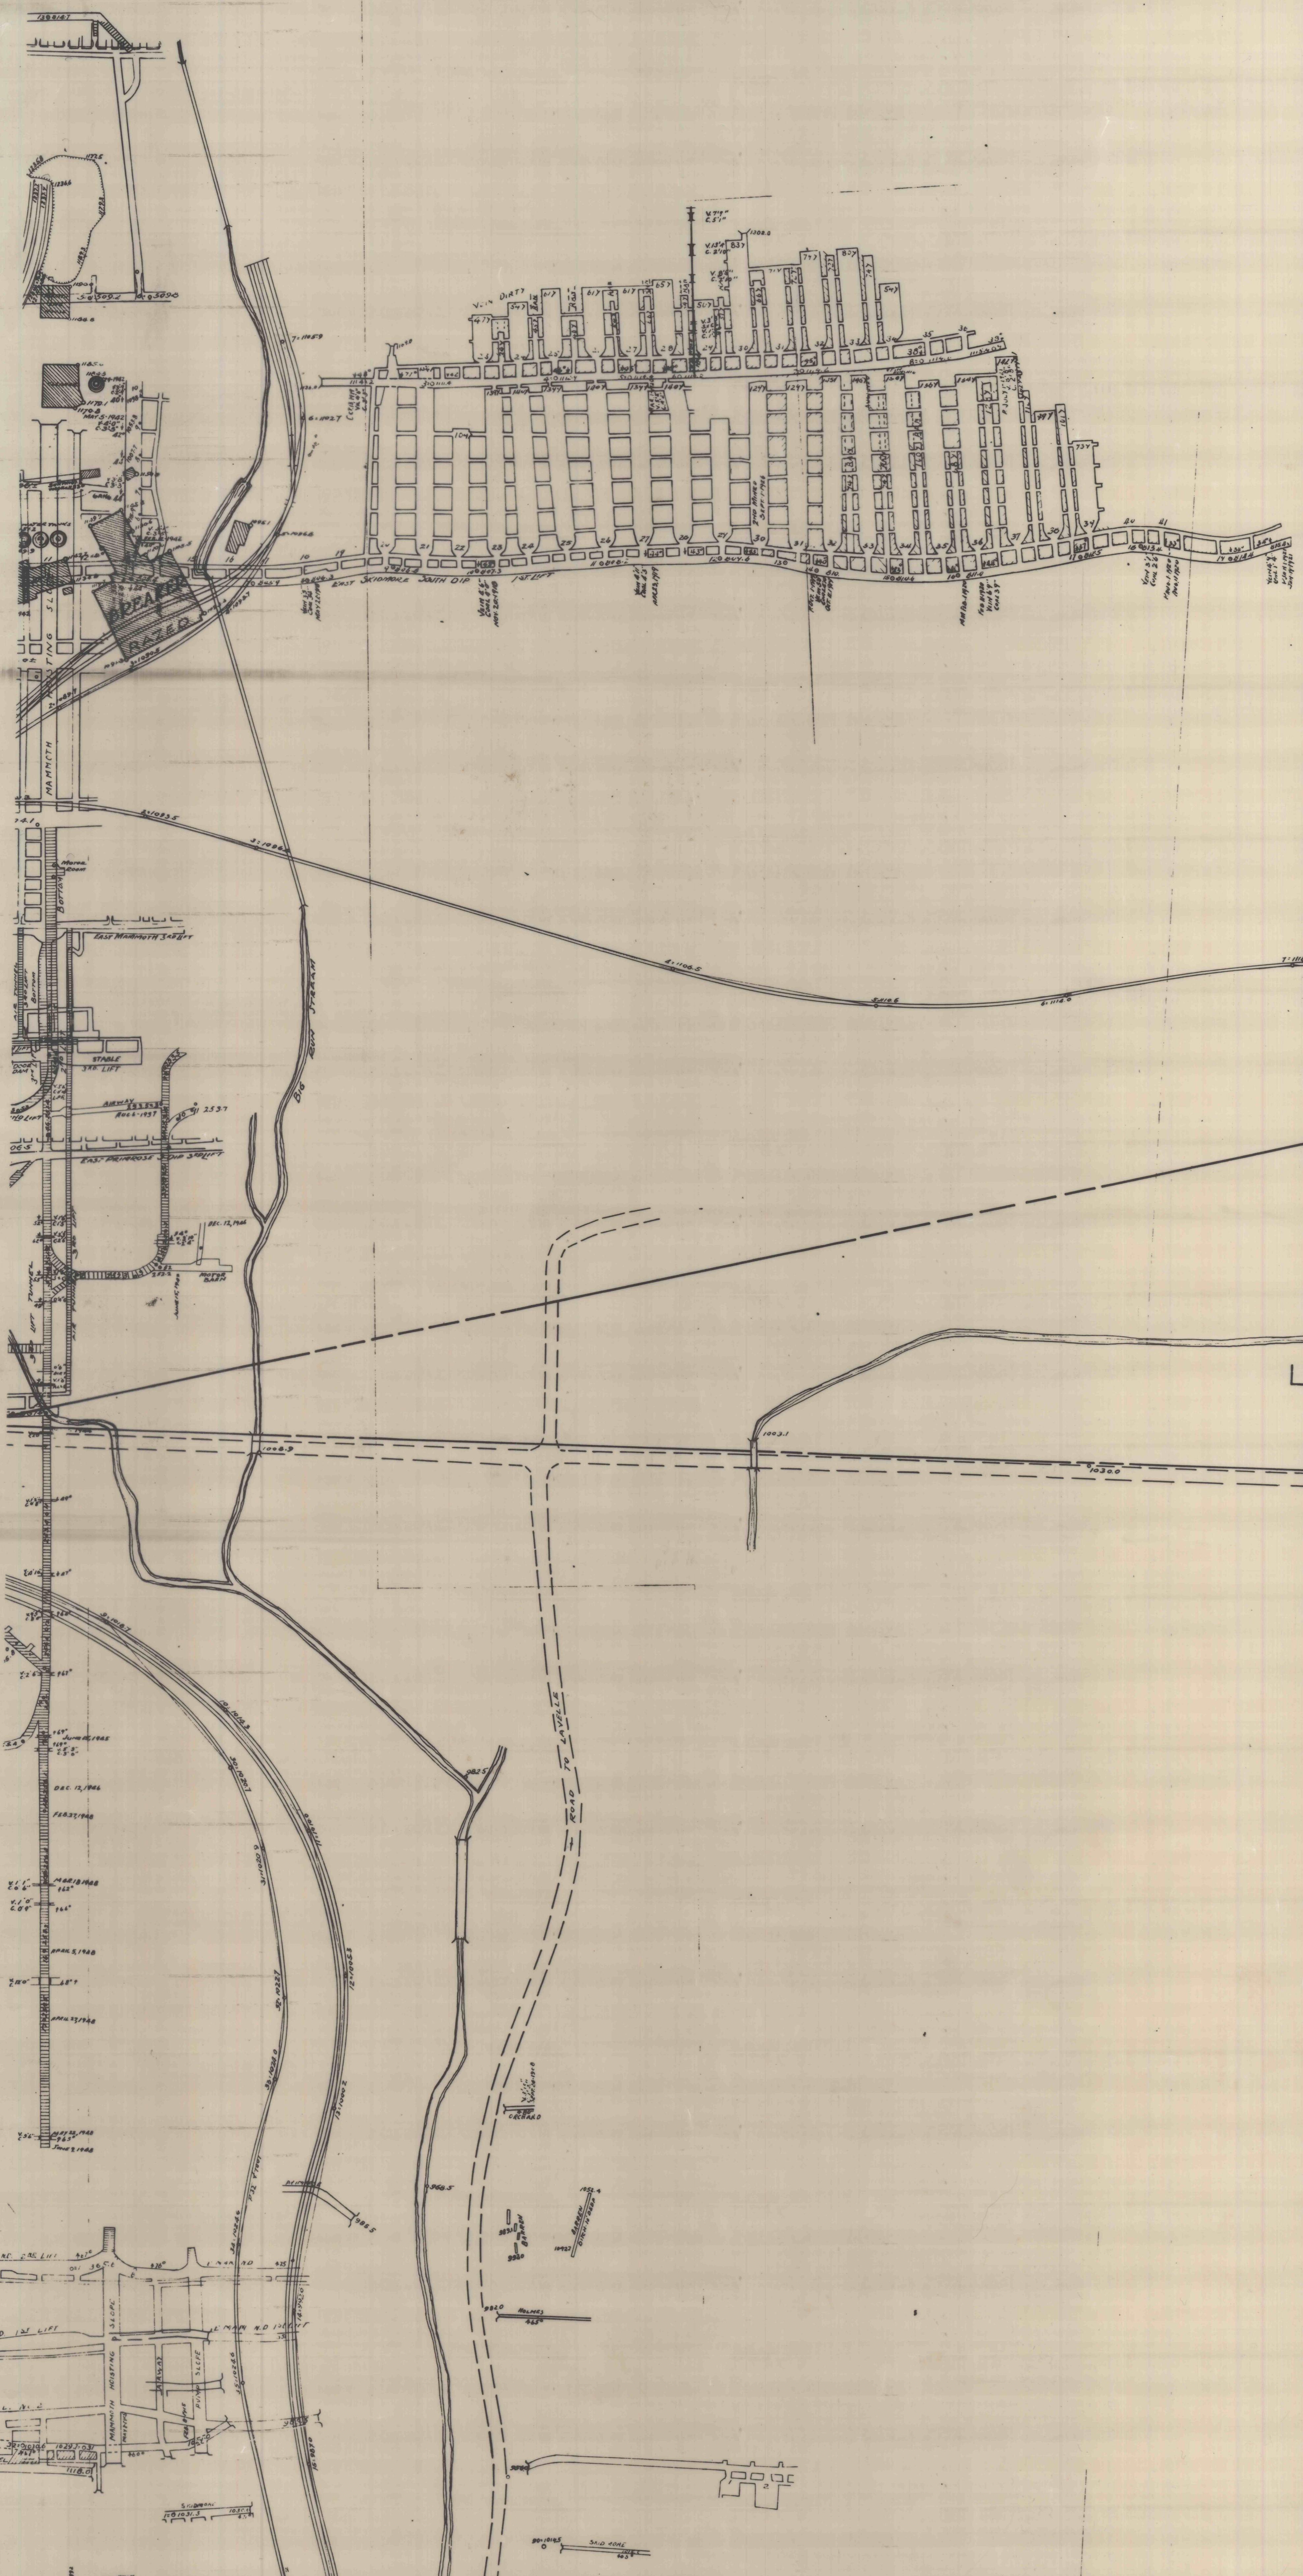

LOCUST DALE ESTATE

WASHINGTON PARK

ASHLAND ESTATE

