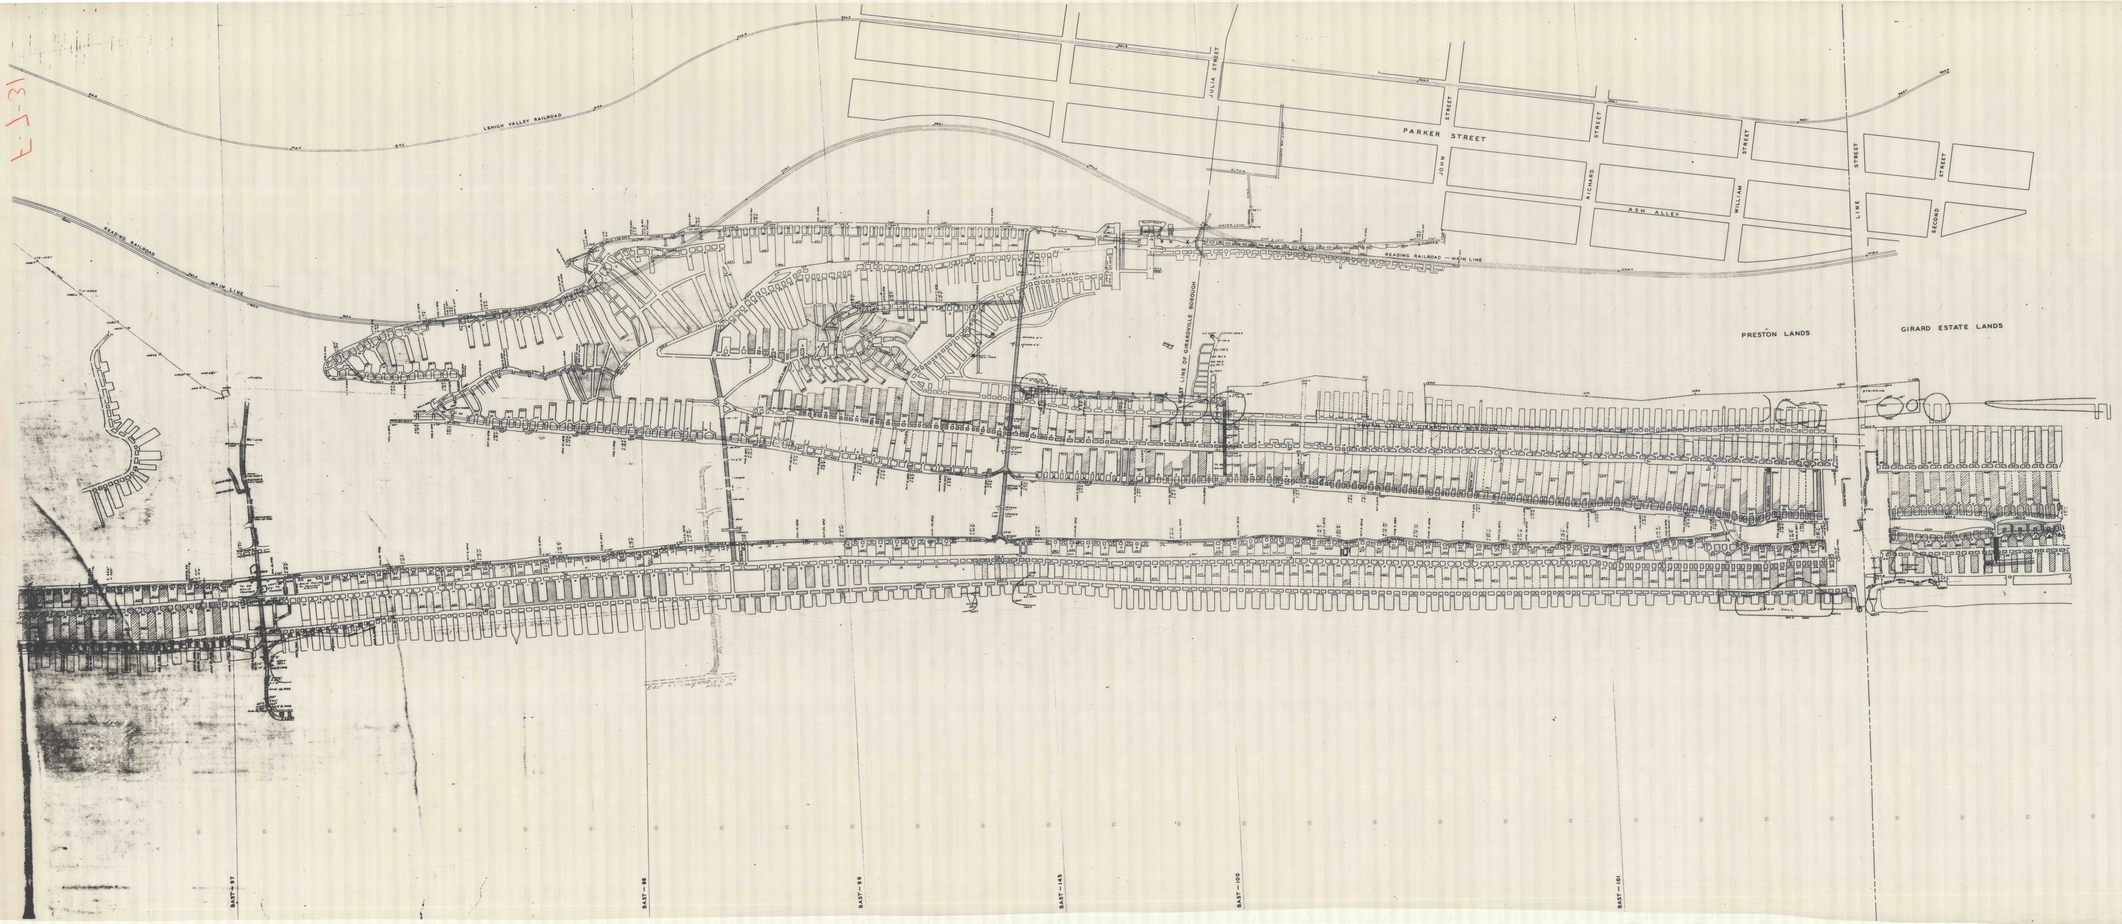

HUNTER TUNNEL

MAP OF MAMMOTH VEIN

SCALE 1"-100' ASHLAND, PA. JAN.-1946